


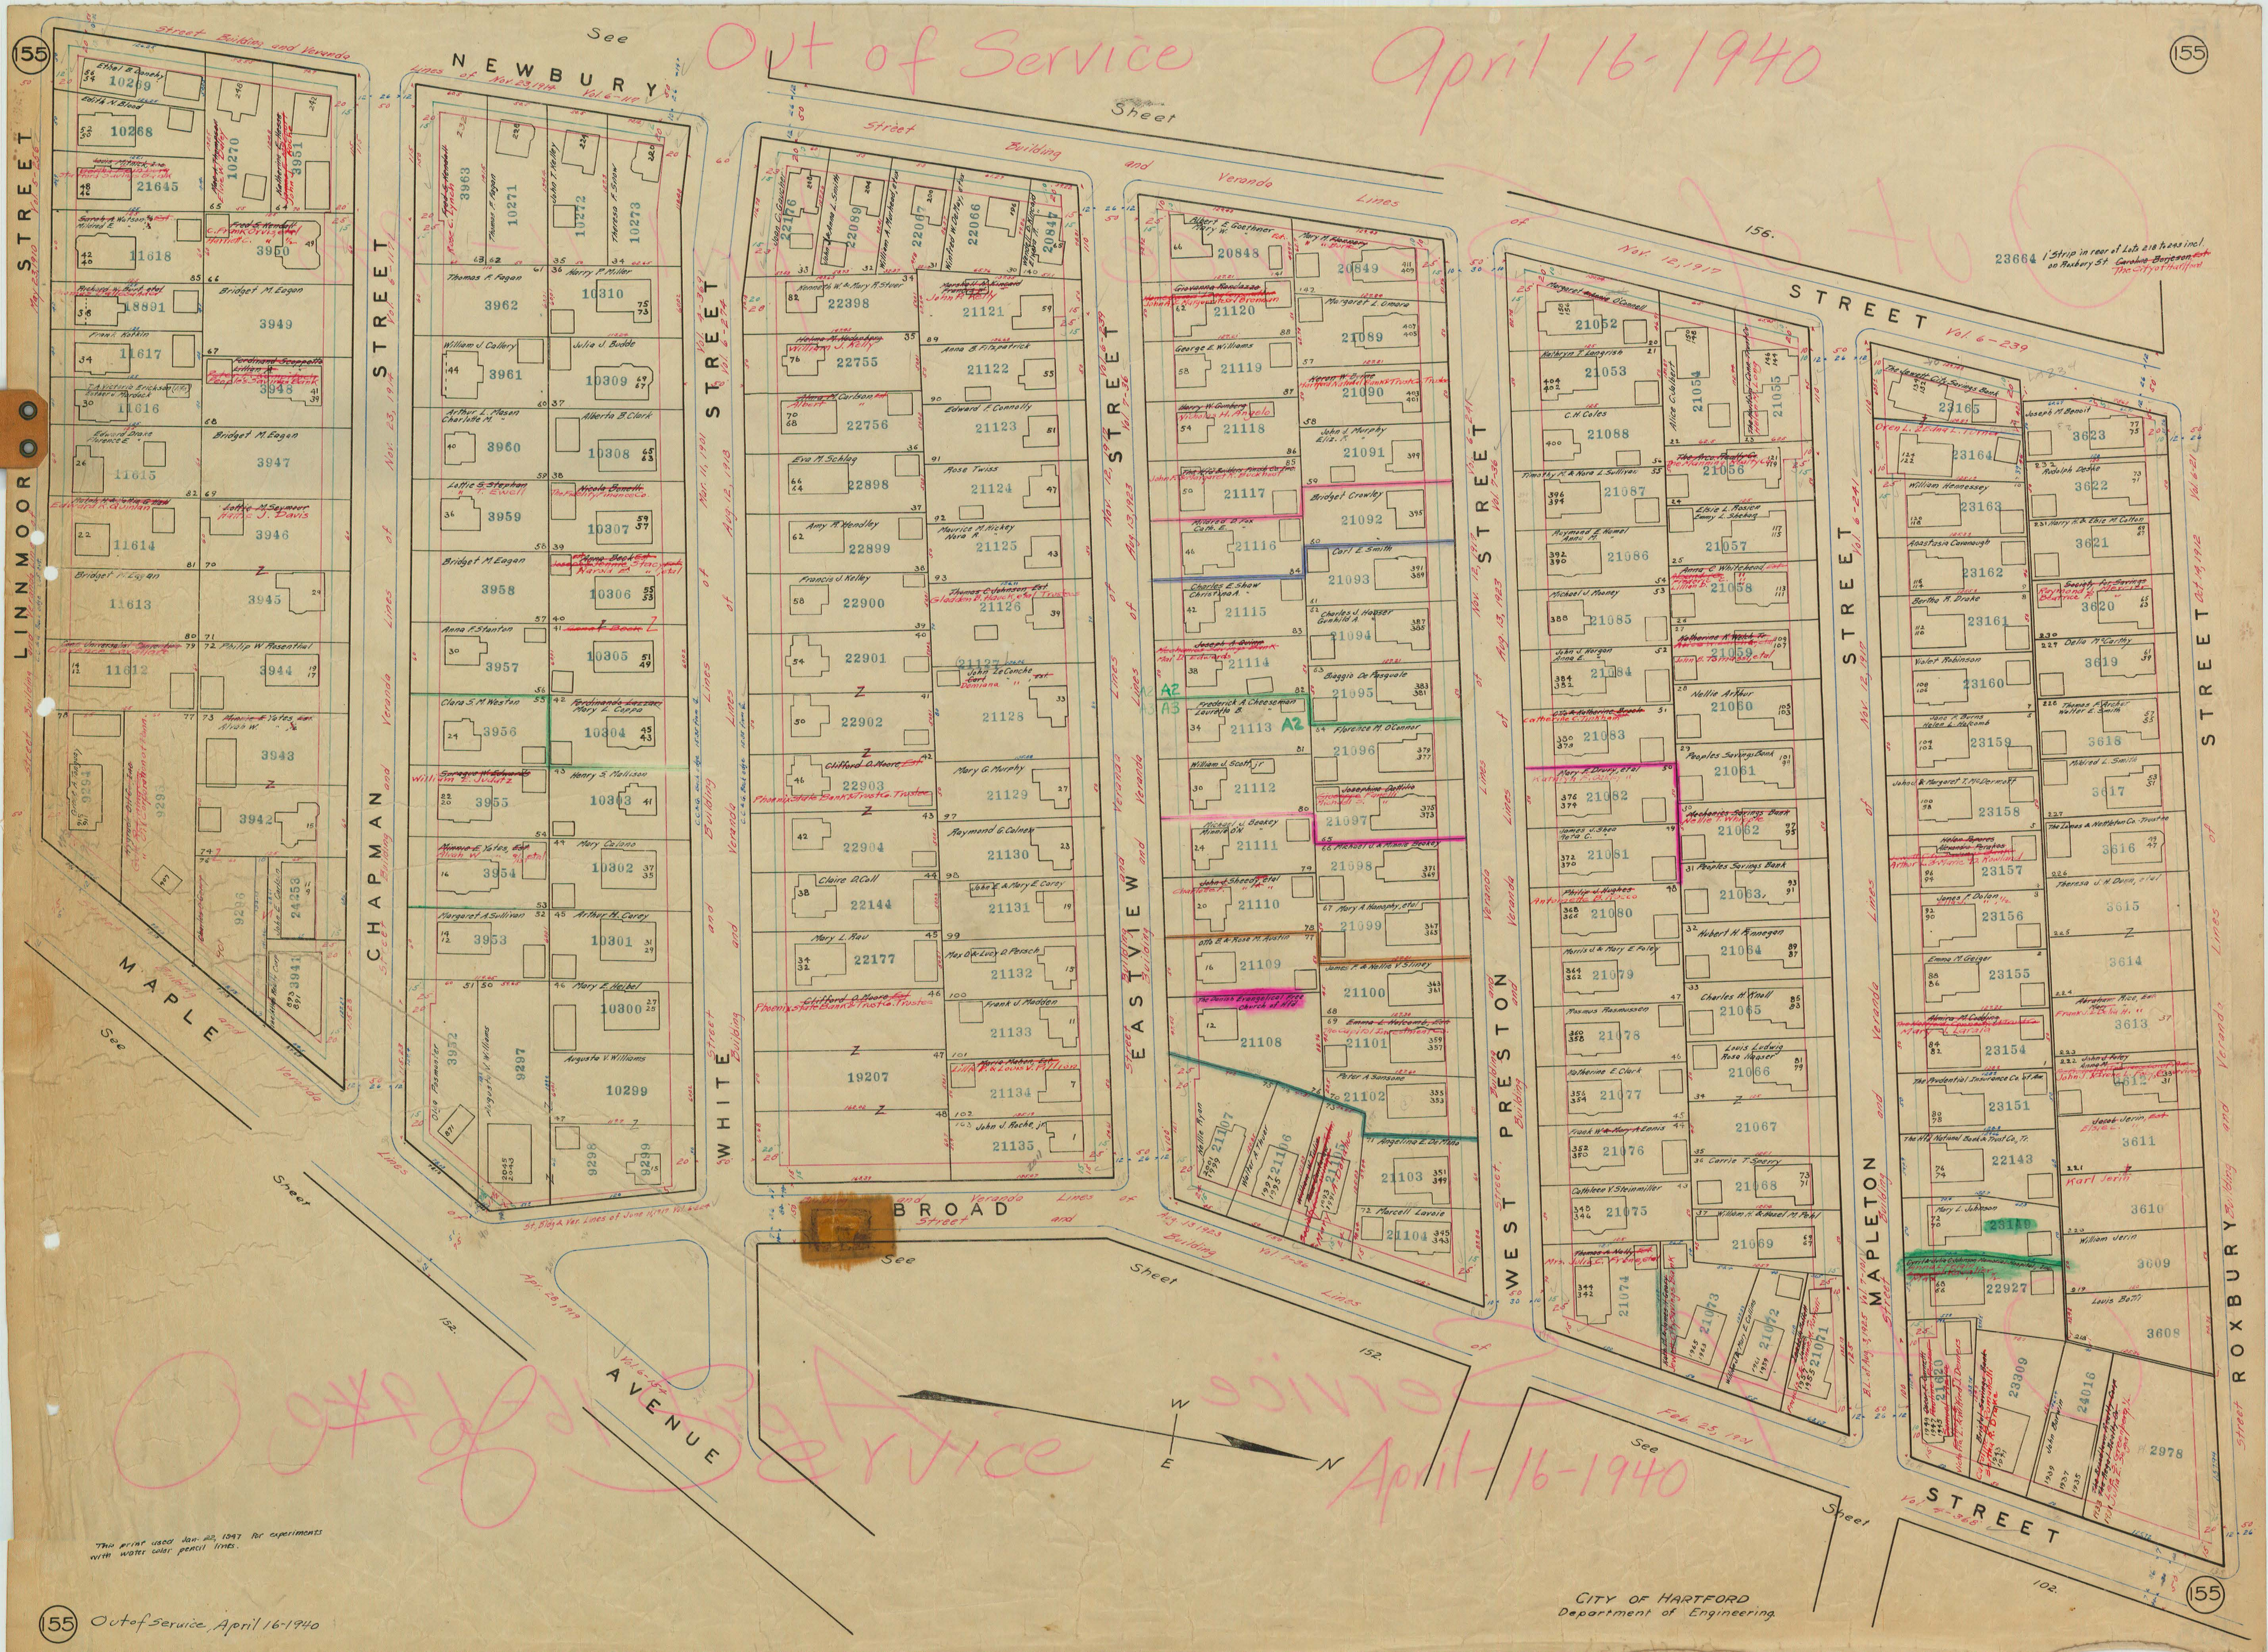

Out of Service

April 16-1940

WHITE STREET

EAST STREET

WEST STREET

MAPLETON STREET

This map used Jan. 22, 1947 for experiments with water color pencil lines.

Out of Service, April 16-1940

CITY OF HARTFORD
Department of Engineering