


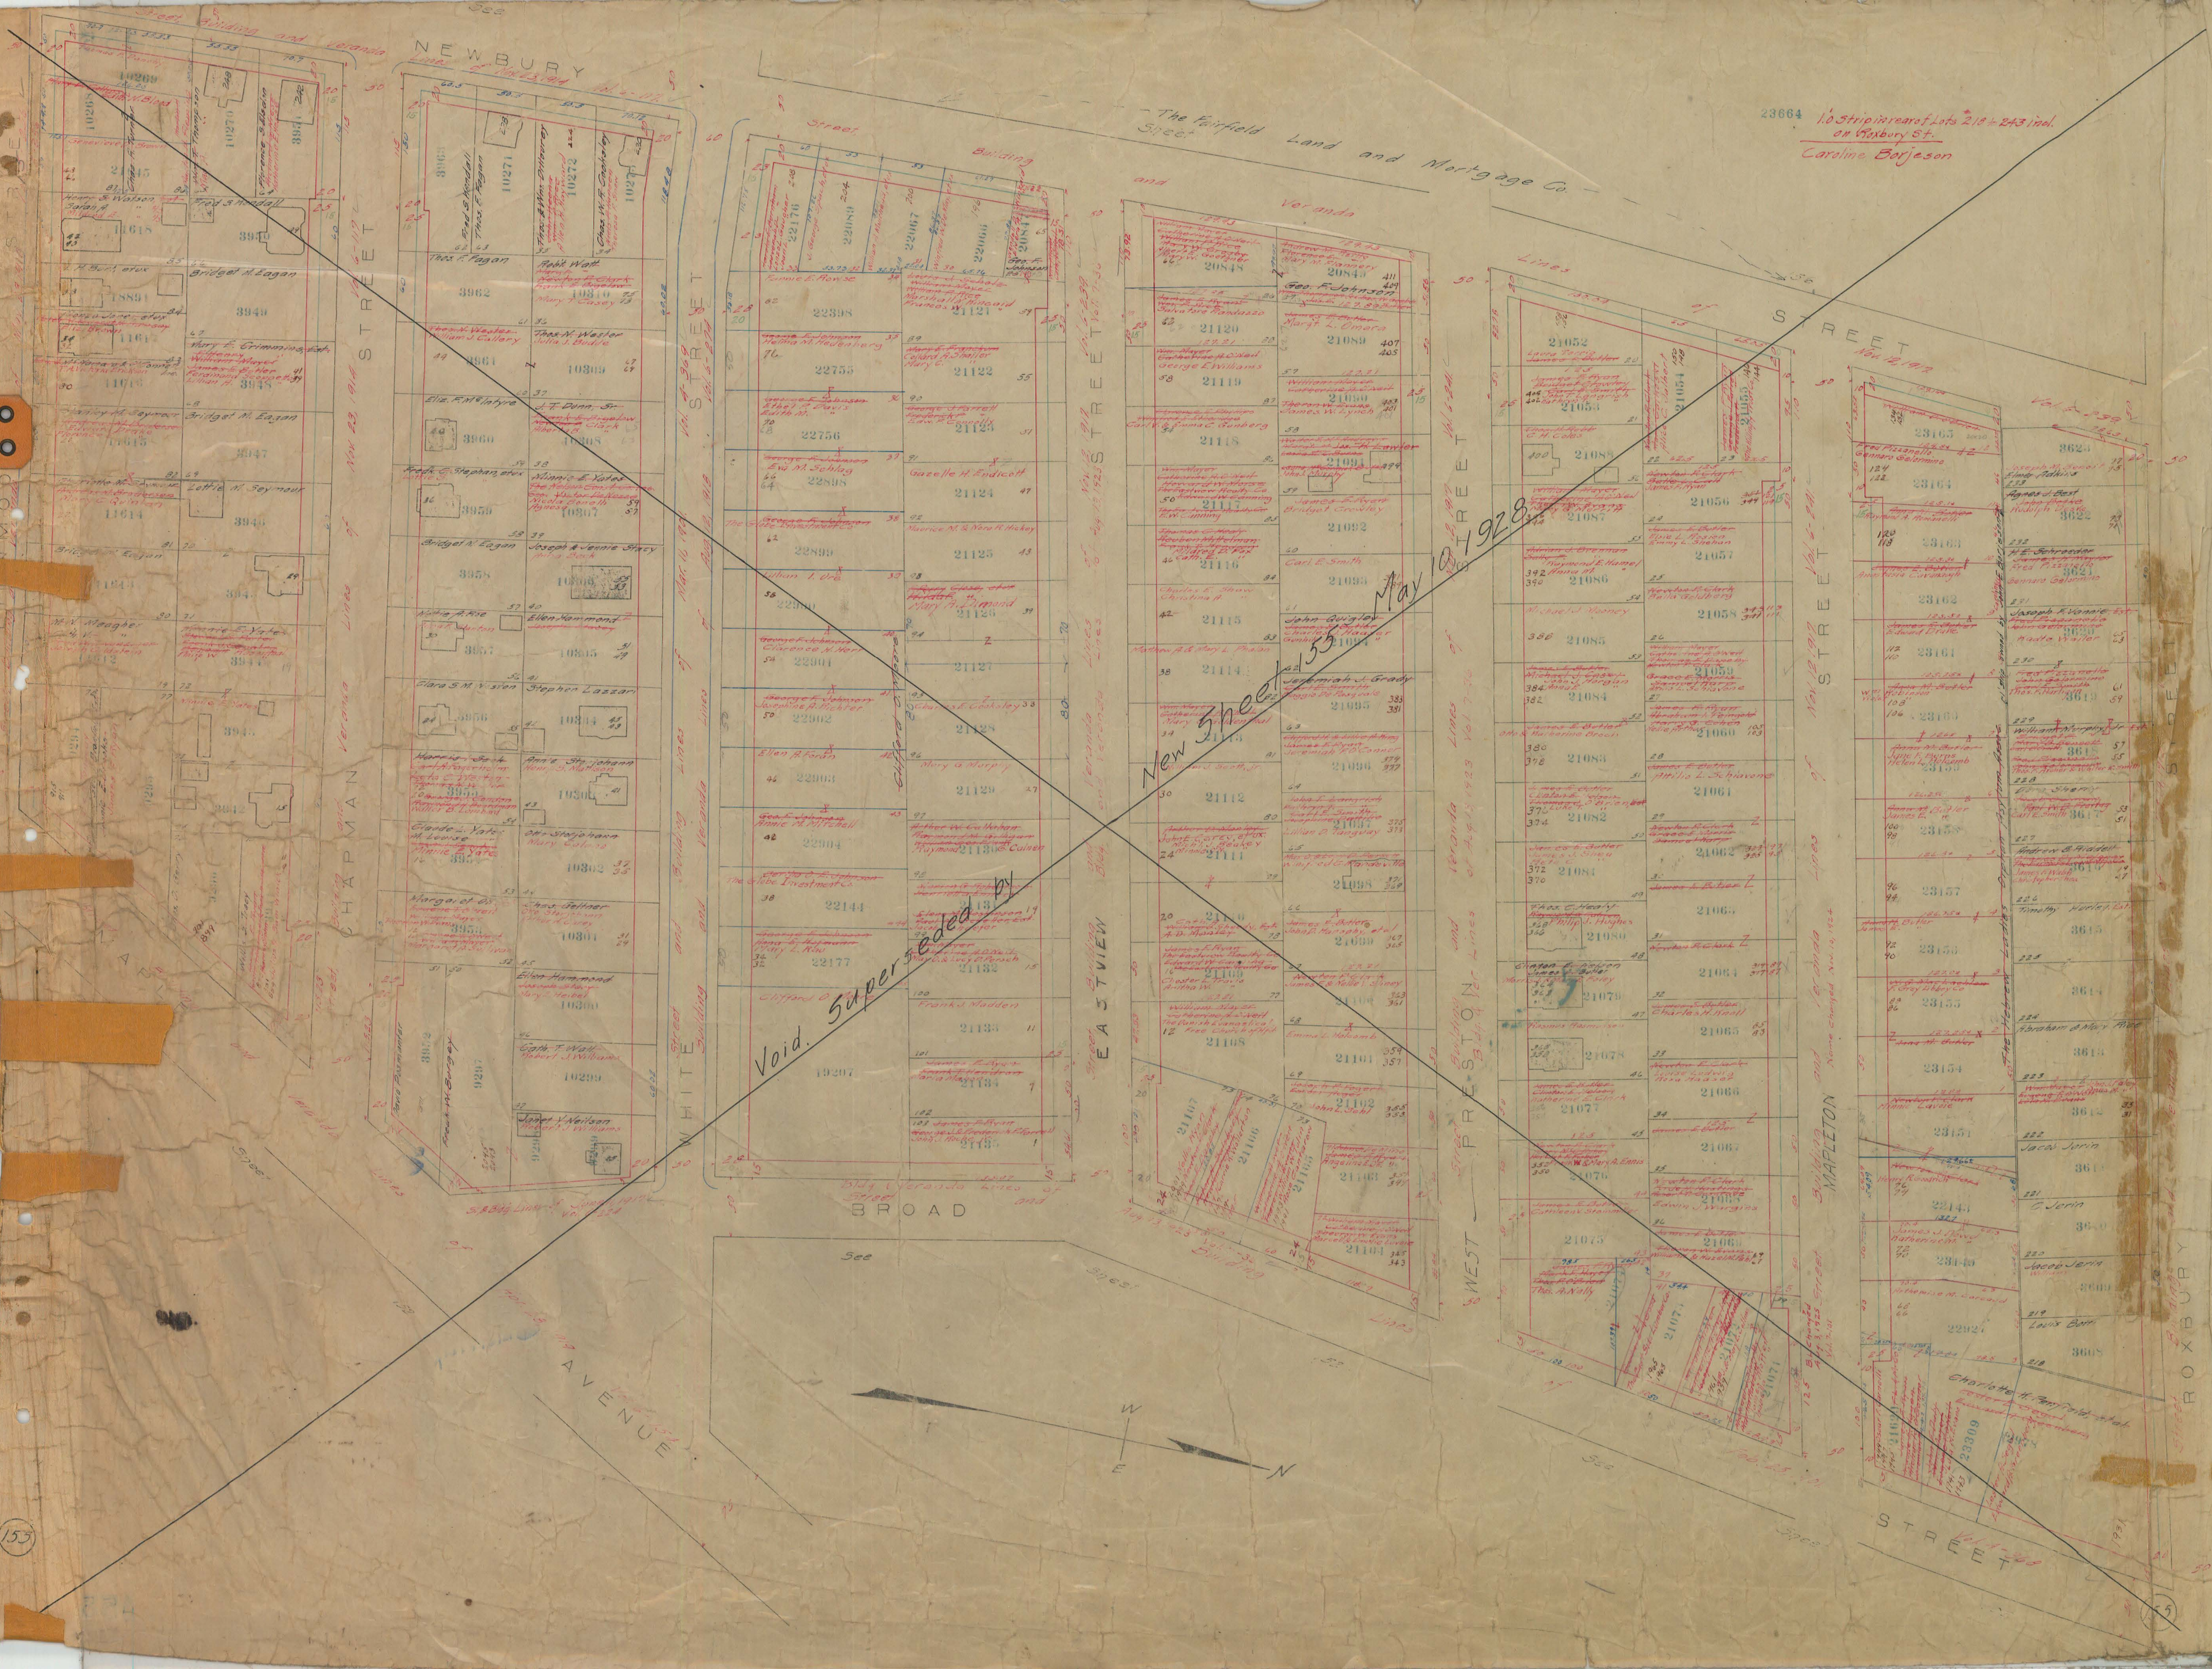

23664 1.0 Strip in rear of Lots 218 + 243 incl. on Newbury St. Caroline Barjeson

May 1928


Void. Superceded by

