


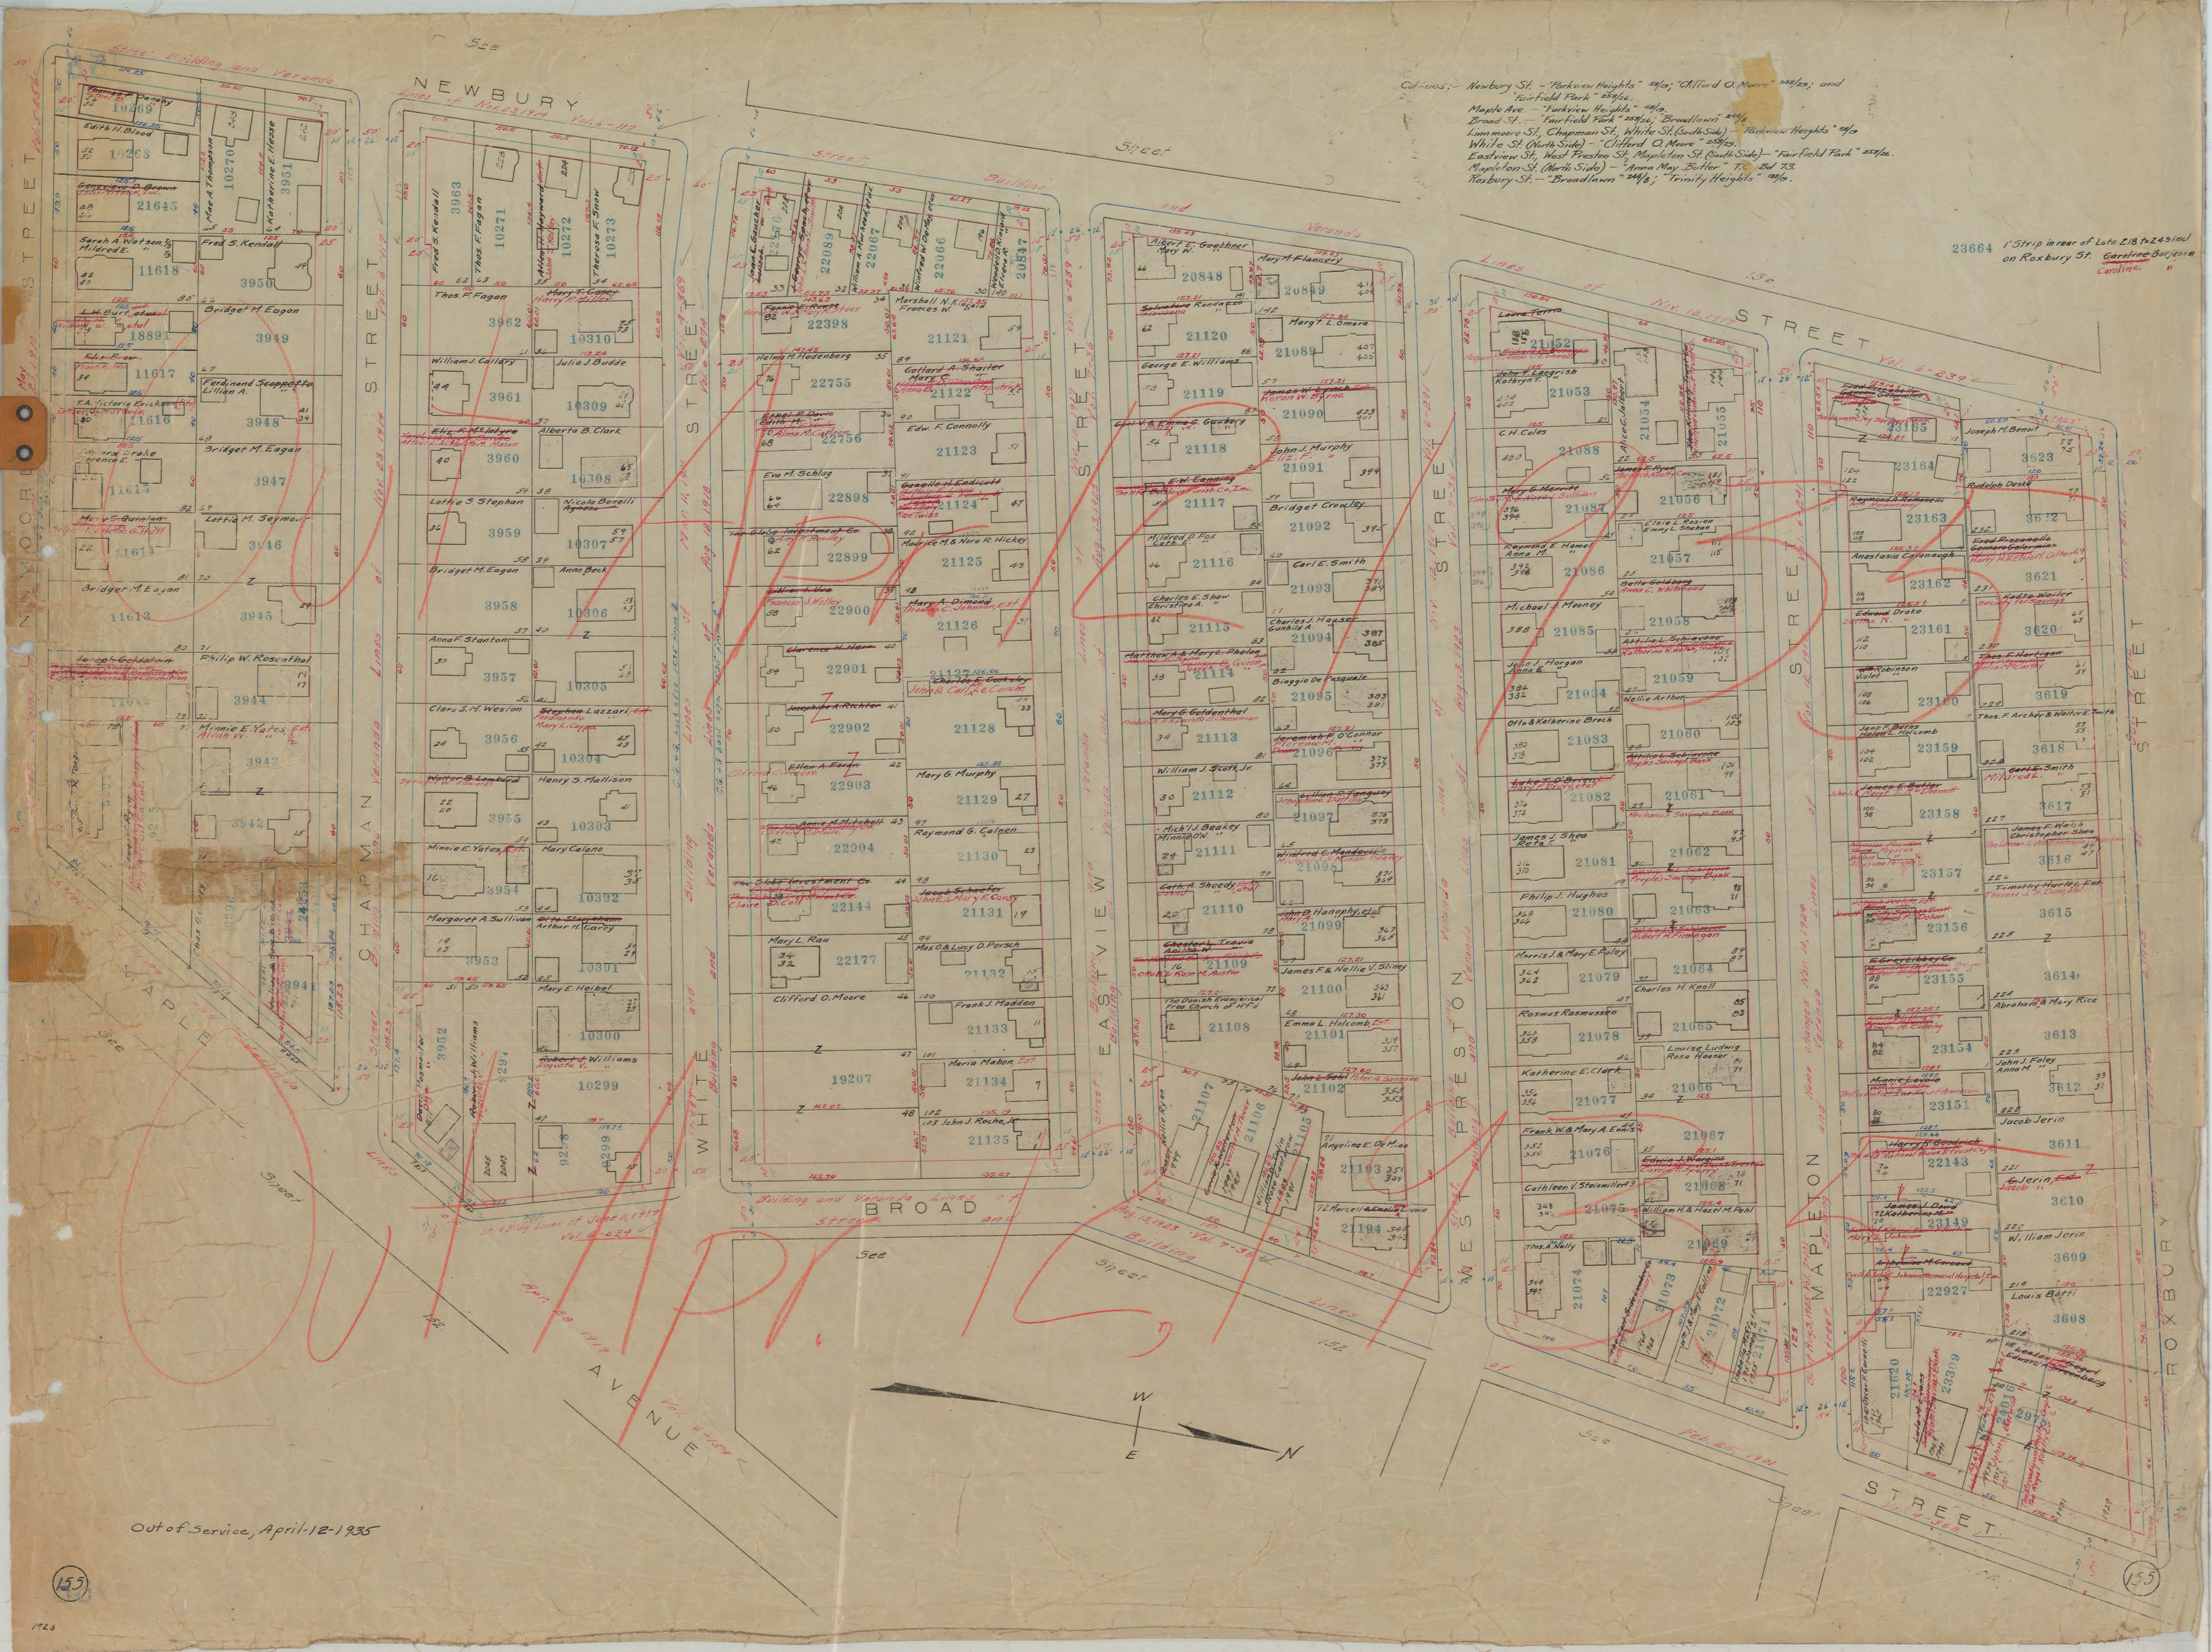


23664 1/2 Strip in rear of Lots 218 to 243 incl on Roxbury St. Caroline Borjesson

Out of Service, April 12-1935


