


Alta N. Robert
Sarah E. Melendez

File: 3534
Joseph DiBattista
Nancy " (c.s.)

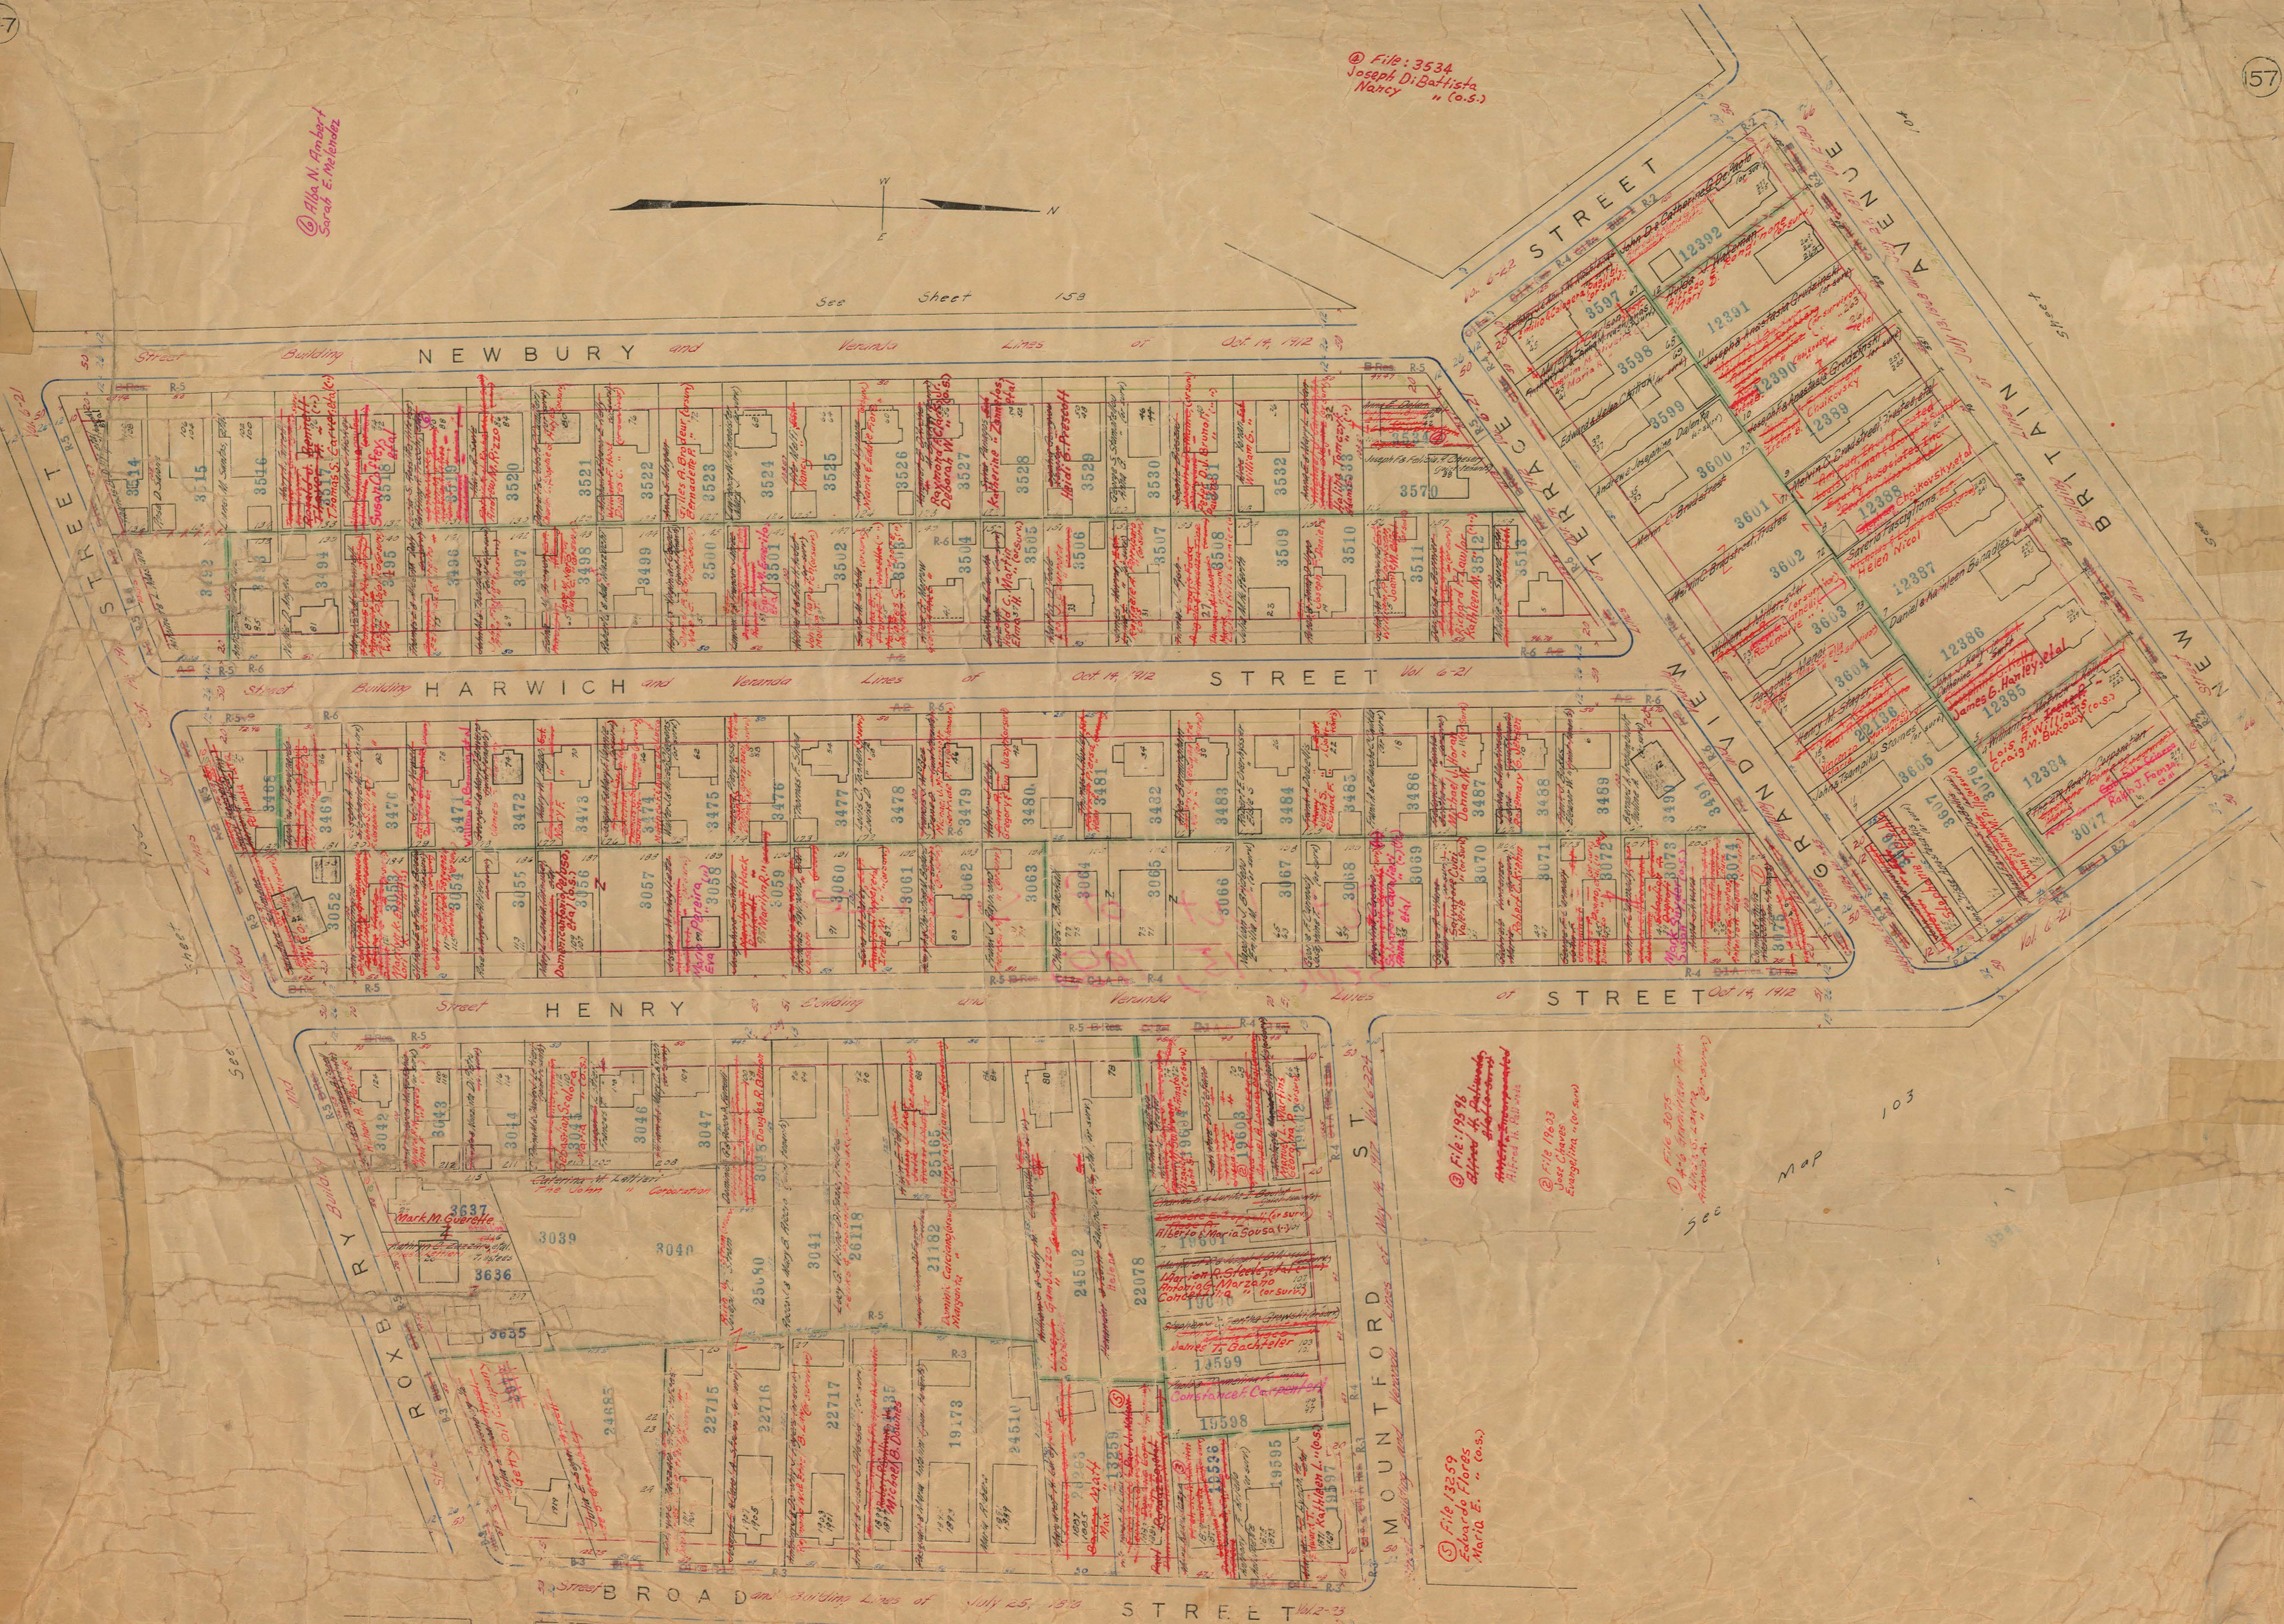

File: 19596
Alfred H. Bicknell
Helen M. Bicknell

File: 19593
Josef Charles
Elizabeth " (c.s.)

File: 3075

File: 3259
Edw. Flores
Maria E. " (c.s.)

Map 103