


~~ROCKY RIDGE PARK~~
Thomas J. Hyland Memorial

ZION STREET

~~ROCKY RIDGE PARK~~
Thomas J. Hyland Memorial

AVENUE
Street Lines of June 12, 1939
Vol. 7-336

~~ROCKY RIDGE PARK~~
Thomas J. Hyland Memorial

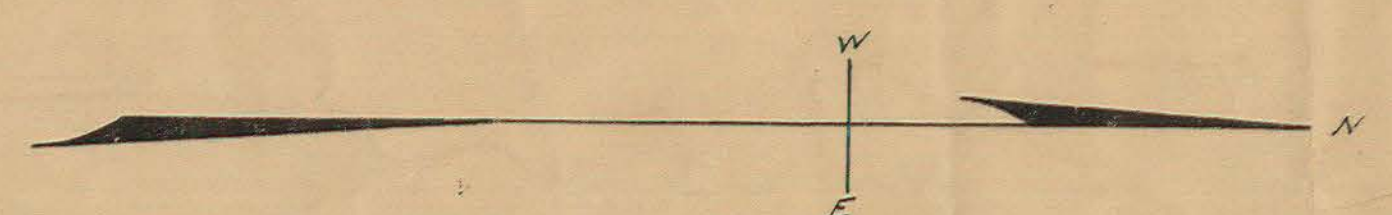

FAIRFIELD Building and Veranda Lines of

FAIRFIELD PARK

AVENUE
See C.C. Journal June 12, 1911, p. 184
Vol. 4-359

BRITAIN AVENUE

SUMMIT ST.

GRANDVIEW Building and Veranda Lines of

TERRACE

CITY OF HARTFORD
FIRE DEPT.
10966

NEWBURY Building and Veranda Lines of Oct. 14, 1912

CITY OF HARTFORD
Department of Engineering

ROXBURY

See Sheet 157

Out of Service Oct. 26, 1972