
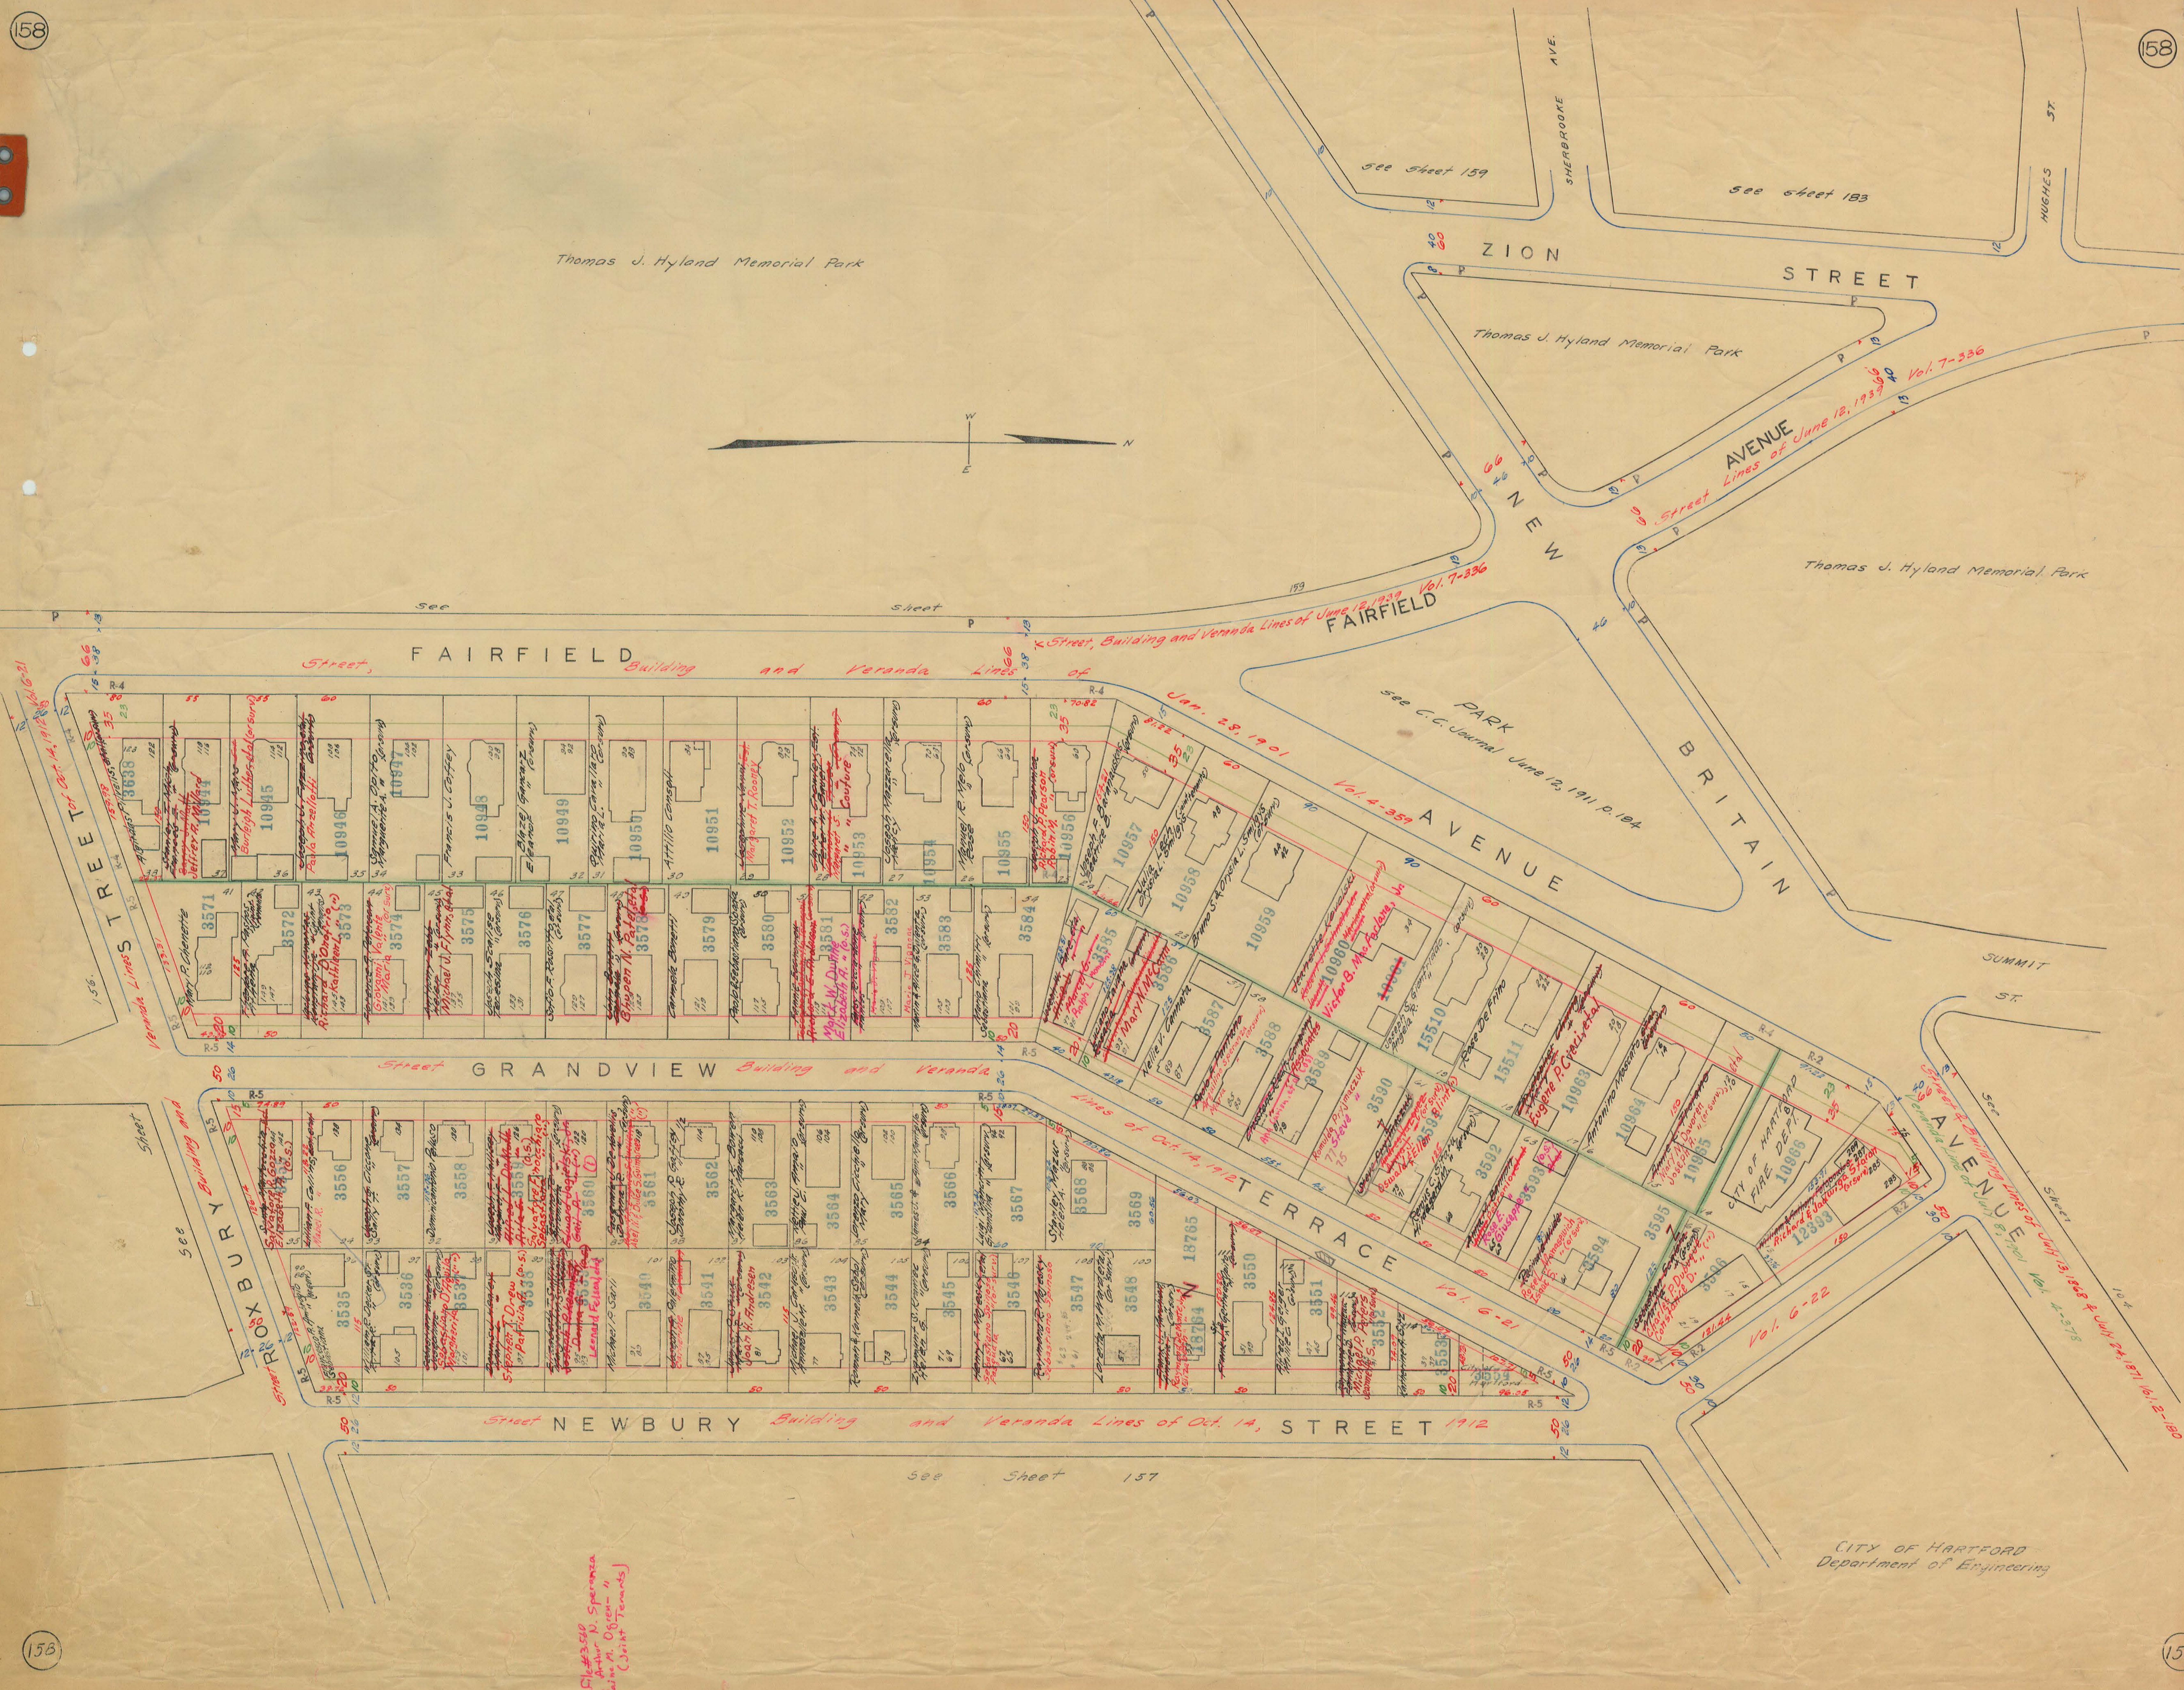


Thomas J. Hyland Memorial Park

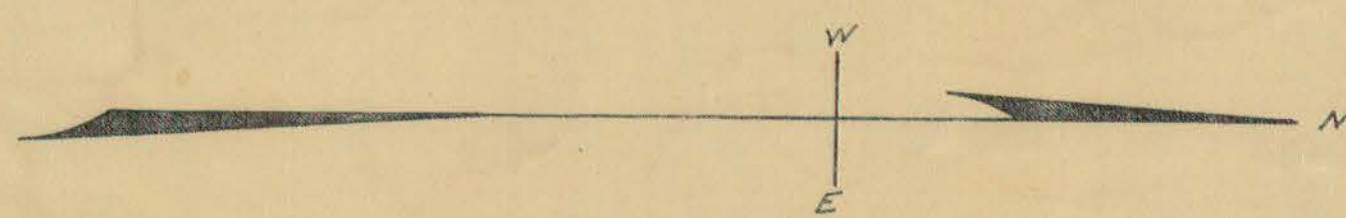

CITY OF HARTFORD
Department of Engineering