



Out of Service, April 21-1938

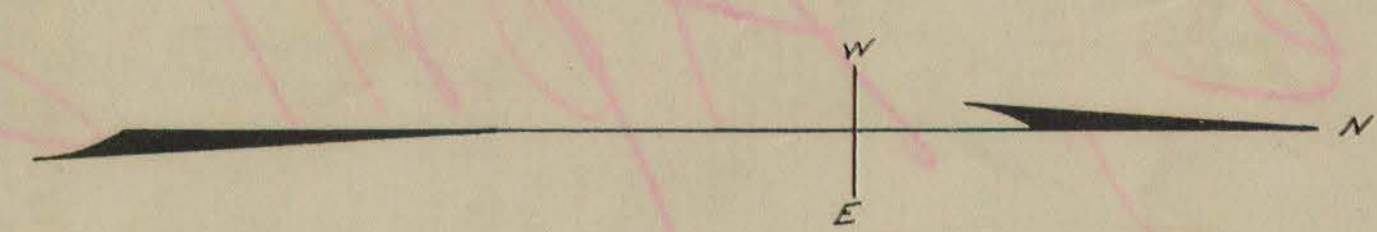

See sheet 159

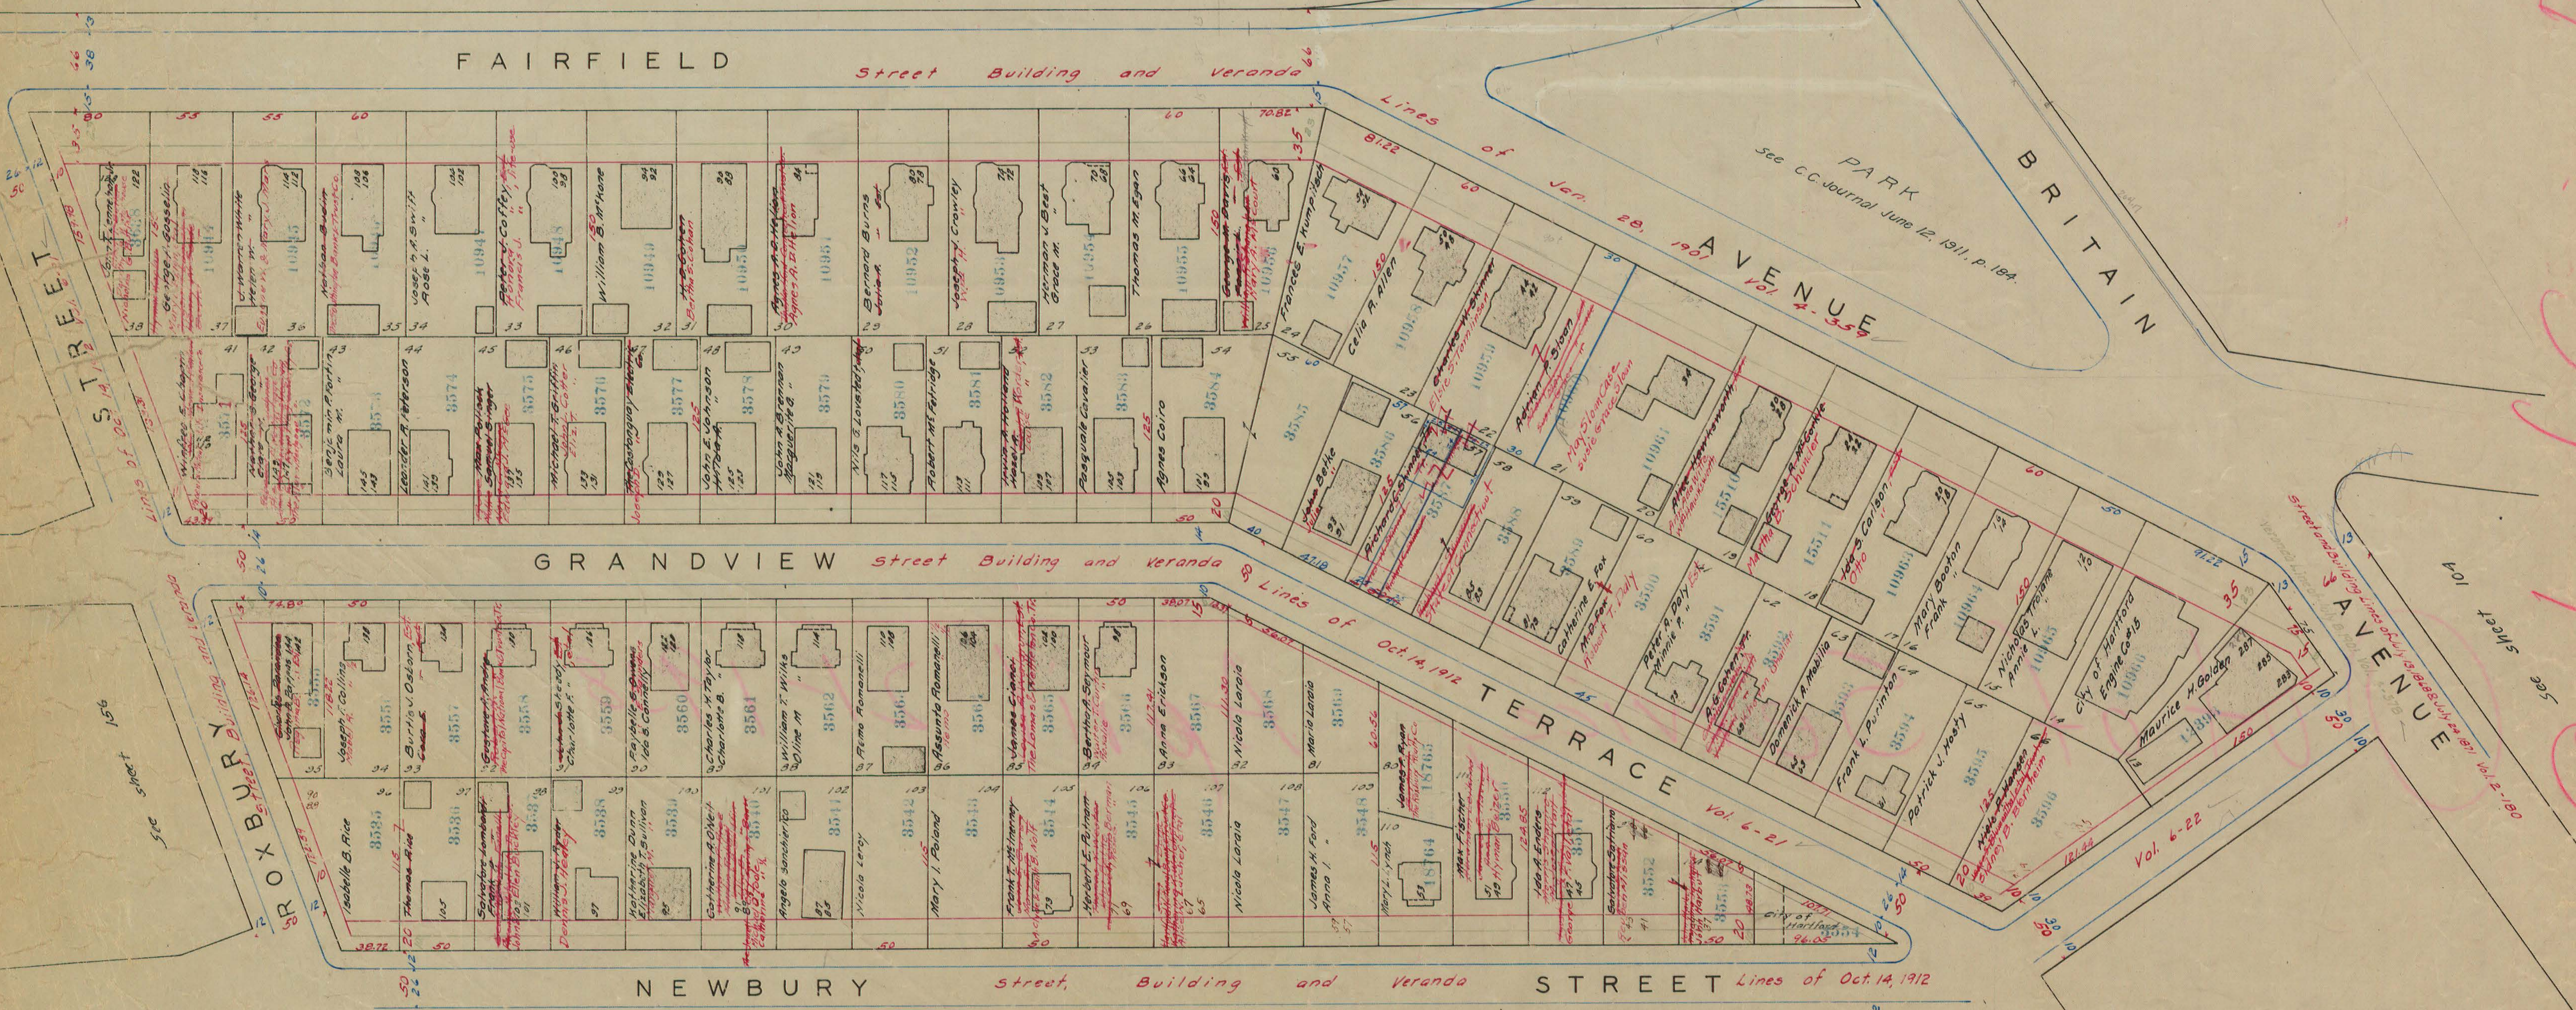

Out of Service, April 21-1938

Out of Service, April 21-1938

Out of Service, April 21-1938