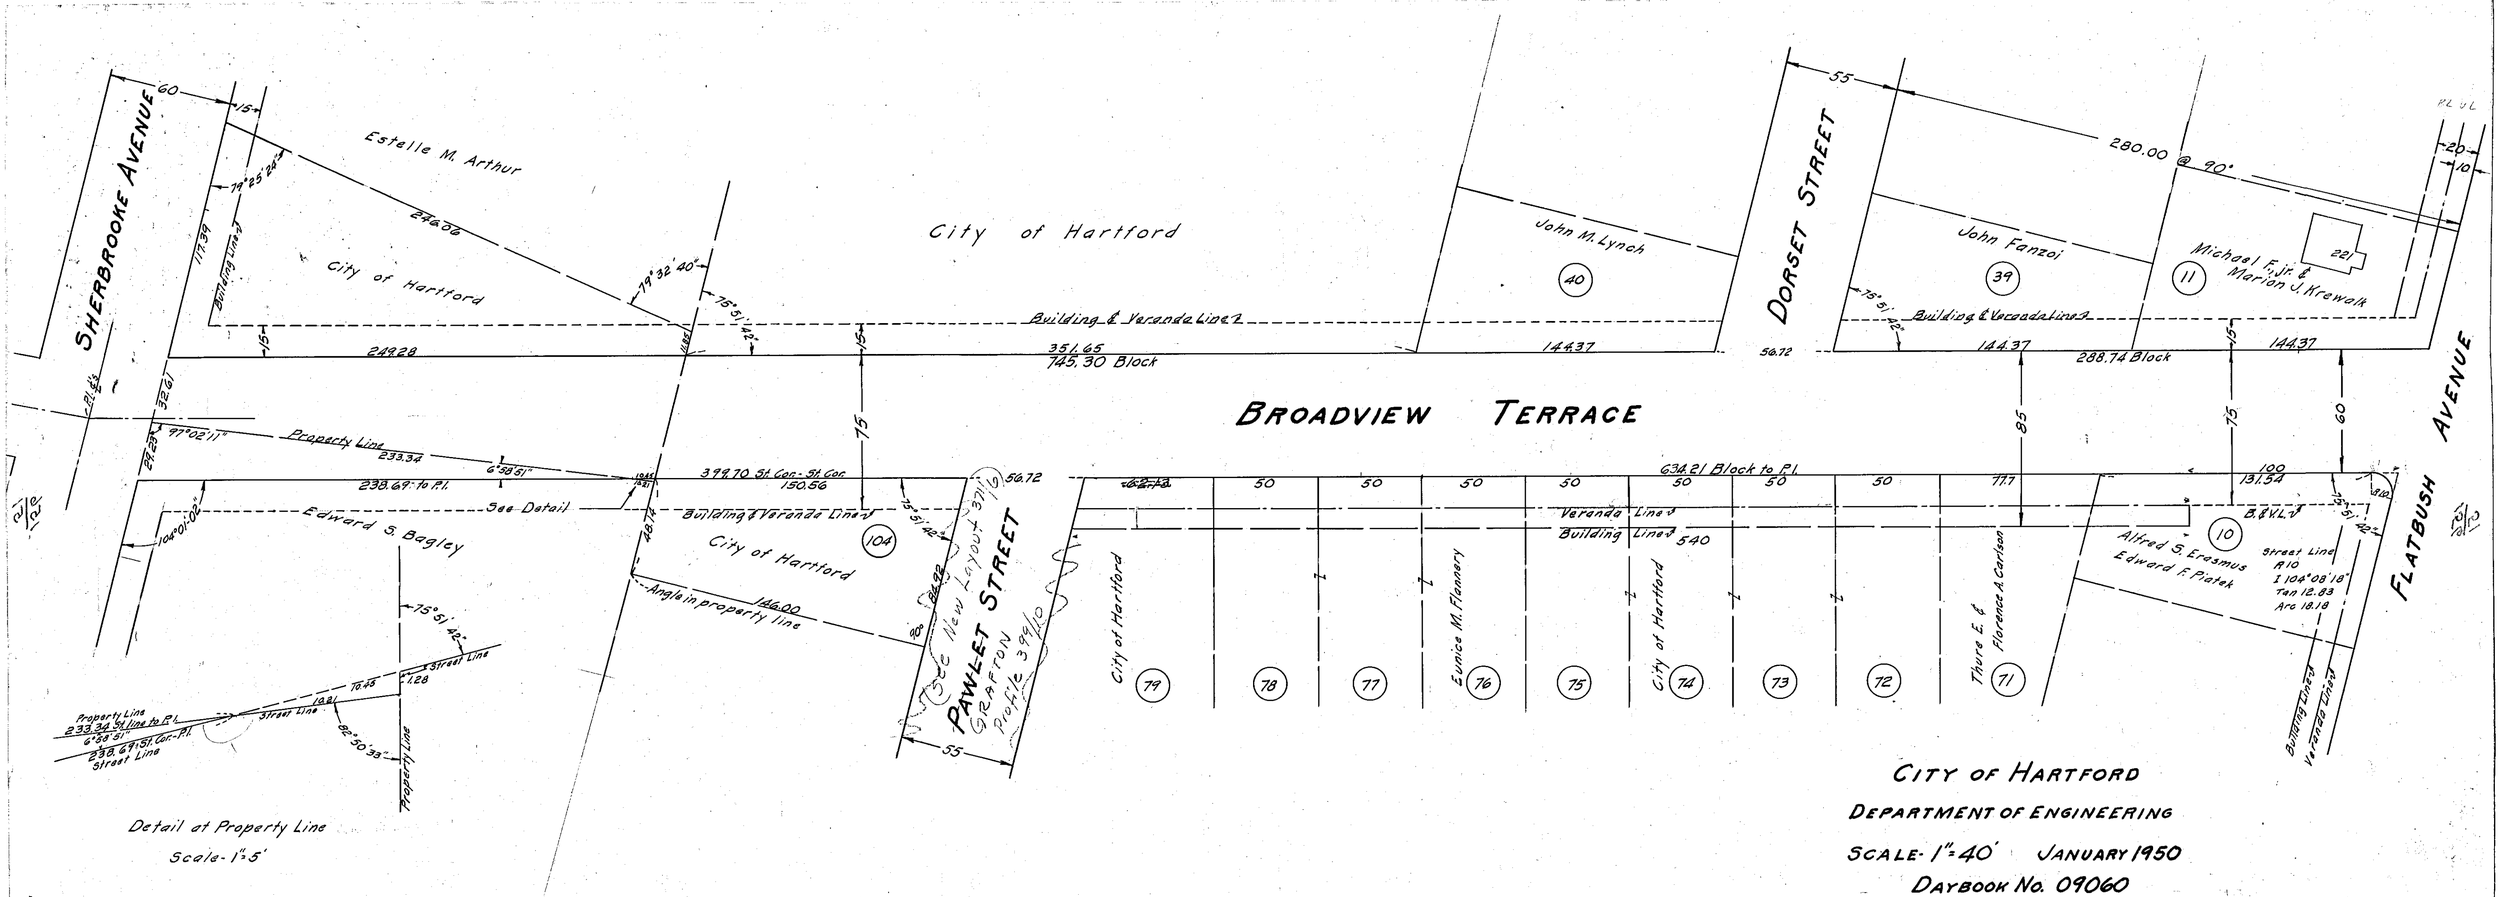

CITY OF HARTFORD

DEPARTMENT OF ENGINEERING

SCALE-1"=40' JANUARY 1950

DAYBOOK No. 09060