


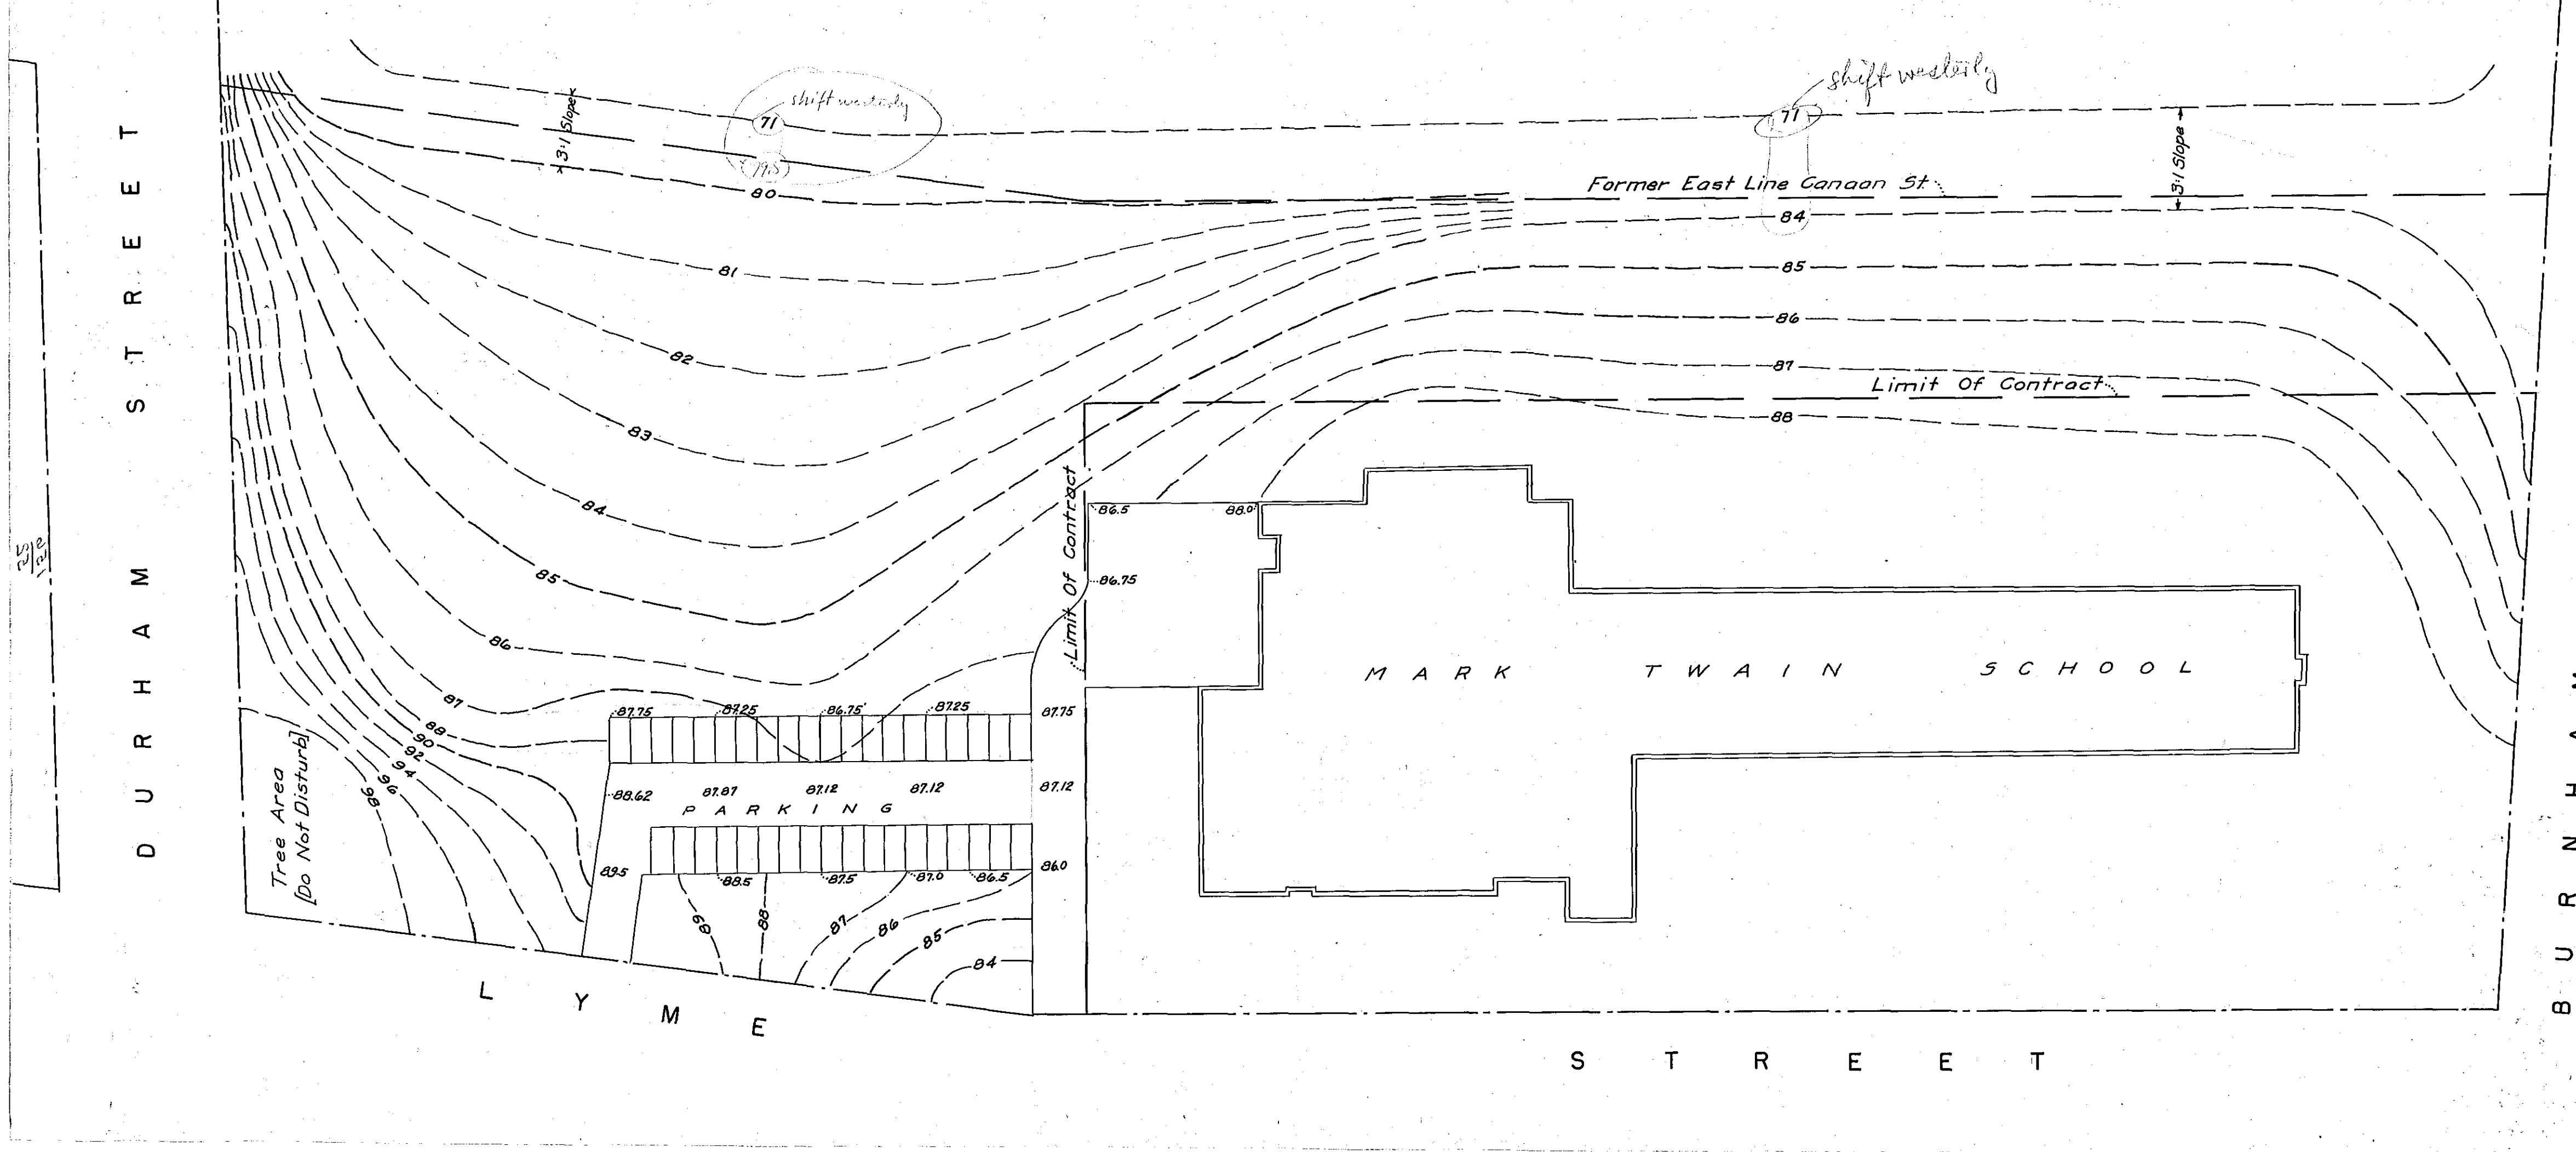

CITY OF HARTFORD
DEPARTMENT OF ENGINEERING

SCALE 1" = 40' FEB. 1952

DAYBOOK NO. 09181