


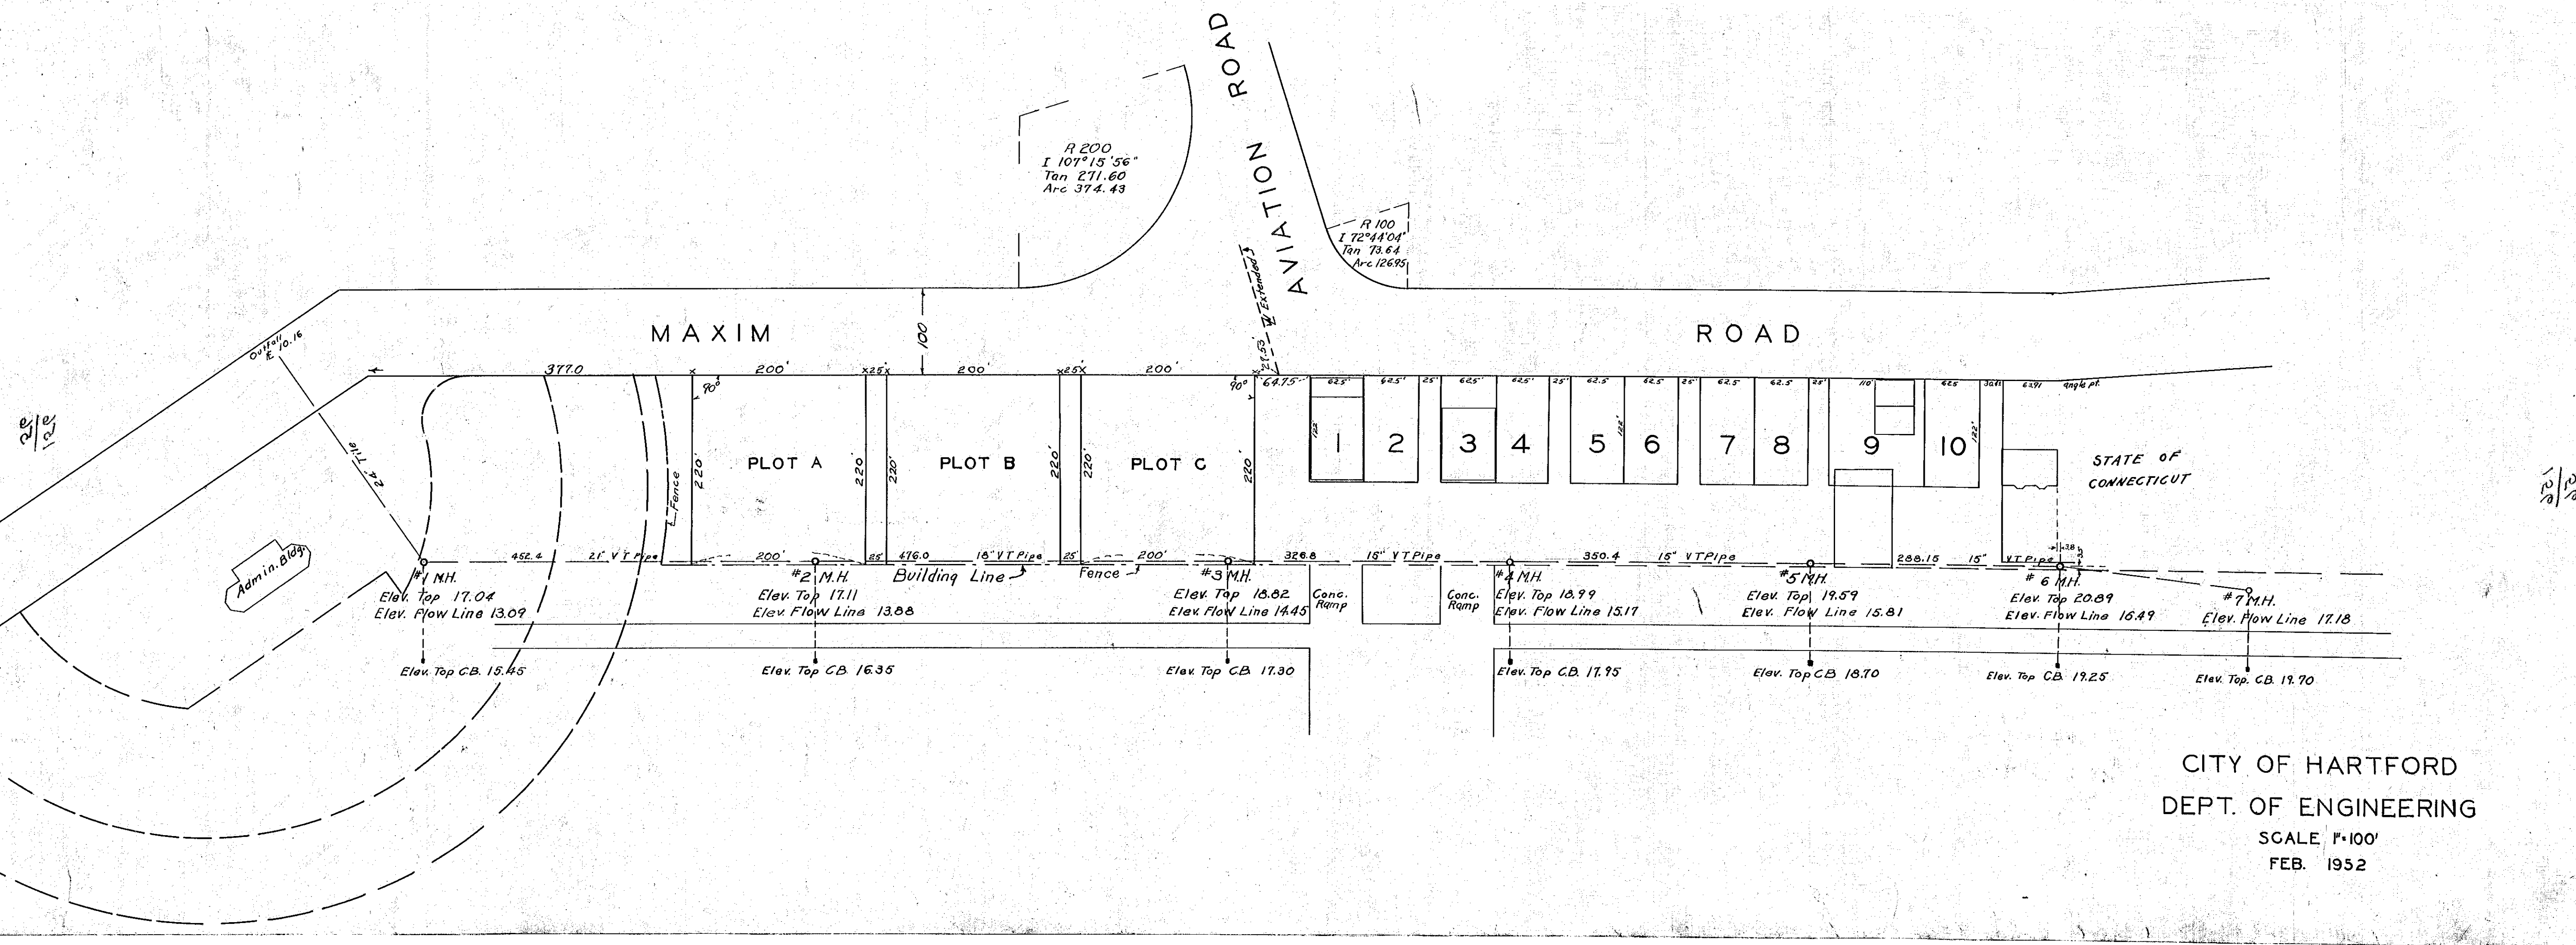

CITY OF HARTFORD
DEPT. OF ENGINEERING
SCALE 1"=100'
FEB. 1952