


126' 12"

City of Hartford
Land taken for dike

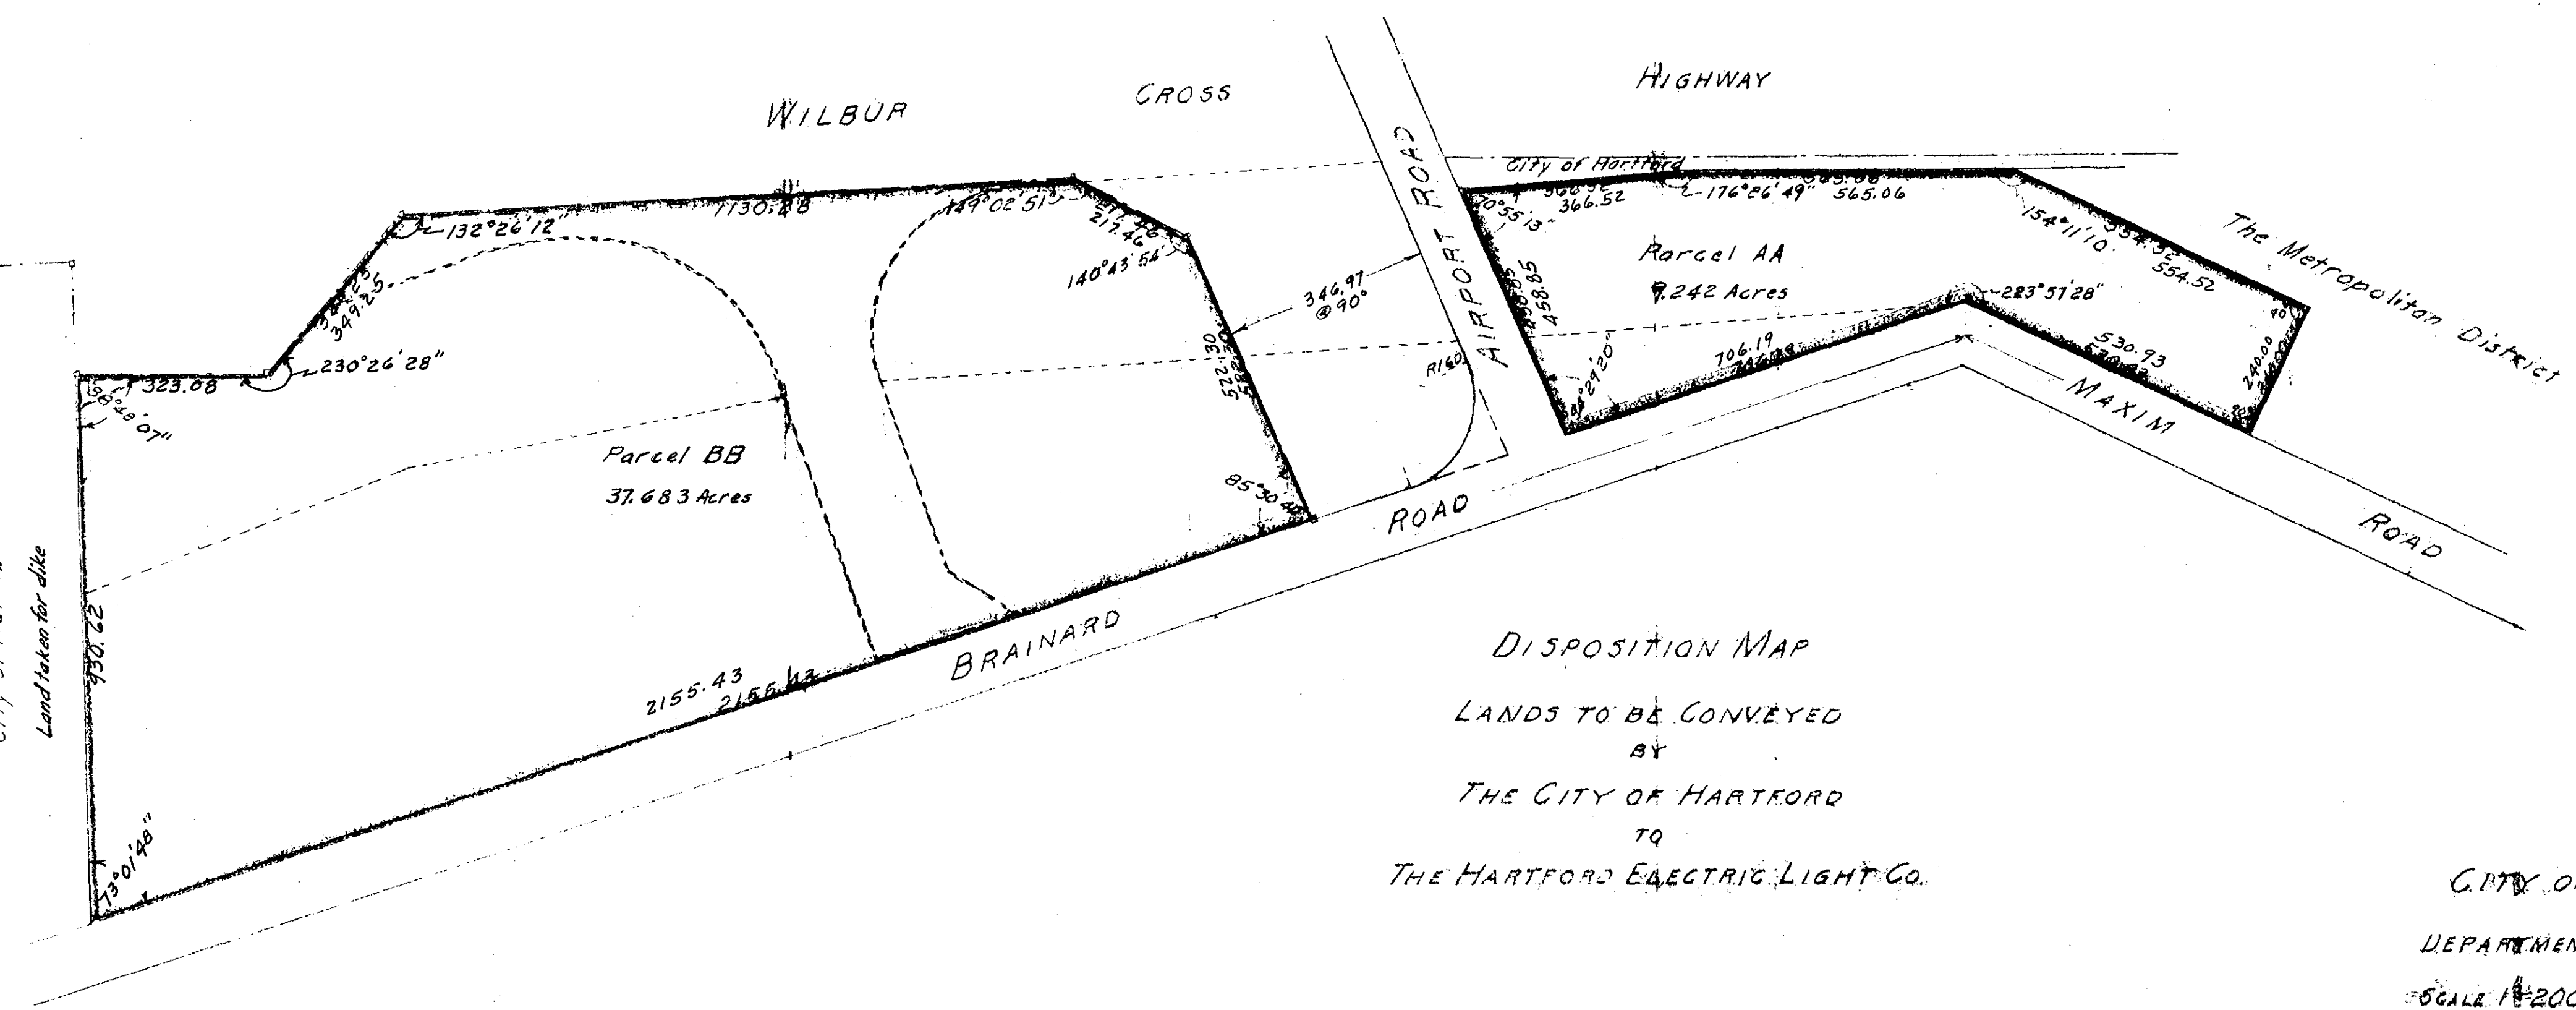

CITY OF HARTFORD
DEPARTMENT OF ENGINEERING
SCALE 1"=200' MAY 1960
DAYBOOK No. 09609A