


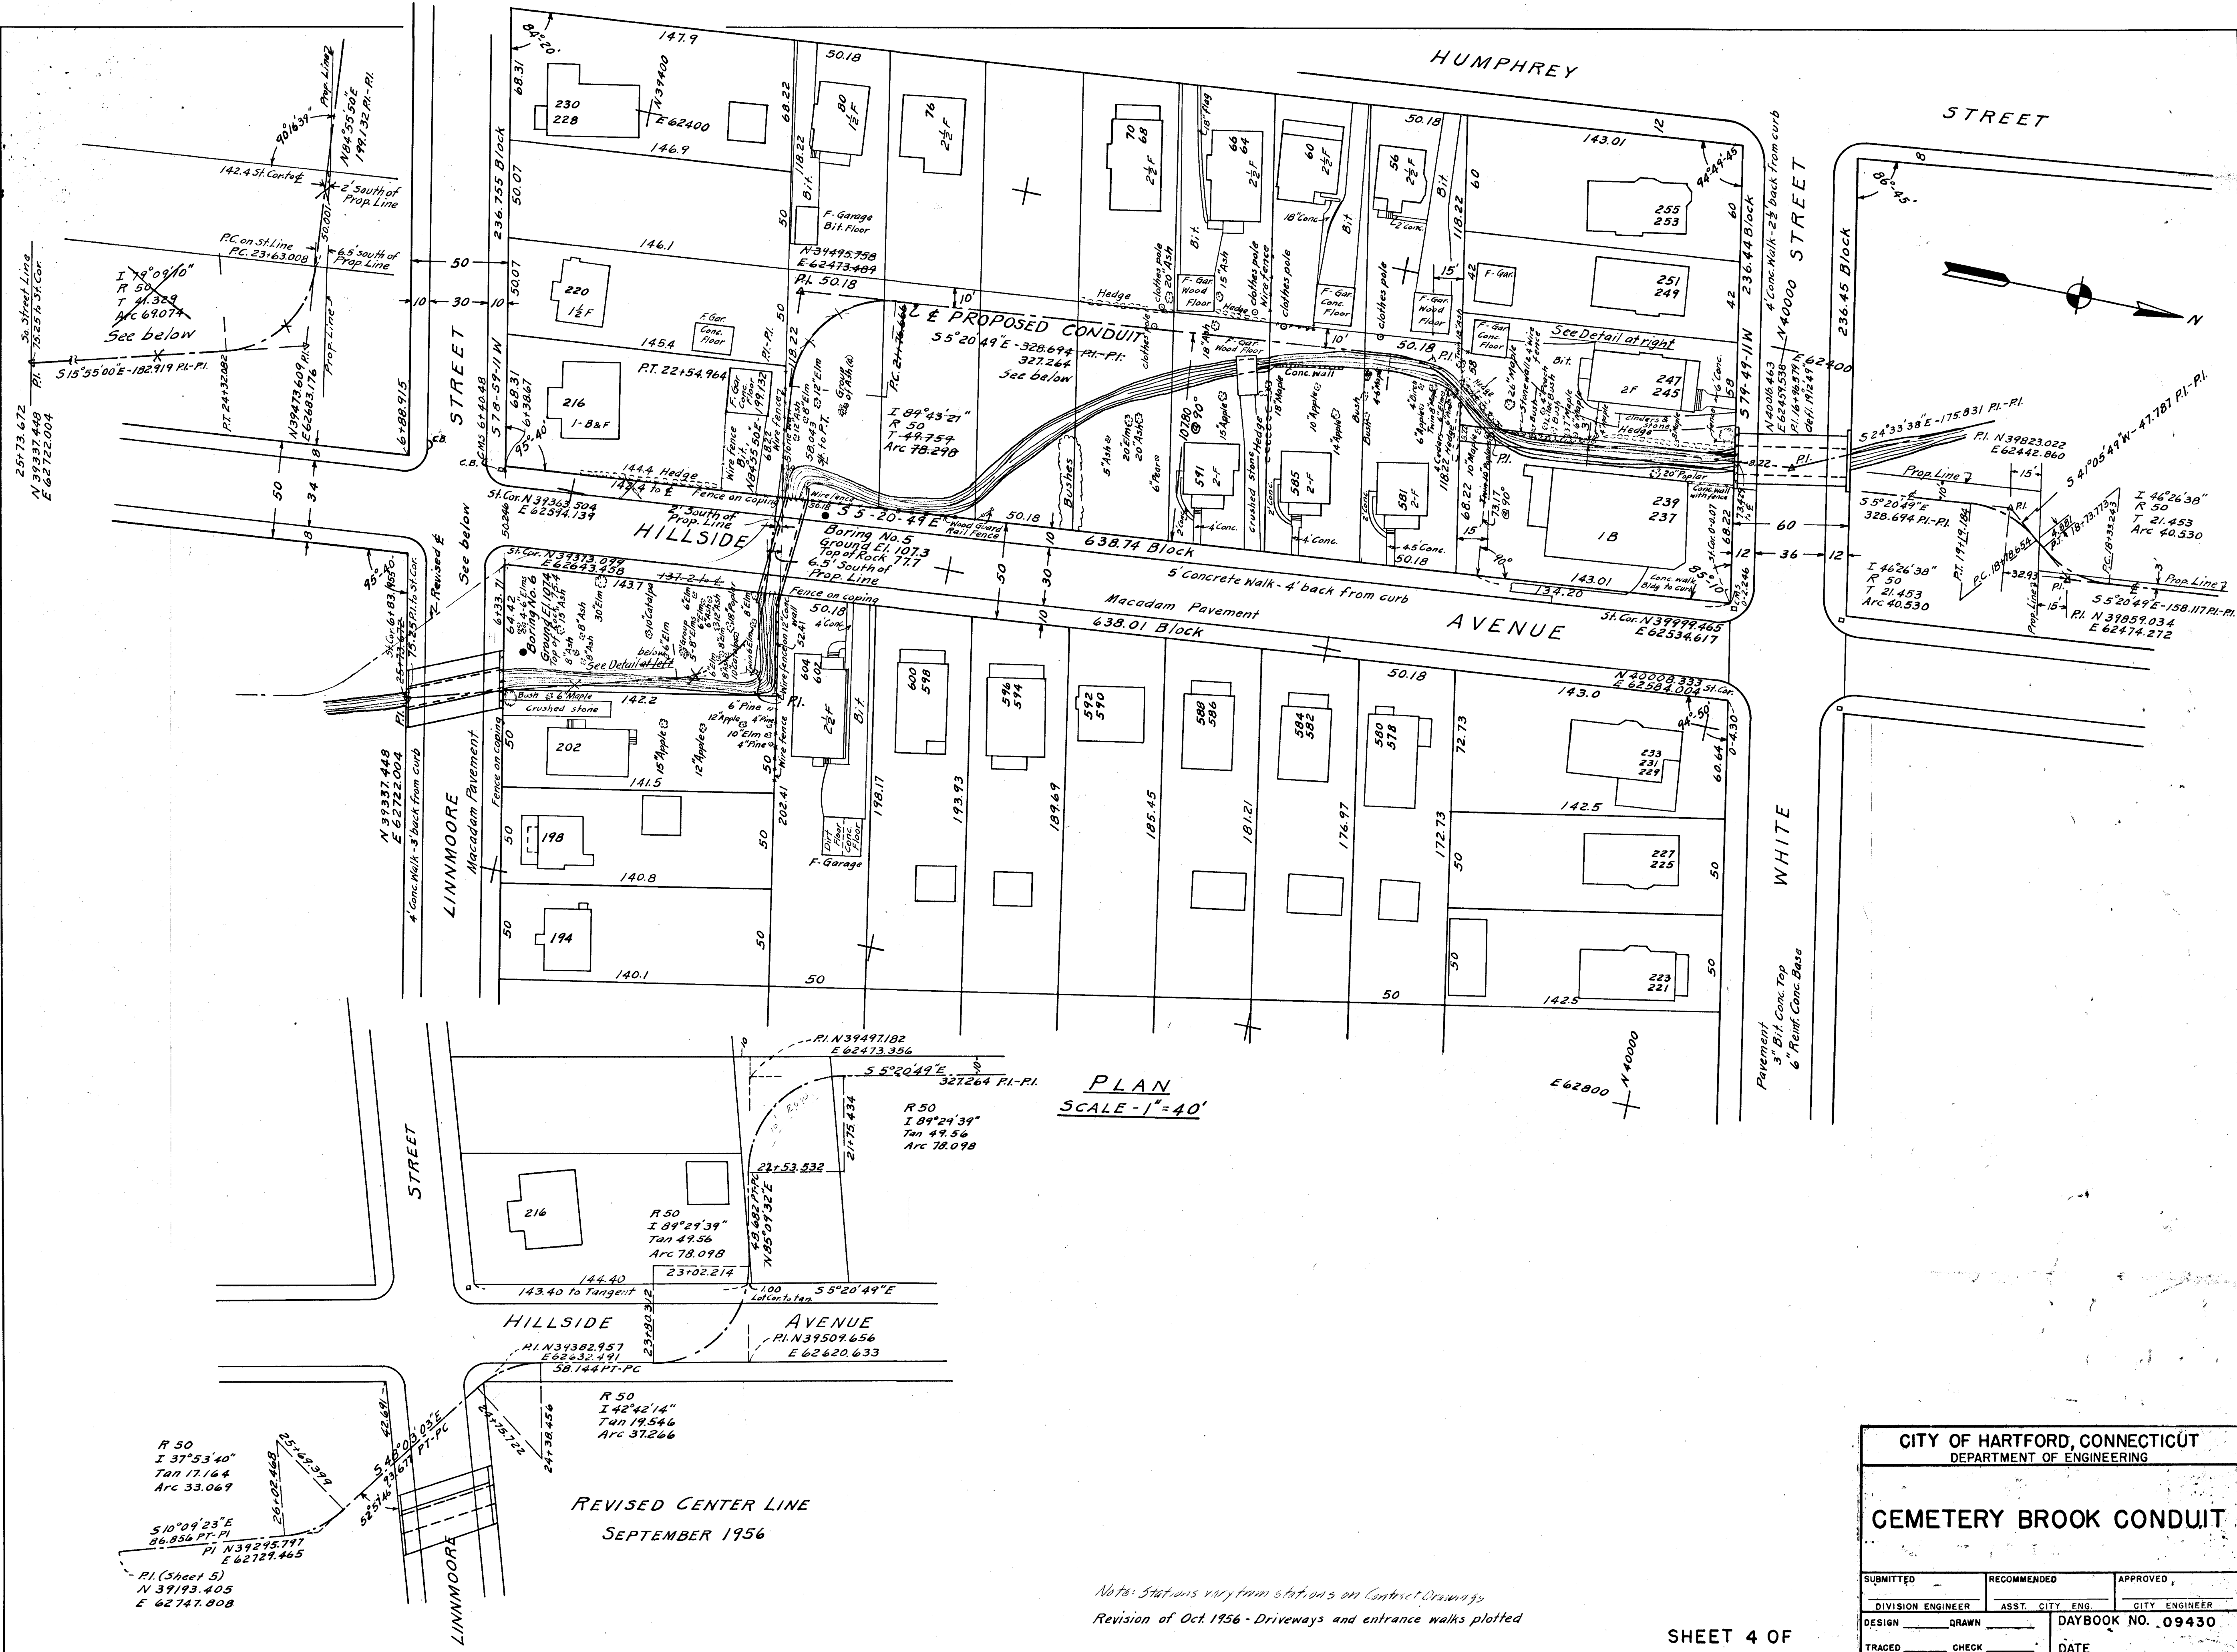

CITY OF HARTFORD, CONNECTICUT DEPARTMENT OF ENGINEERING		
CEMETERY BROOK CONDUIT		
SUBMITTED	RECOMMENDED	APPROVED
DIVISION ENGINEER	ASST. CITY ENG.	CITY ENGINEER
DESIGN	DRAWN	DAYBOOK NO. 09430
TRACED	CHECK	DATE