


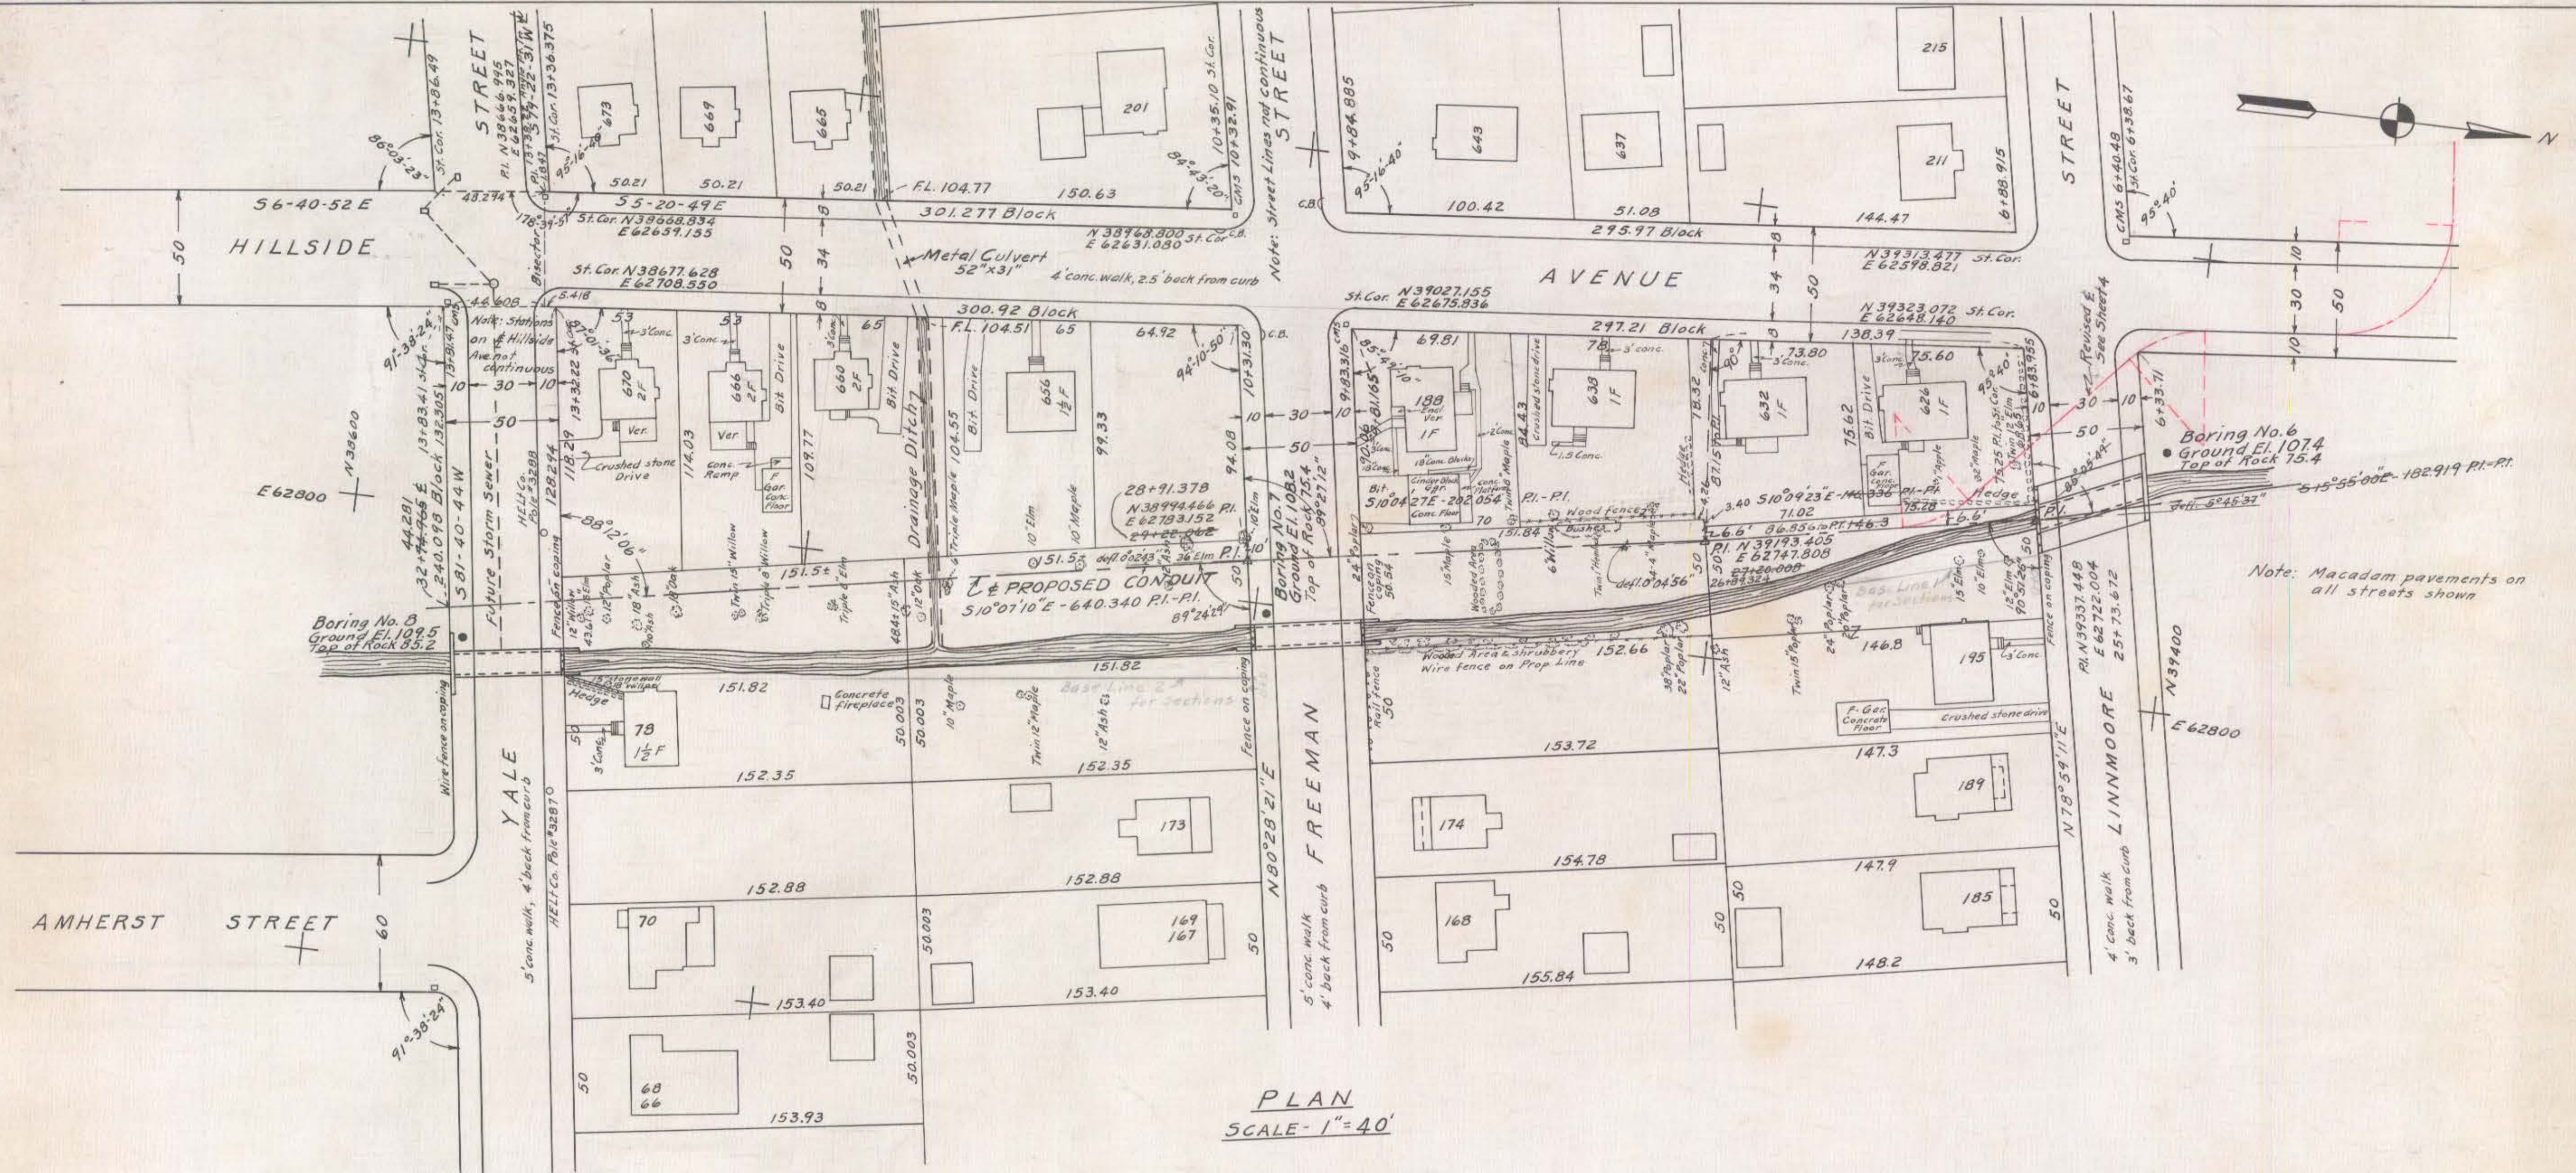

Revision of Oct. 1956 - Driveways and entrance walks plotted

Revision - Stations revised to conform with center line change - Sept. 1956

SHEET 5 OF

CITY OF HARTFORD, CONNECTICUT
DEPARTMENT OF ENGINEERING

CEMETERY BROOK CONDUIT

SUBMITTED	RECOMMENDED	APPROVED
DIVISION ENGINEER	ASST. CITY ENG.	CITY ENGINEER
DESIGN	DRAWN	DAYBOOK NO. 09430
TRACED	CHECK	DATE