


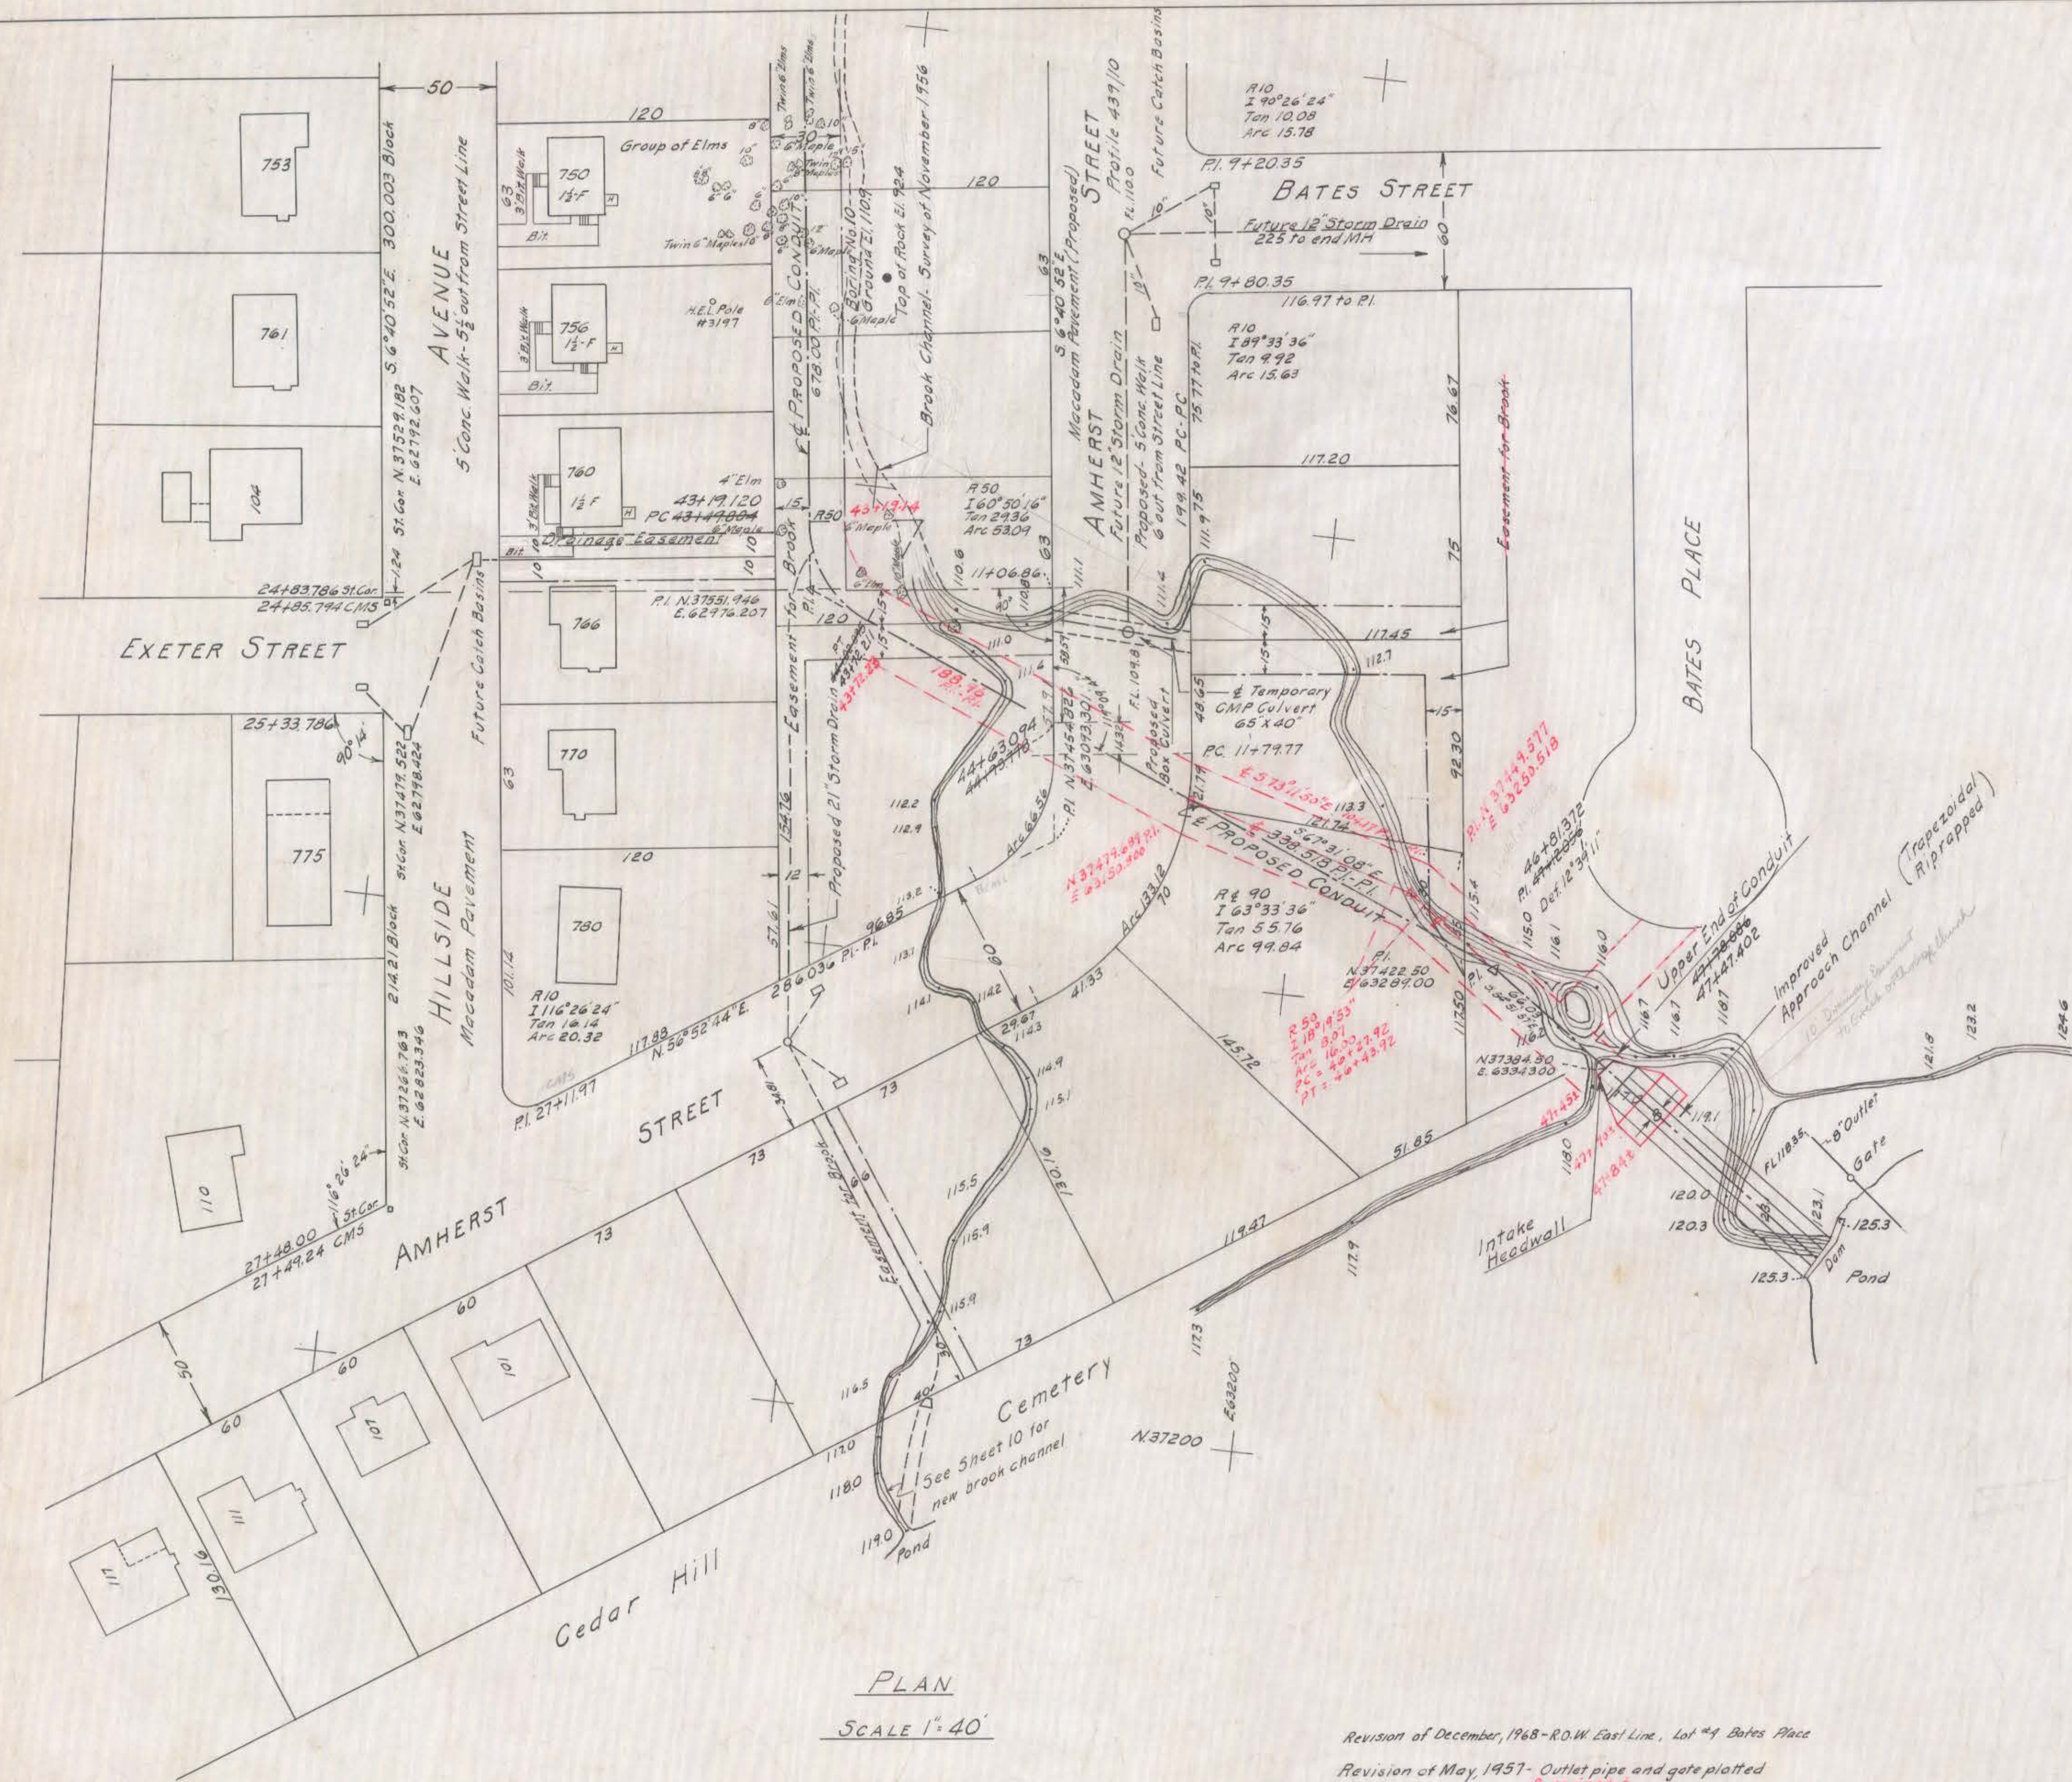

PLAN
SCALE 1" = 40'

Revision of December, 1968 - R.O.W. East Line, Lot #4 Bates Place
 Revision of May, 1957 - Outlet pipe and gate plotted & revised
 Revision of November, 1956 - Change in brook channel plotted
 Revision of October, 1956 - Entranc walks, driveways, and trees plotted
 Revision of September, 1956 - Stations revised to conform with center line change at Linnmoore St.

CITY OF HARTFORD, CONNECTICUT DEPARTMENT OF ENGINEERING		
CEMETERY BROOK CONDUIT		
SUBMITTED	RECOMMENDED	APPROVED
DIVISION ENGINEER	ASST. CITY ENG.	CITY ENGINEER
DESIGN	DRAWN	DAYBOOK NO. 09430
TRACED	CHECK	DATE