


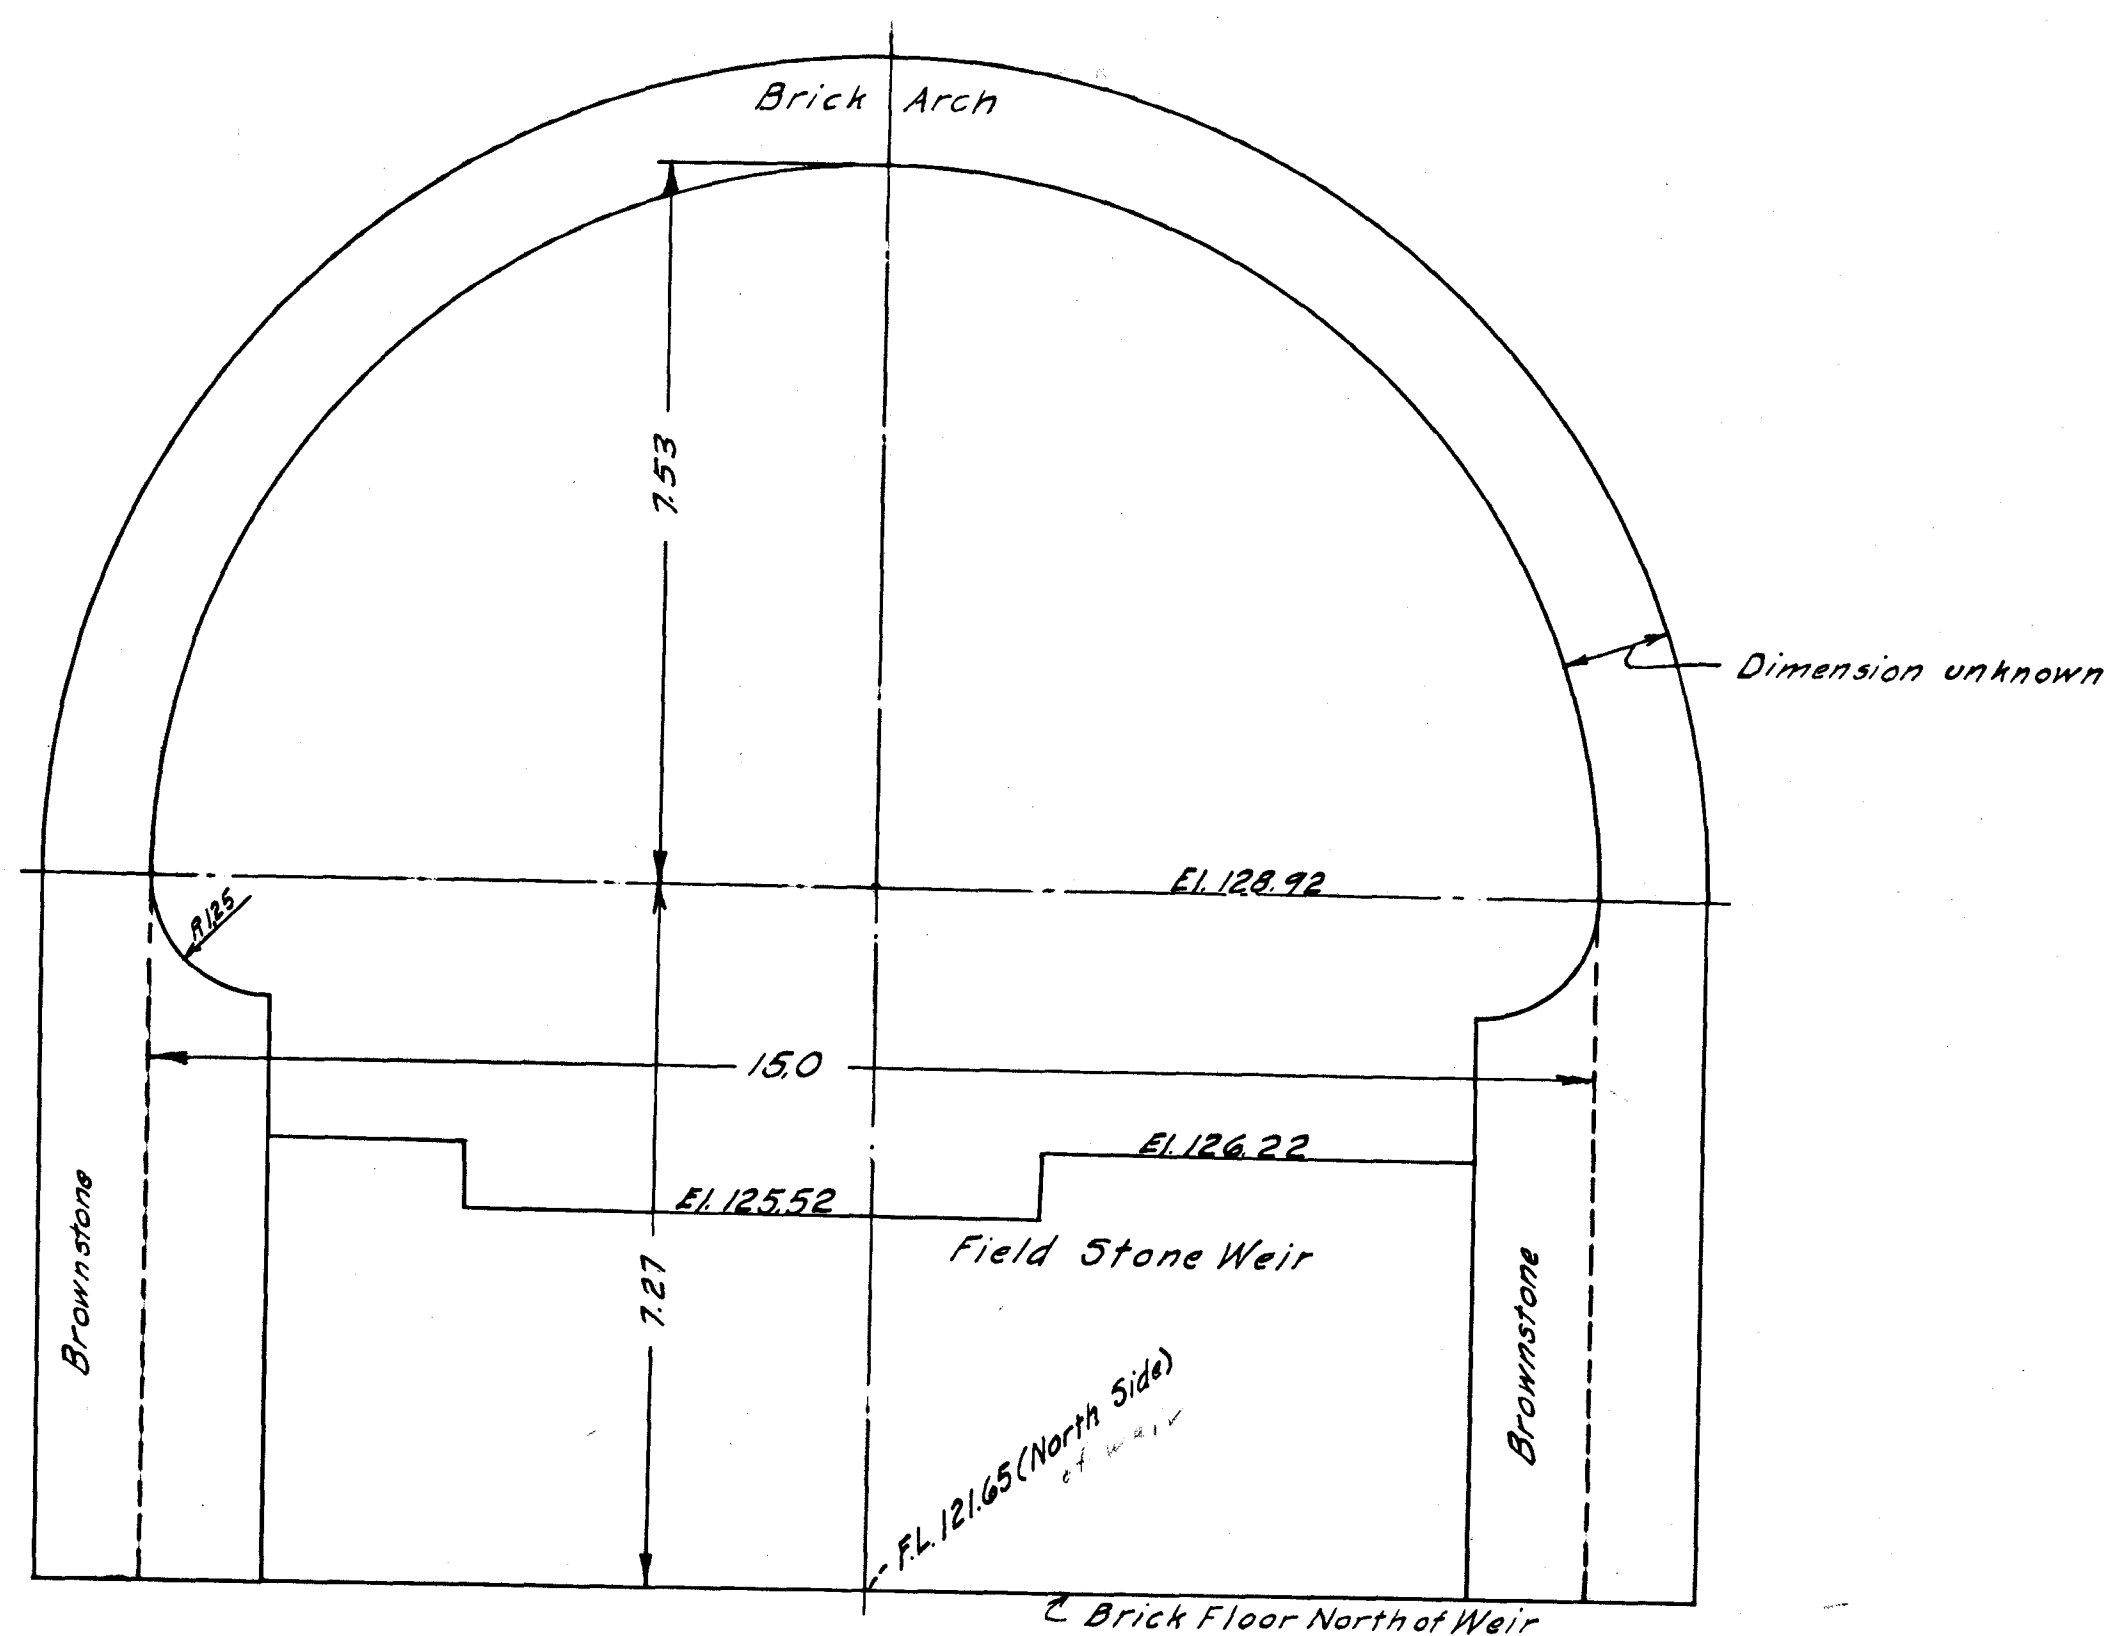


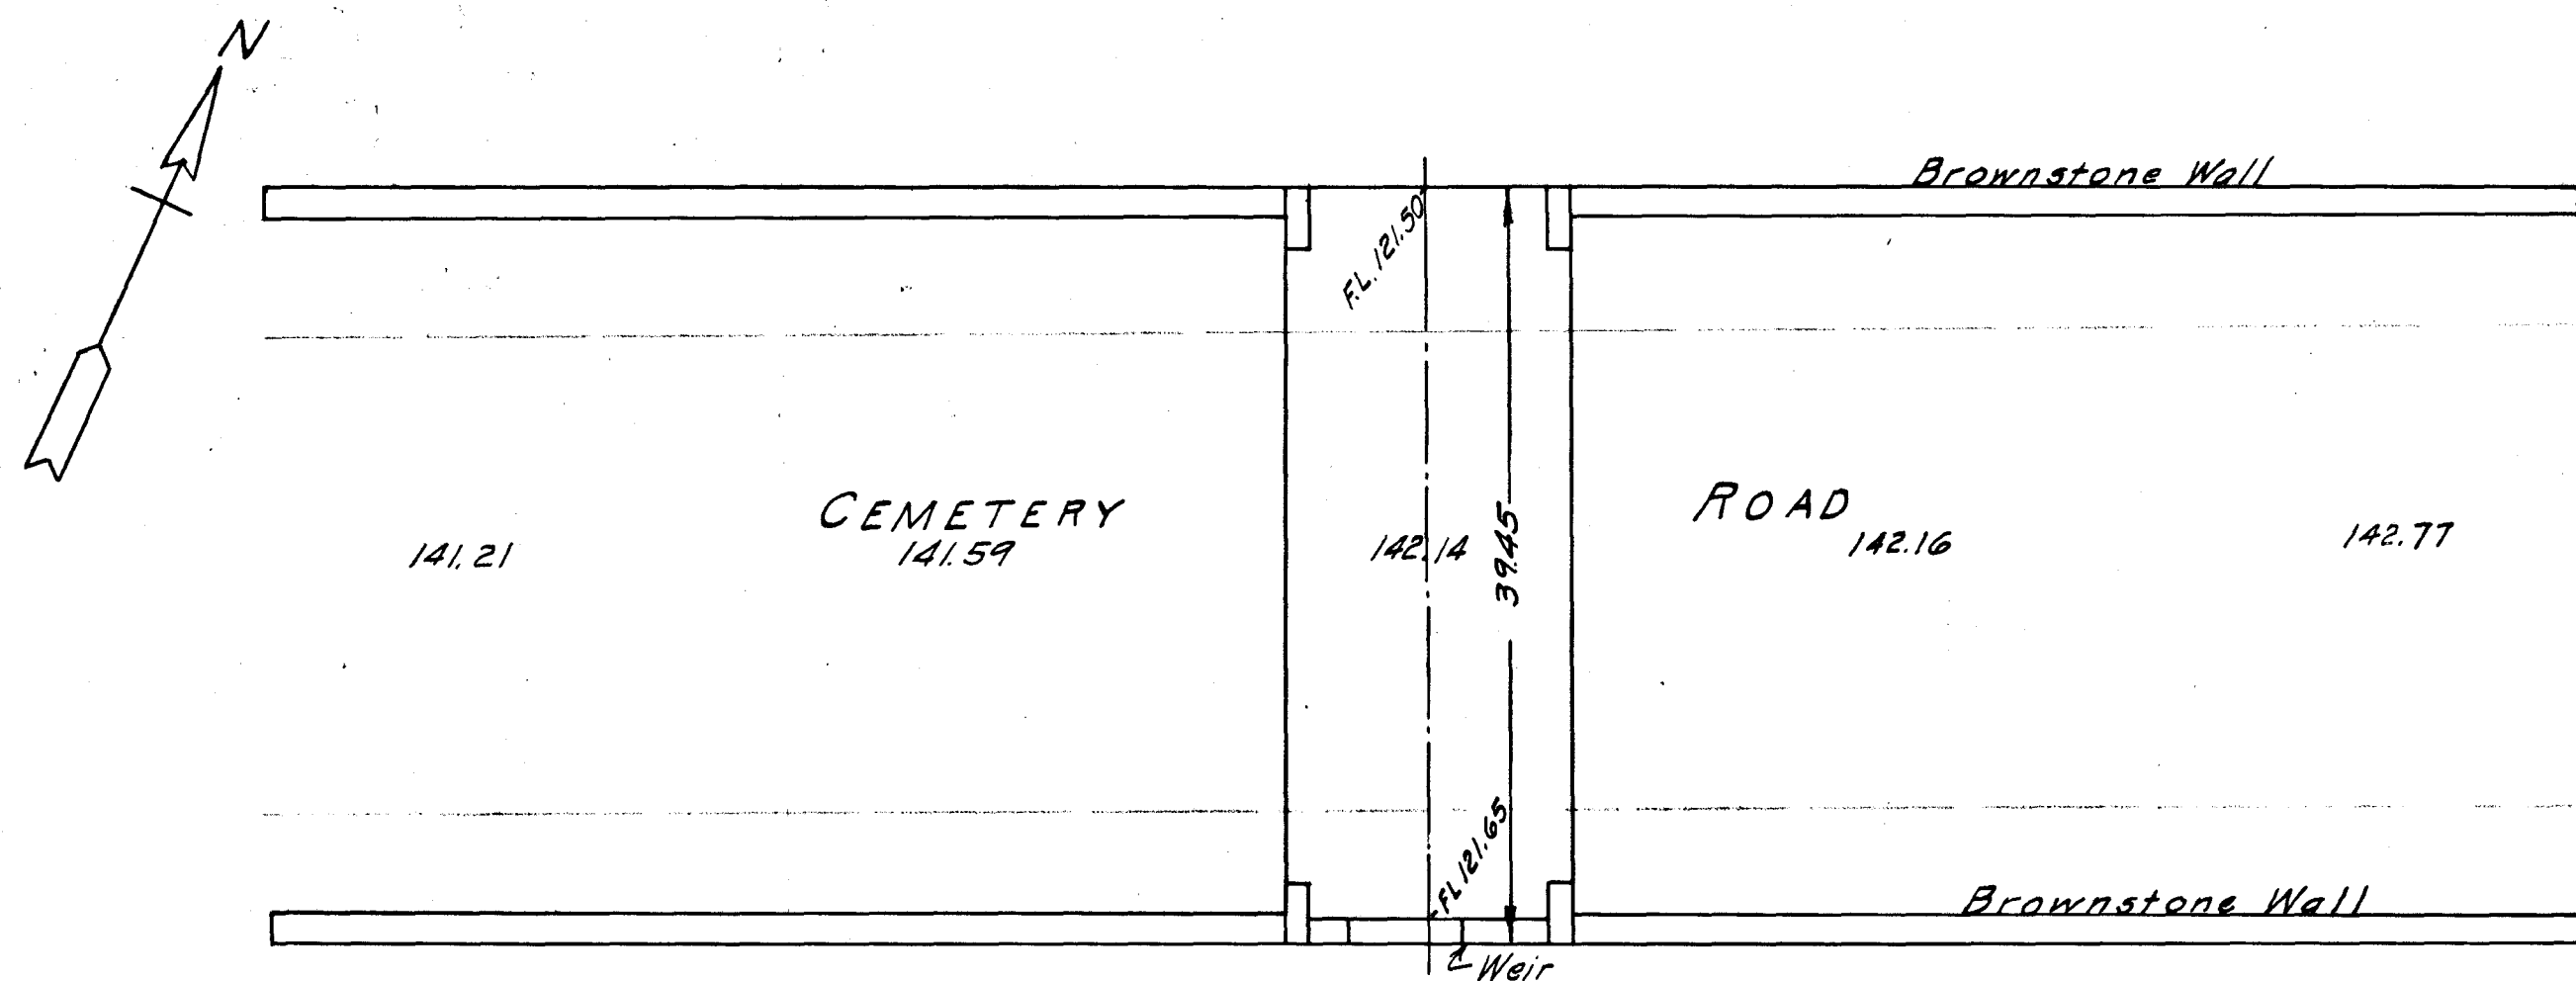


CULVERT IN CEDAR HILL CEMETERY

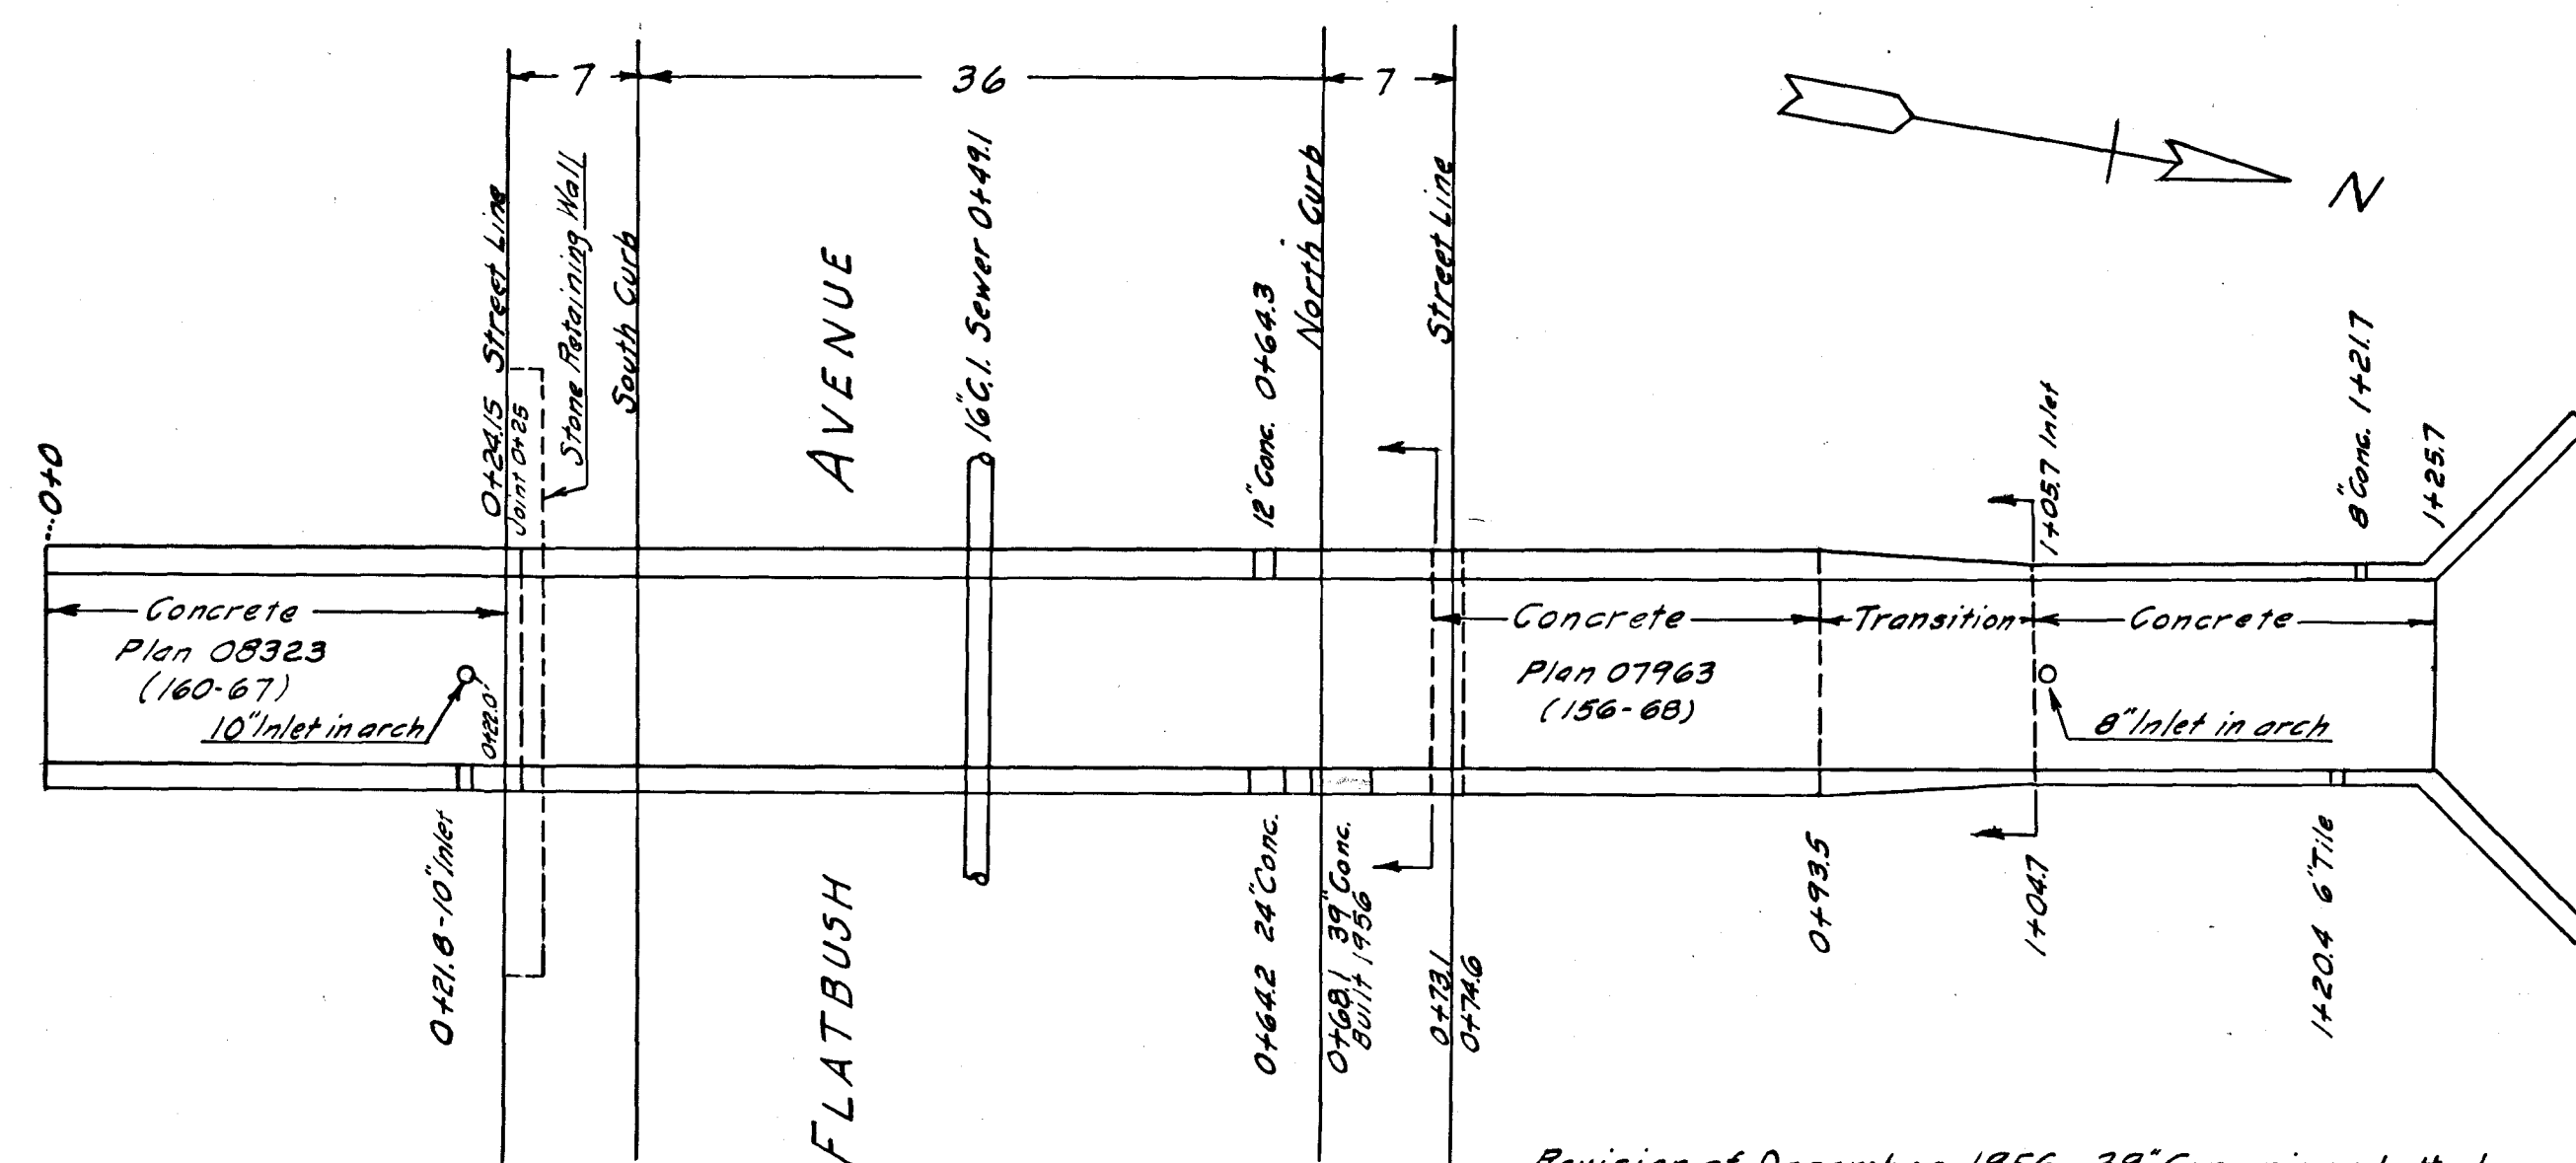

Revision of December, 1956 - 39" Conc. pipe plotted

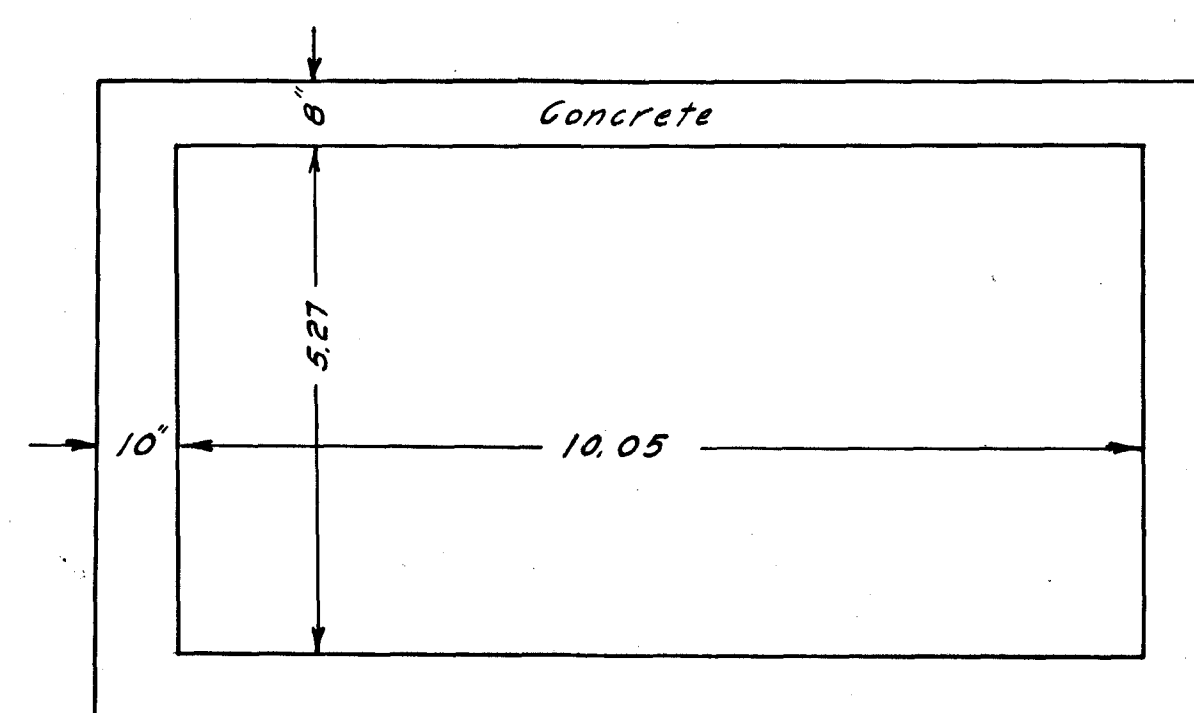

SECTION AT 1+04.7

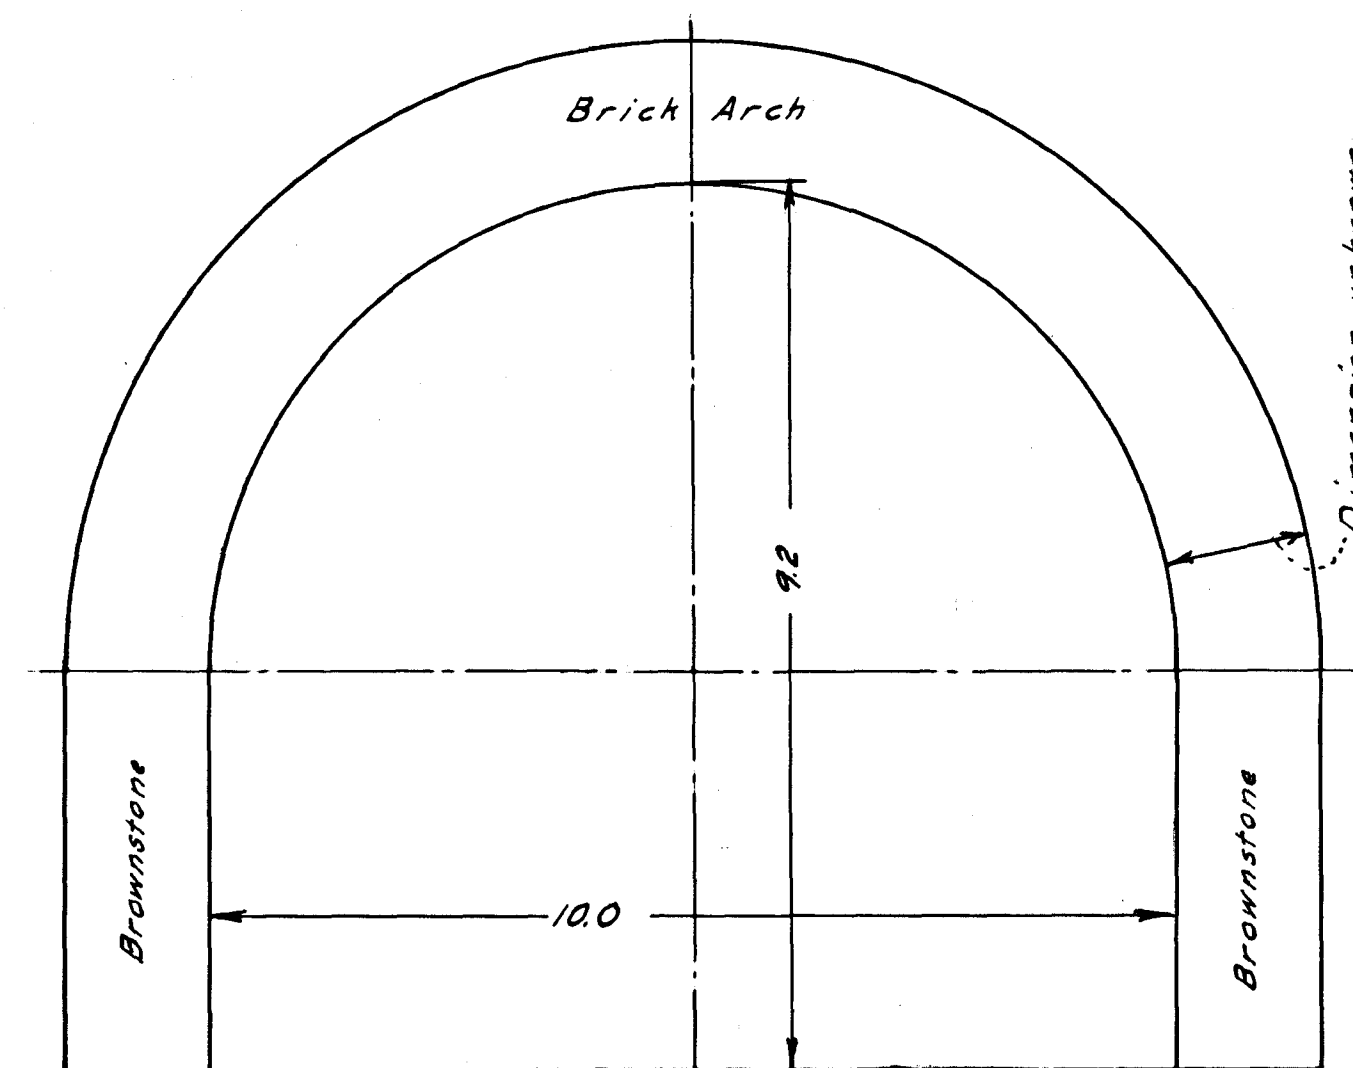

SECTION AT 0+73.1

FLATBUSH AVENUE CULVERT

Scale 1/2"=1'

CITY OF HARTFORD, CONNECTICUT DEPARTMENT OF ENGINEERING		
CEMETERY BROOK CONDUIT		
SUBMITTED	RECOMMENDED	APPROVED
DIVISION ENGINEER	ASST. CITY ENG.	CITY ENGINEER
DESIGN	DRAWN	DAYBOOK NO. 09430
TRACED	CHECK	DATE FEBRUARY 1956