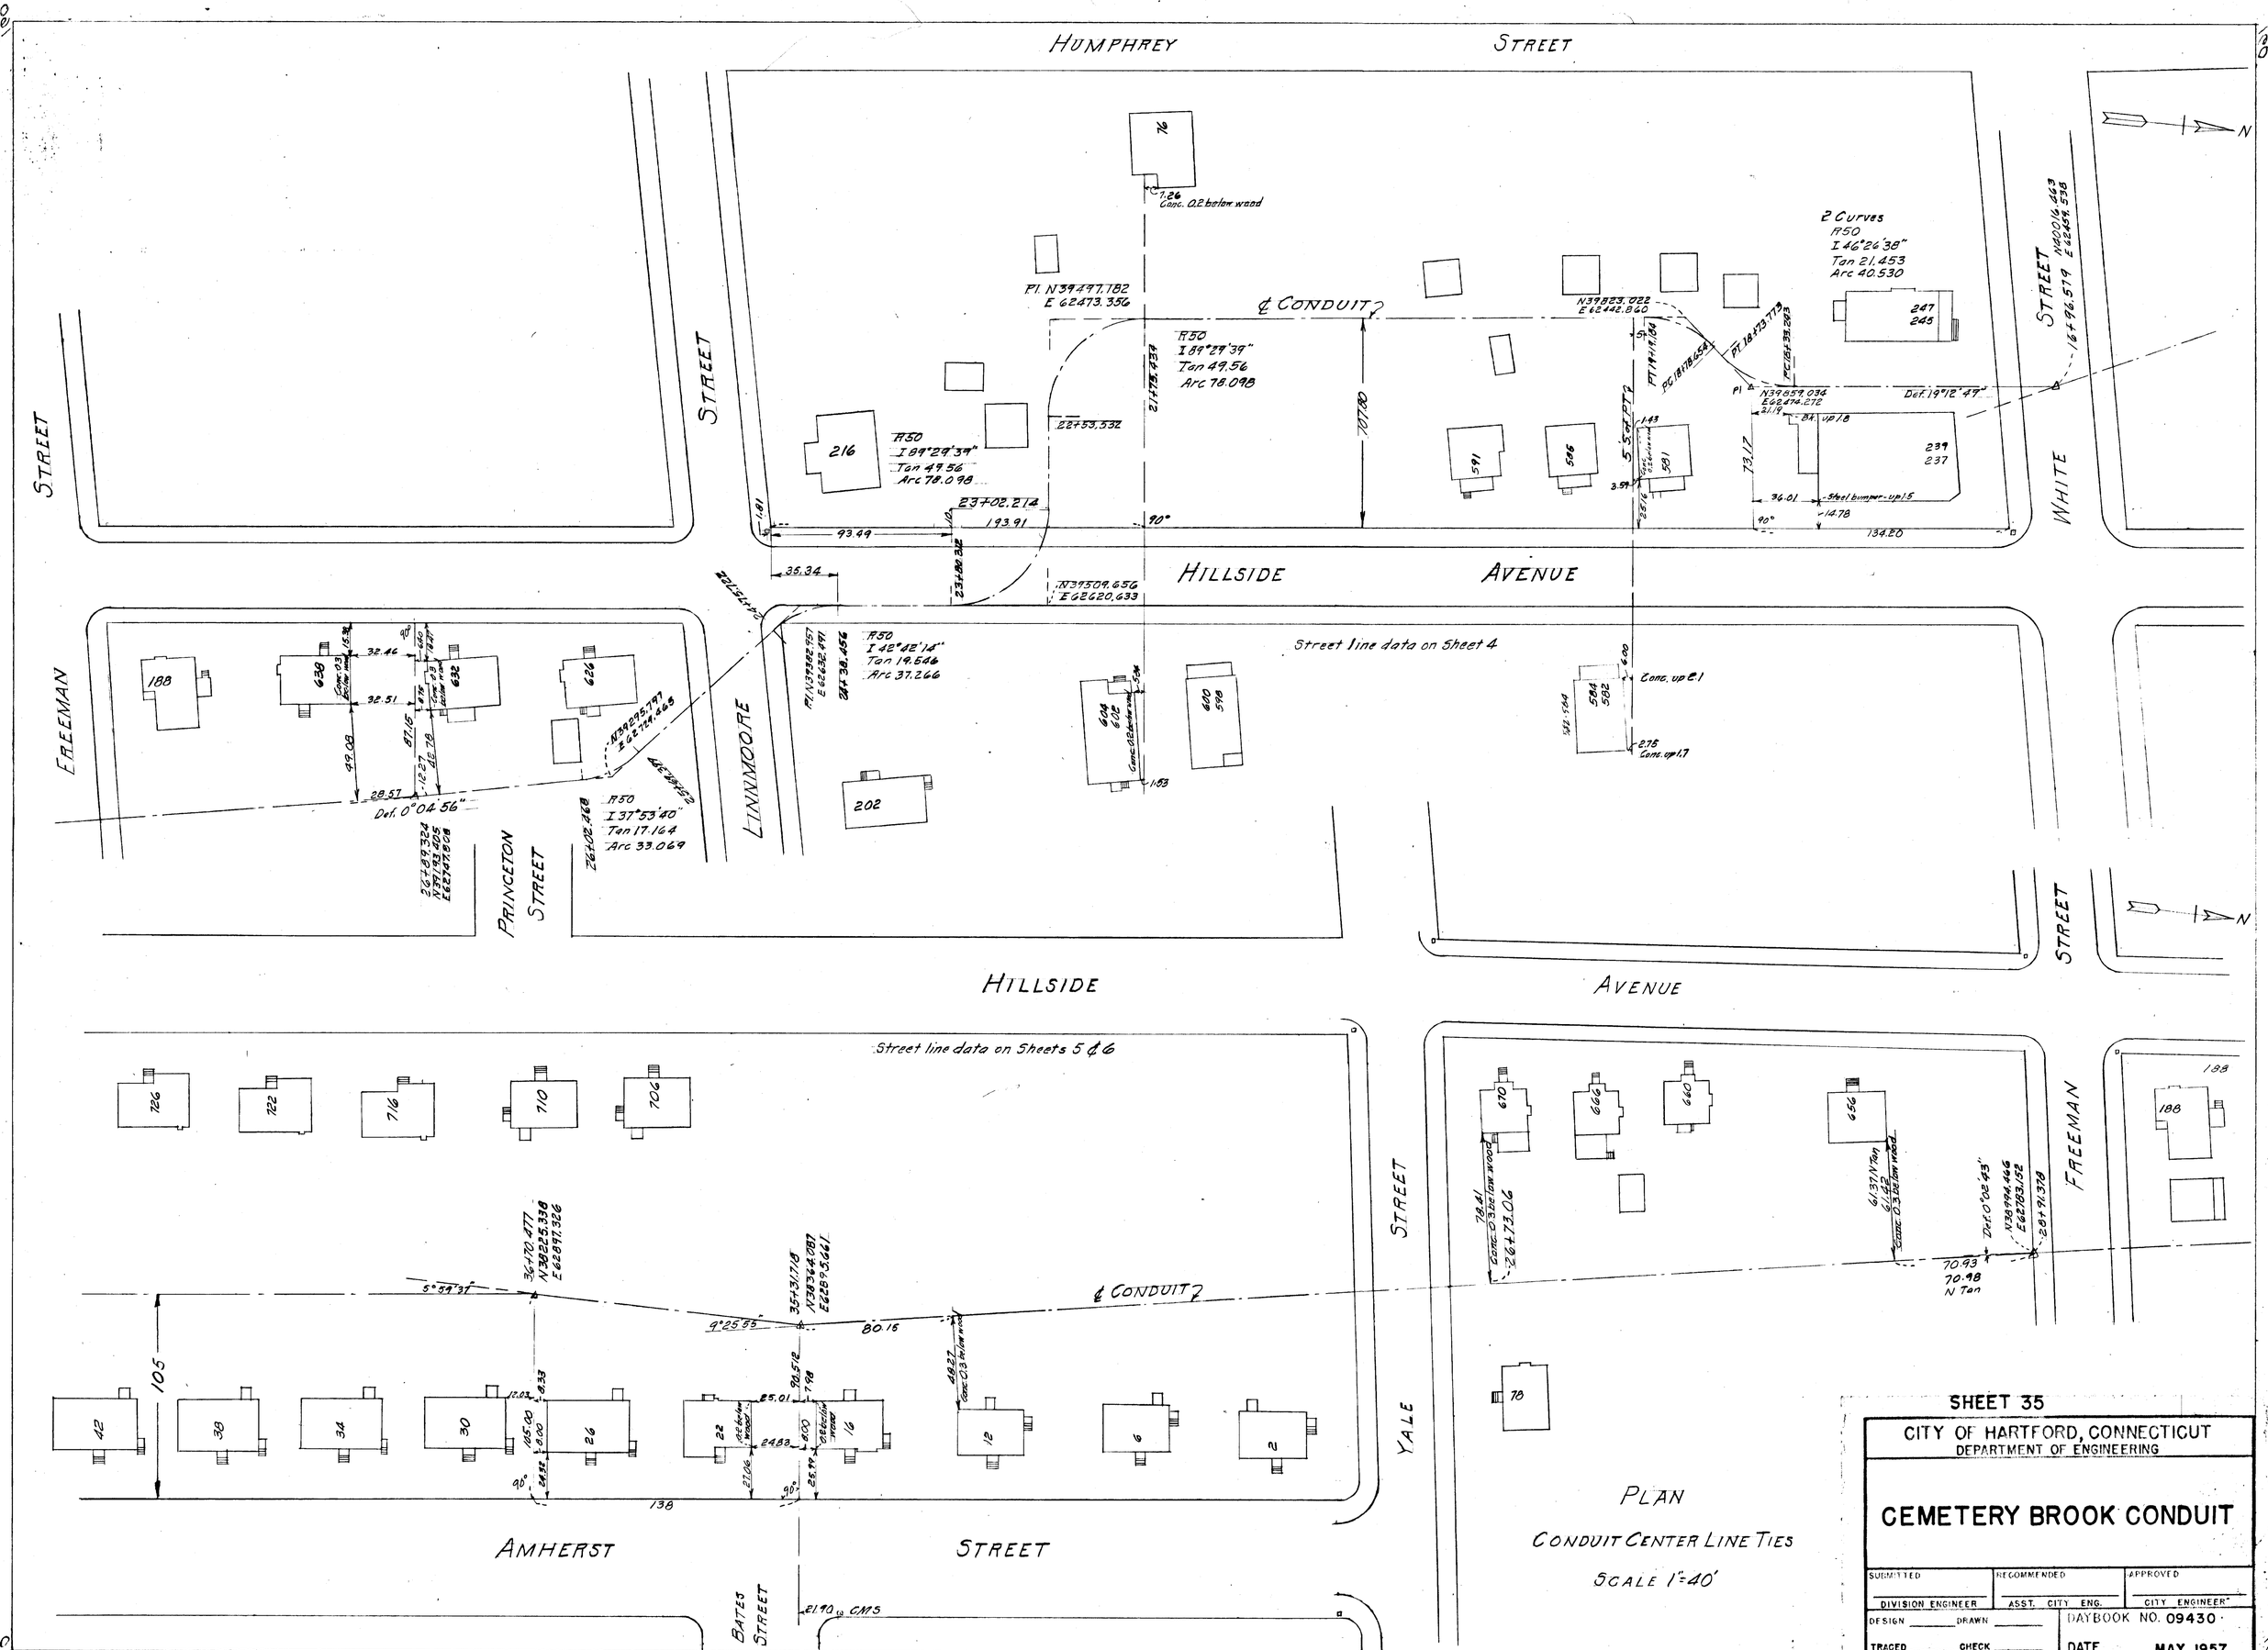

SHEET 35

CITY OF HARTFORD, CONNECTICUT
DEPARTMENT OF ENGINEERING

CEMETERY BROOK CONDUIT

SUBMITTED	RECOMMENDED	APPROVED
DIVISION ENGINEER	ASST. CITY ENG.	CITY ENGINEER

DESIGN _____ DRAWN _____ DAYBOOK NO. 09430

TRACED _____ CHECK _____ DATE MAY 1957