


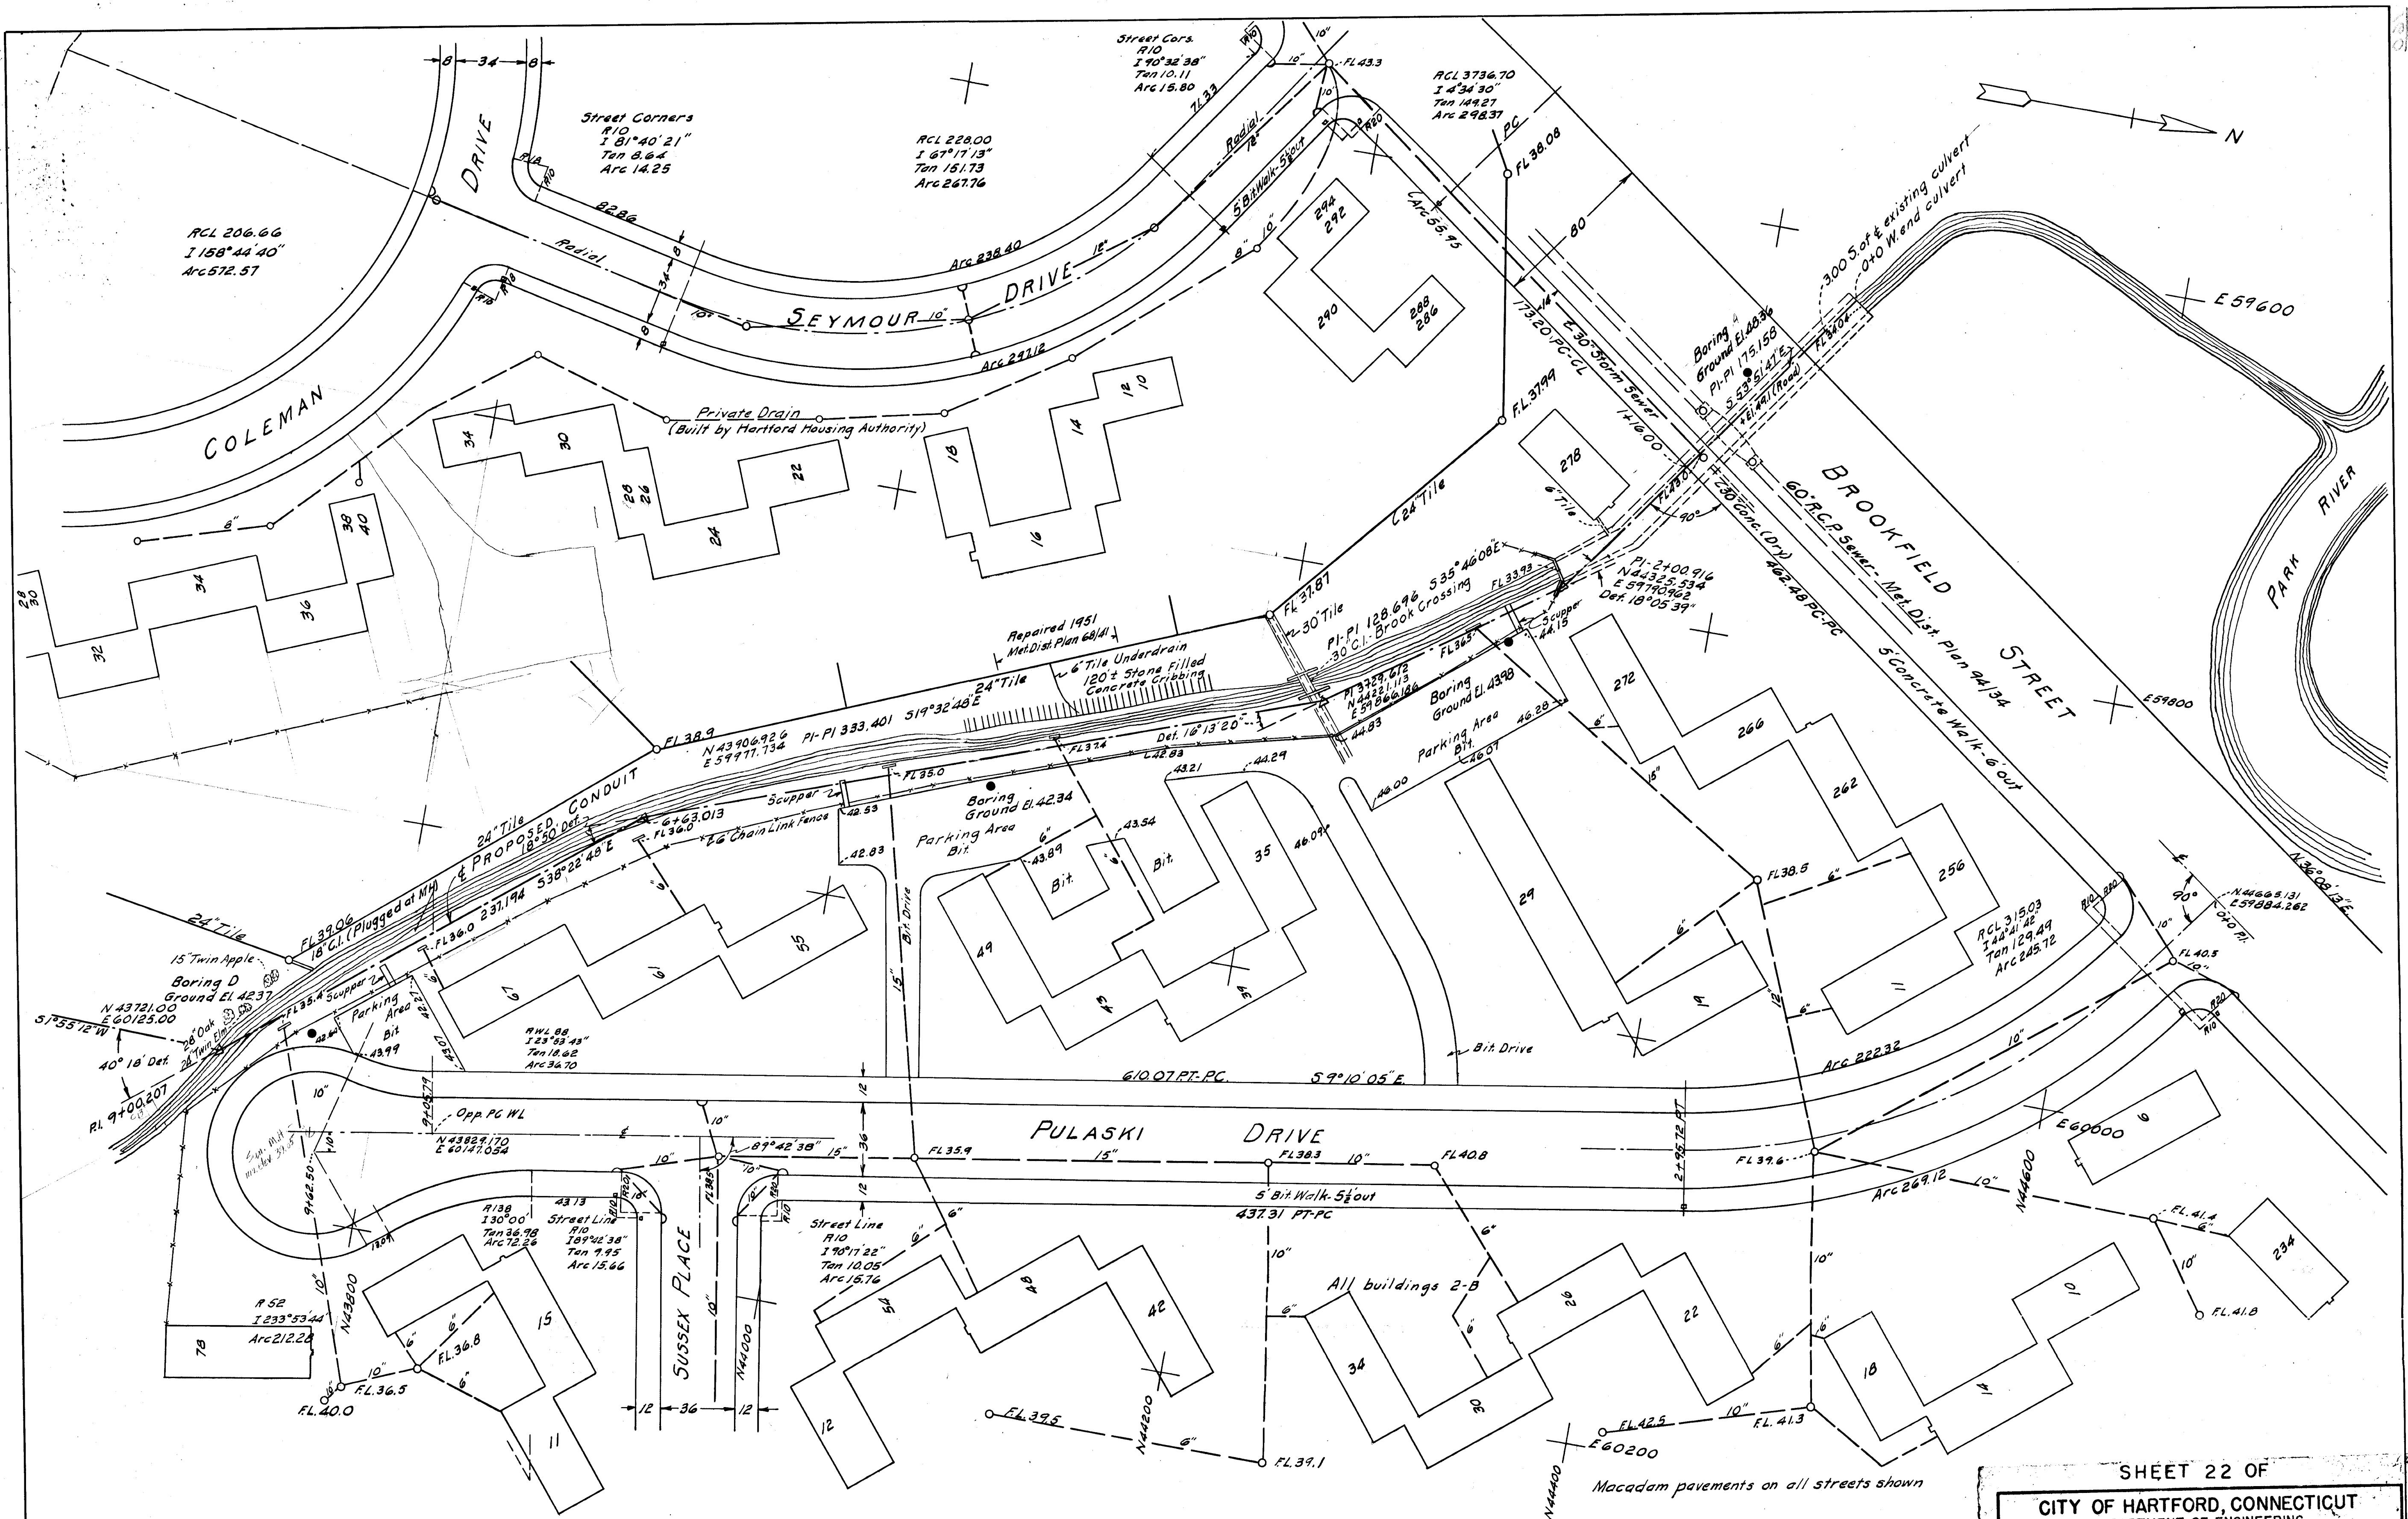

PLAN
SCALE 1" = 40'

Revision of April 3, 1957 - Center line of proposed conduit plotted

Macadam pavements on all streets shown

Revisions of Nov. 7, 1957 - & Conduit moved 8' east of former location from Sta. 2+00.916 to Sta. 6+63.013

Concrete cribbing plotted from survey

Revision of Jan. 15, 1957 - Elevations in parking areas plotted

Revision of Jan. 2, 1957 - Buildings and storm drains East of Pulaski Drive plotted

SHEET 22 OF

CITY OF HARTFORD, CONNECTICUT DEPARTMENT OF ENGINEERING		
CEMETERY BROOK CONDUIT		
SUBMITTED	RECOMMENDED	APPROVED
DIVISION ENGINEER	ASST. CITY ENG.	CITY ENGINEER
DESIGN	DRAWN	DAYBOOK NO. 09430
TRACED	CHECK	DATE NOVEMBER 1956