
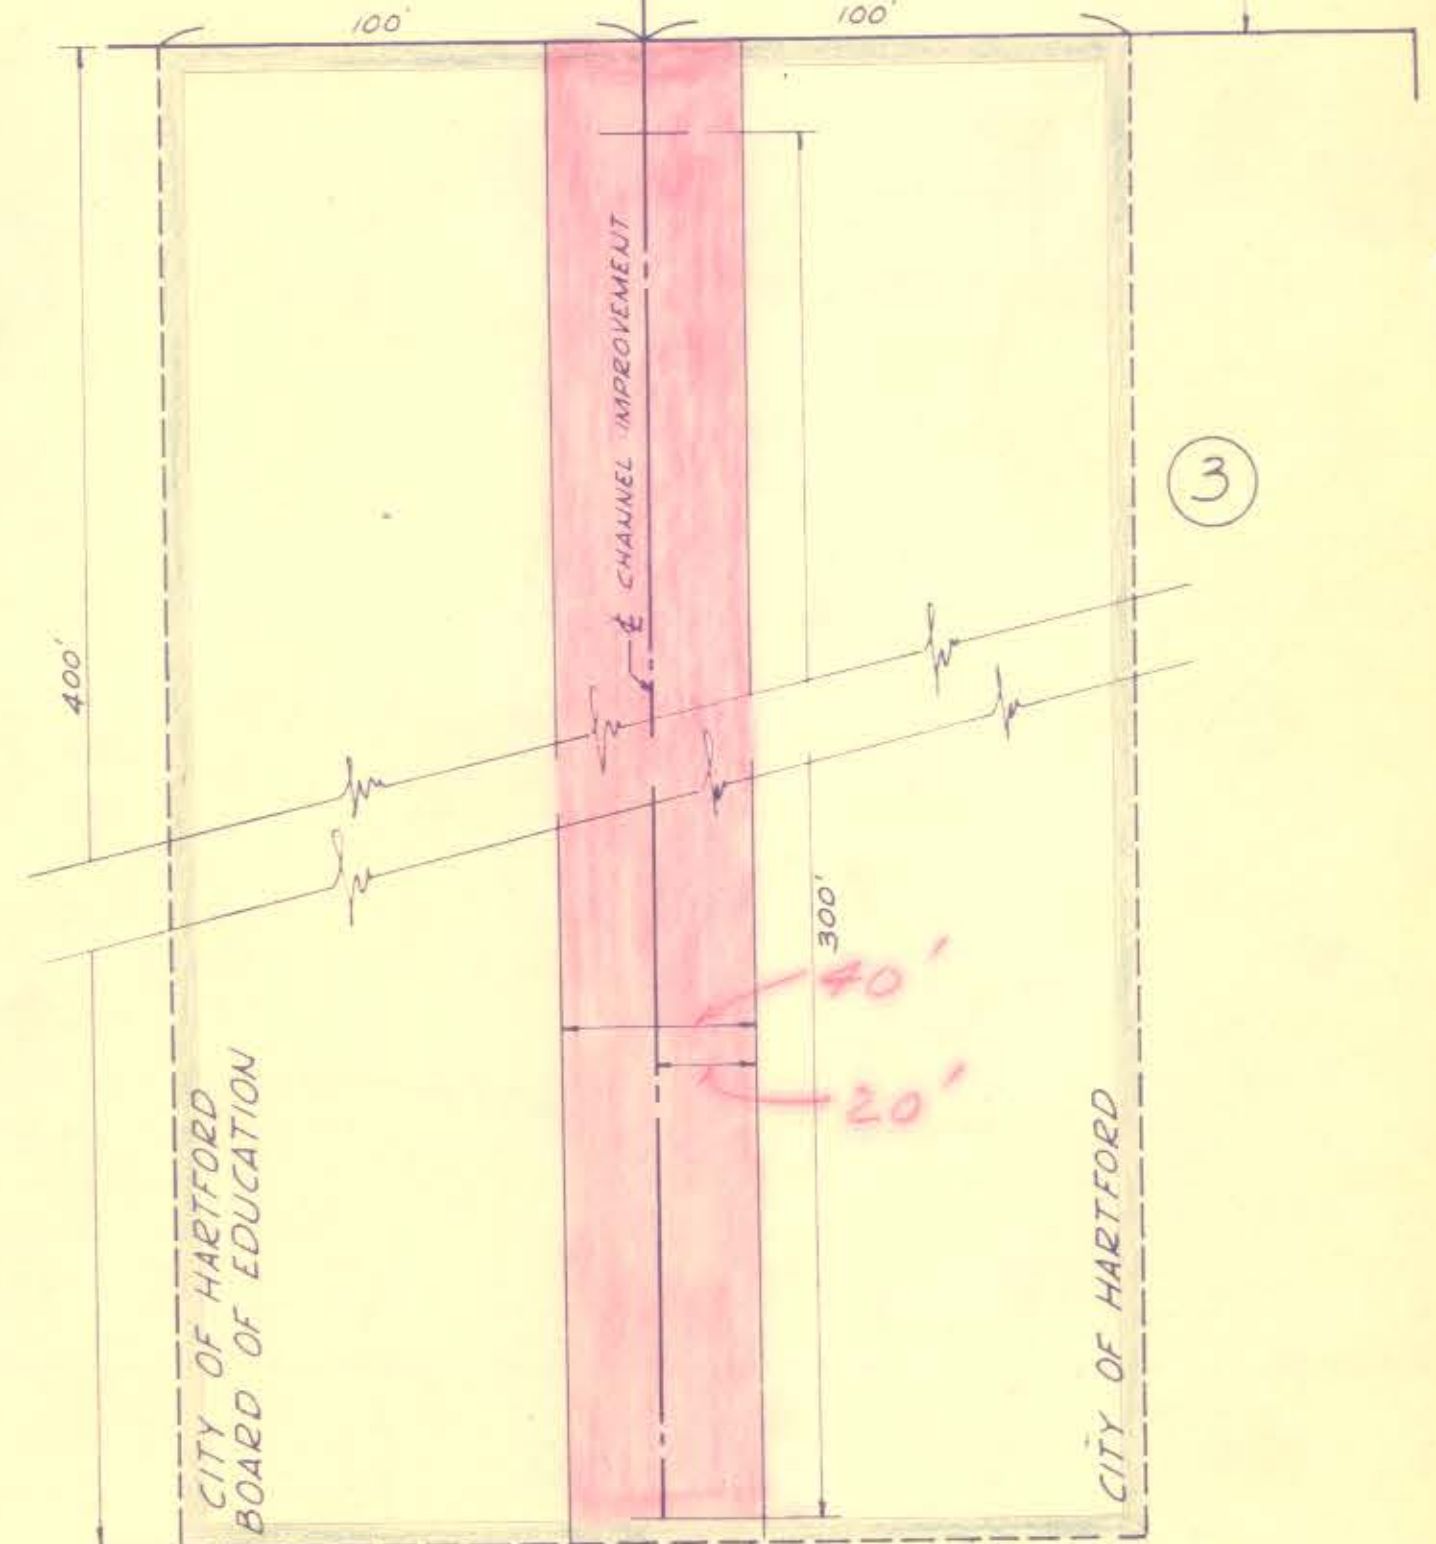


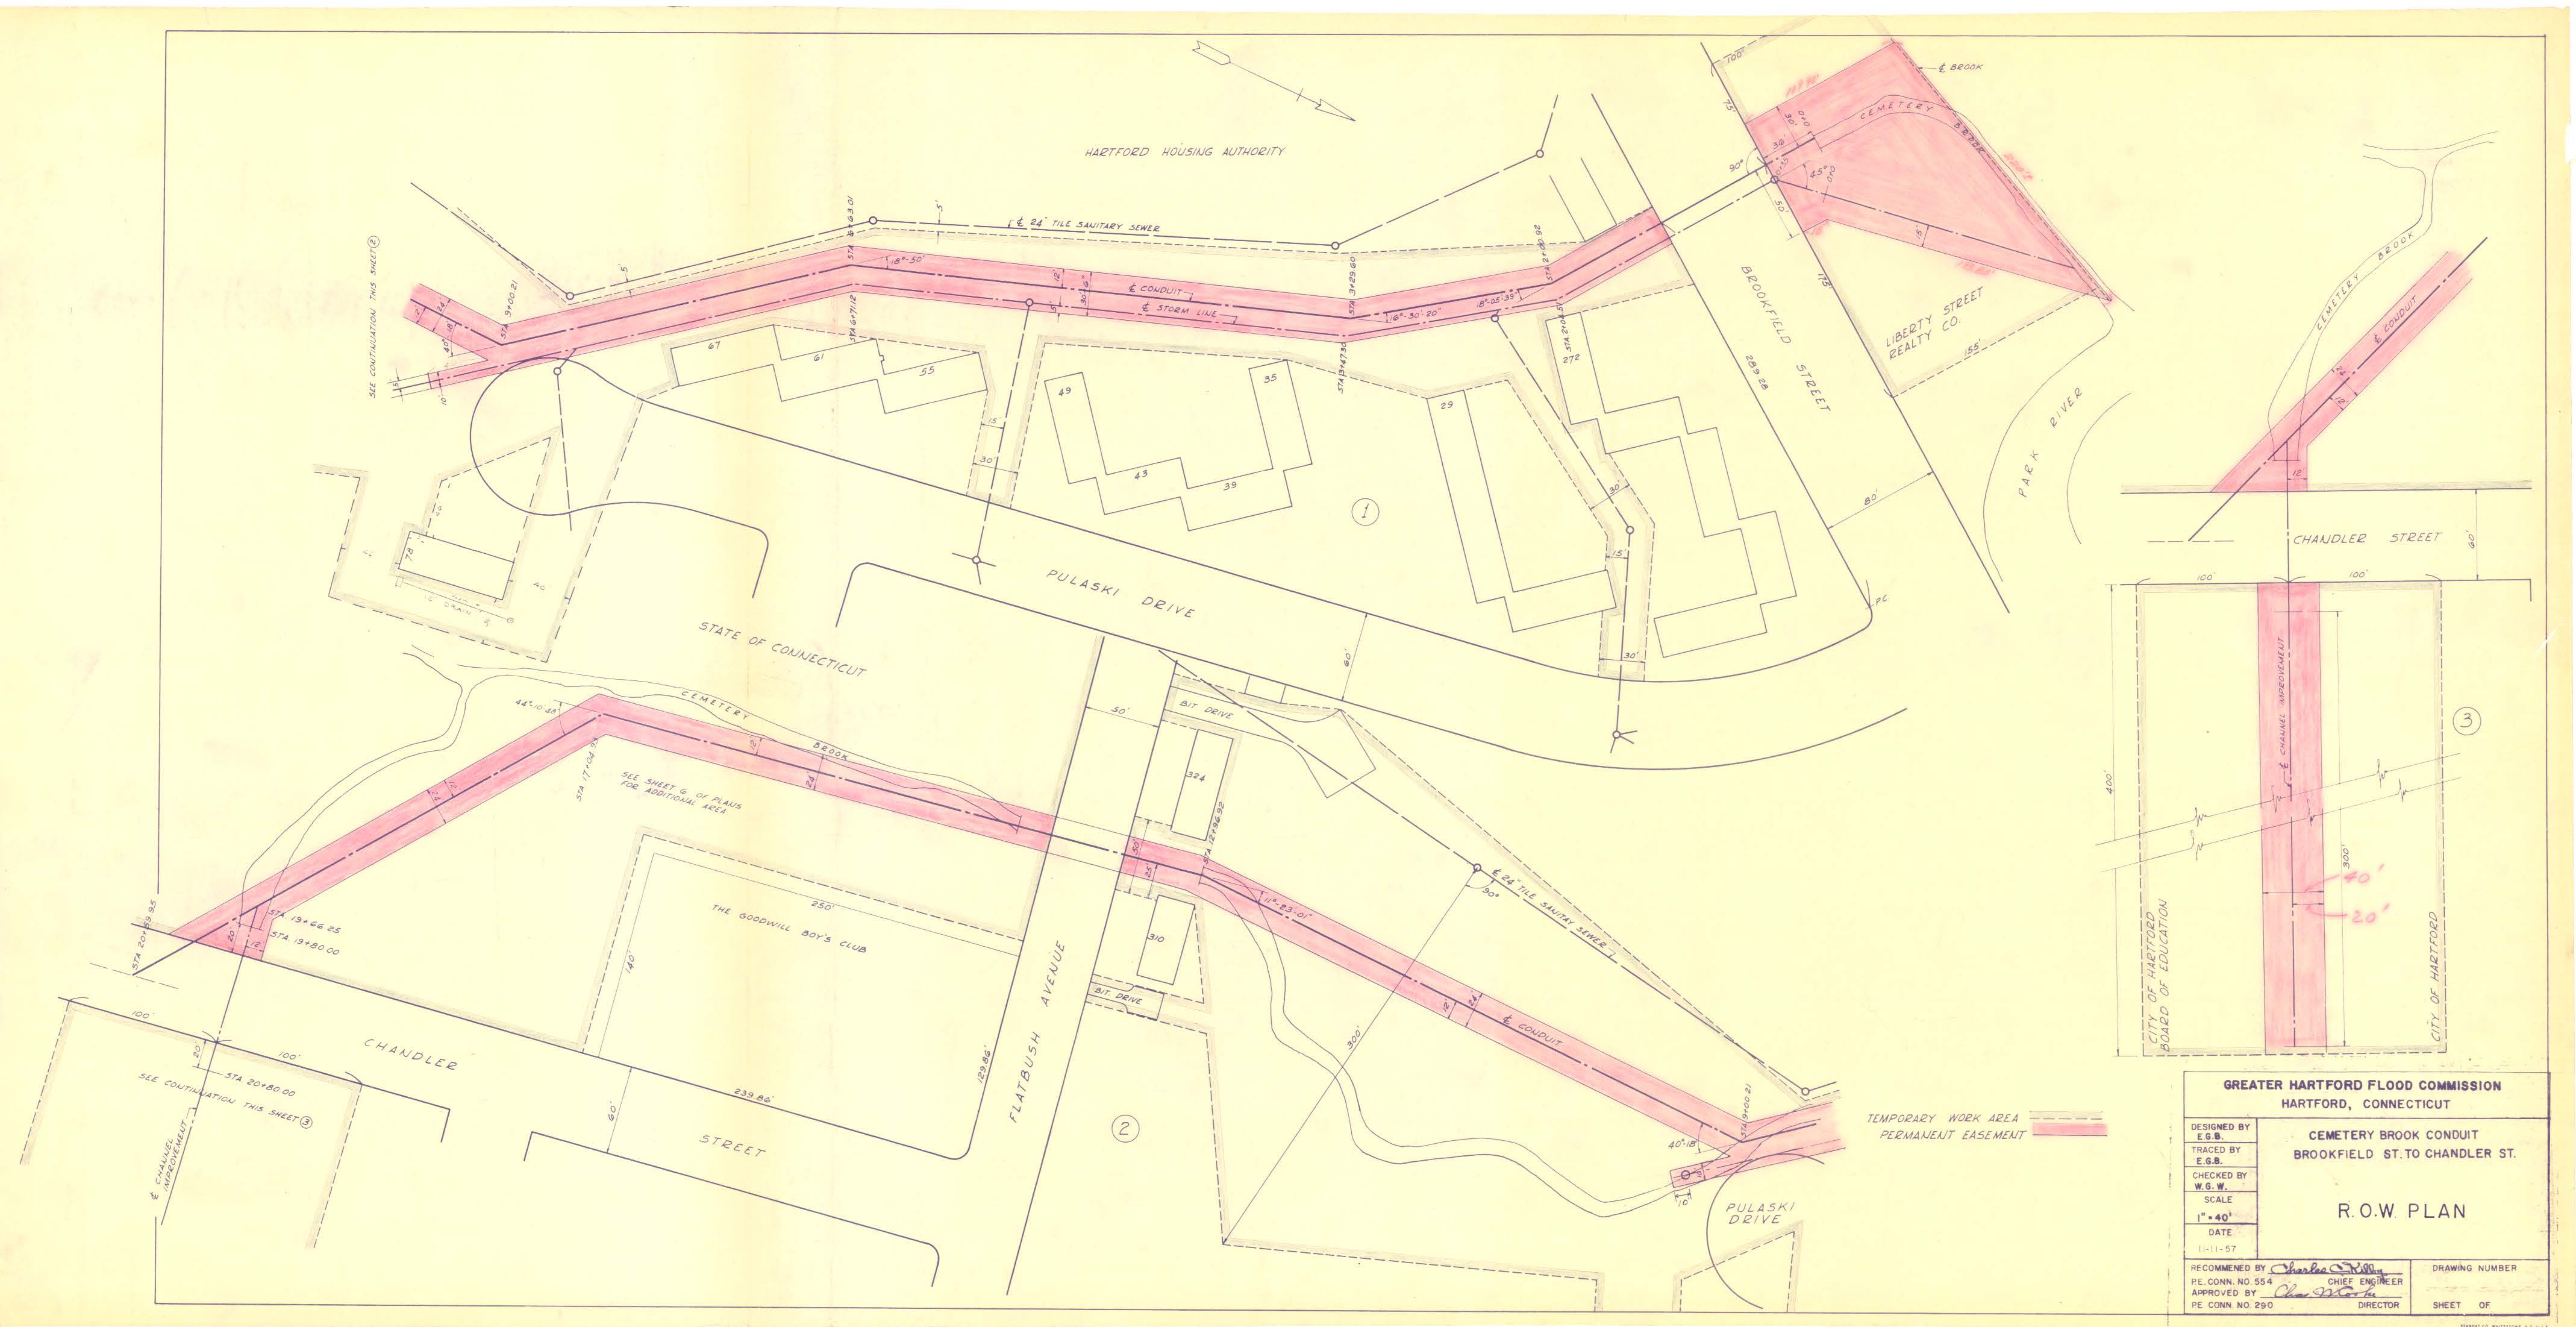

TEMPORARY WORK AREA
PERMANENT EASEMENT

GREATER HARTFORD FLOOD COMMISSION HARTFORD, CONNECTICUT			
DESIGNED BY E.G.B.	CEMETERY BROOK CONDUIT BROOKFIELD ST. TO CHANDLER ST.		
TRACED BY E.G.B.			
CHECKED BY W.S.W.			
SCALE 1" = 40'			
DATE 11-11-57	R.O.W. PLAN		
RECOMMENDED BY P.E. CONN. NO. 554	CHARLES R. KELLY CHIEF ENGINEER	DRAWING NUMBER	
APPROVED BY P.E. CONN. NO. 290	CHAS. W. KELLY DIRECTOR	SHEET OF	