


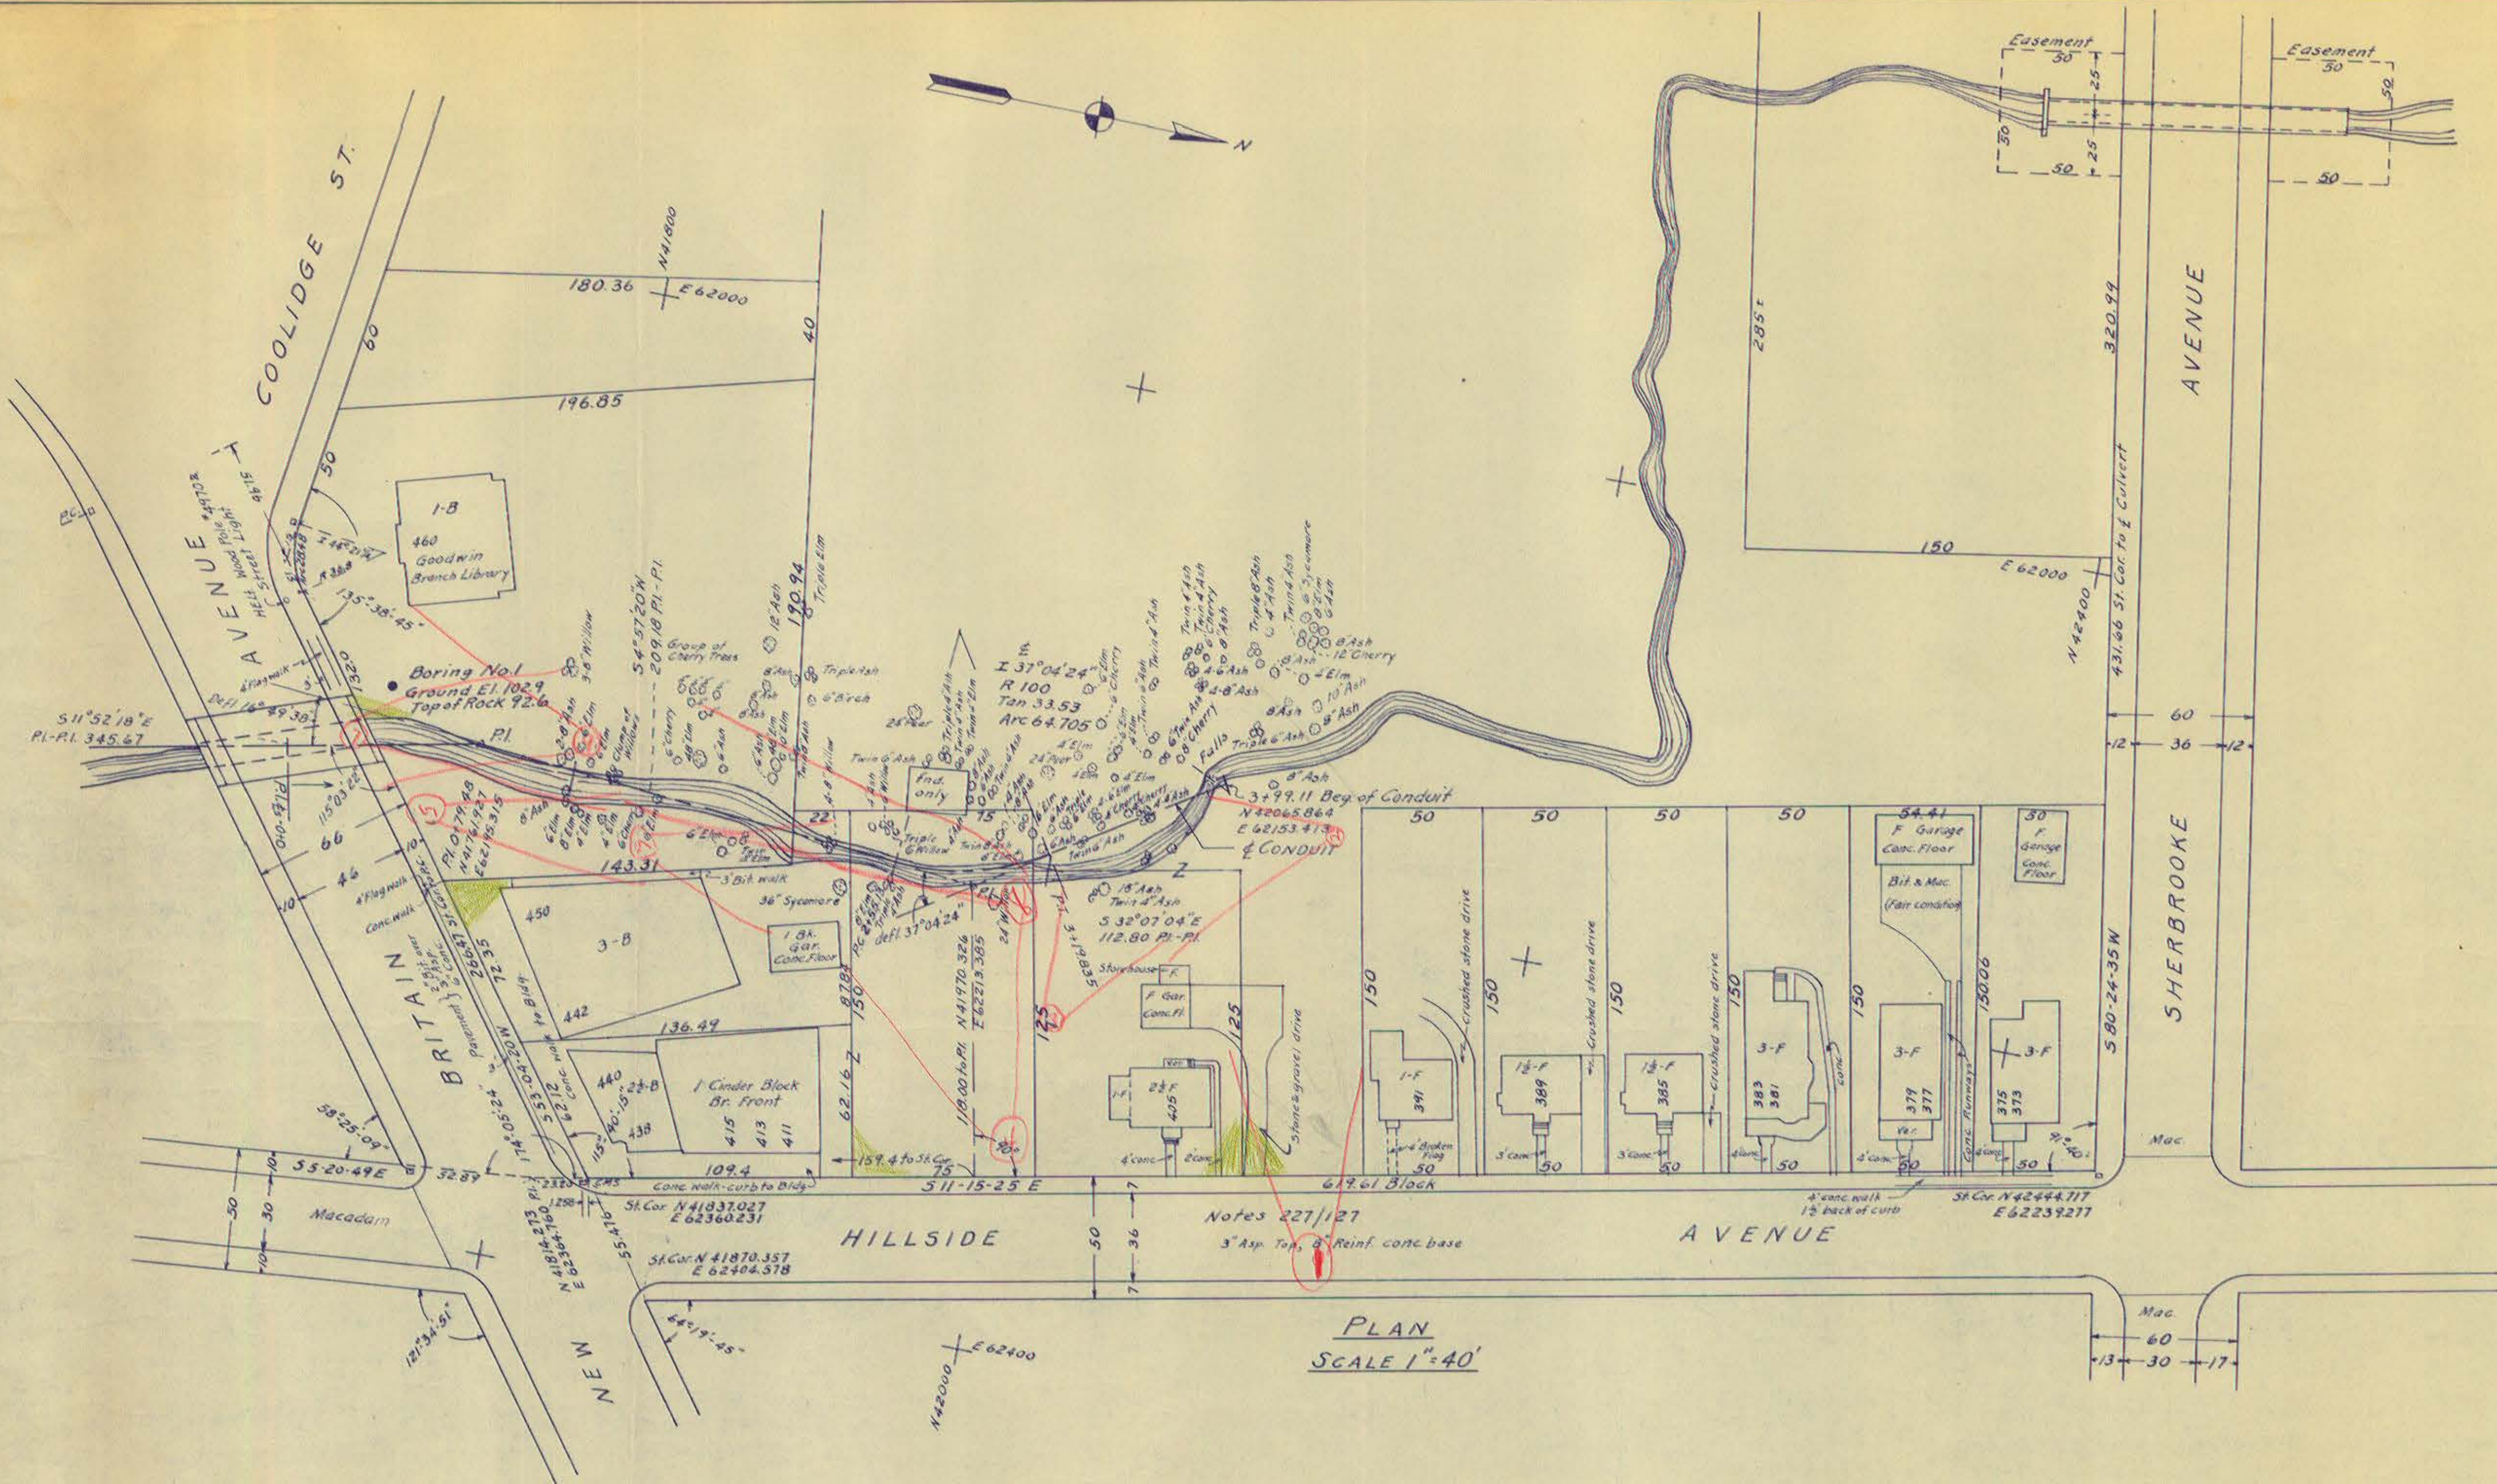

PLAN  
SCALE 1"=40'

CITY OF HARTFORD, CONNECTICUT  
DEPARTMENT OF ENGINEERING

CEMETERY BROOK CONDUIT

G.H.F.C. Serial No. 000540

|                   |                 |                   |
|-------------------|-----------------|-------------------|
| SUBMITTED         | RECOMMENDED     | APPROVED          |
| DIVISION ENGINEER | ASST. CITY ENG. | CITY ENGINEER     |
| DESIGN            | DRAWN           | DAYBOOK NO. 09430 |
| TRACED            | CHECK           | DATE              |

Revision of Dec. 1956 - Trees adjacent to brook plotted

Revision of Oct. 1956 - Driveways and entrance walks plotted