


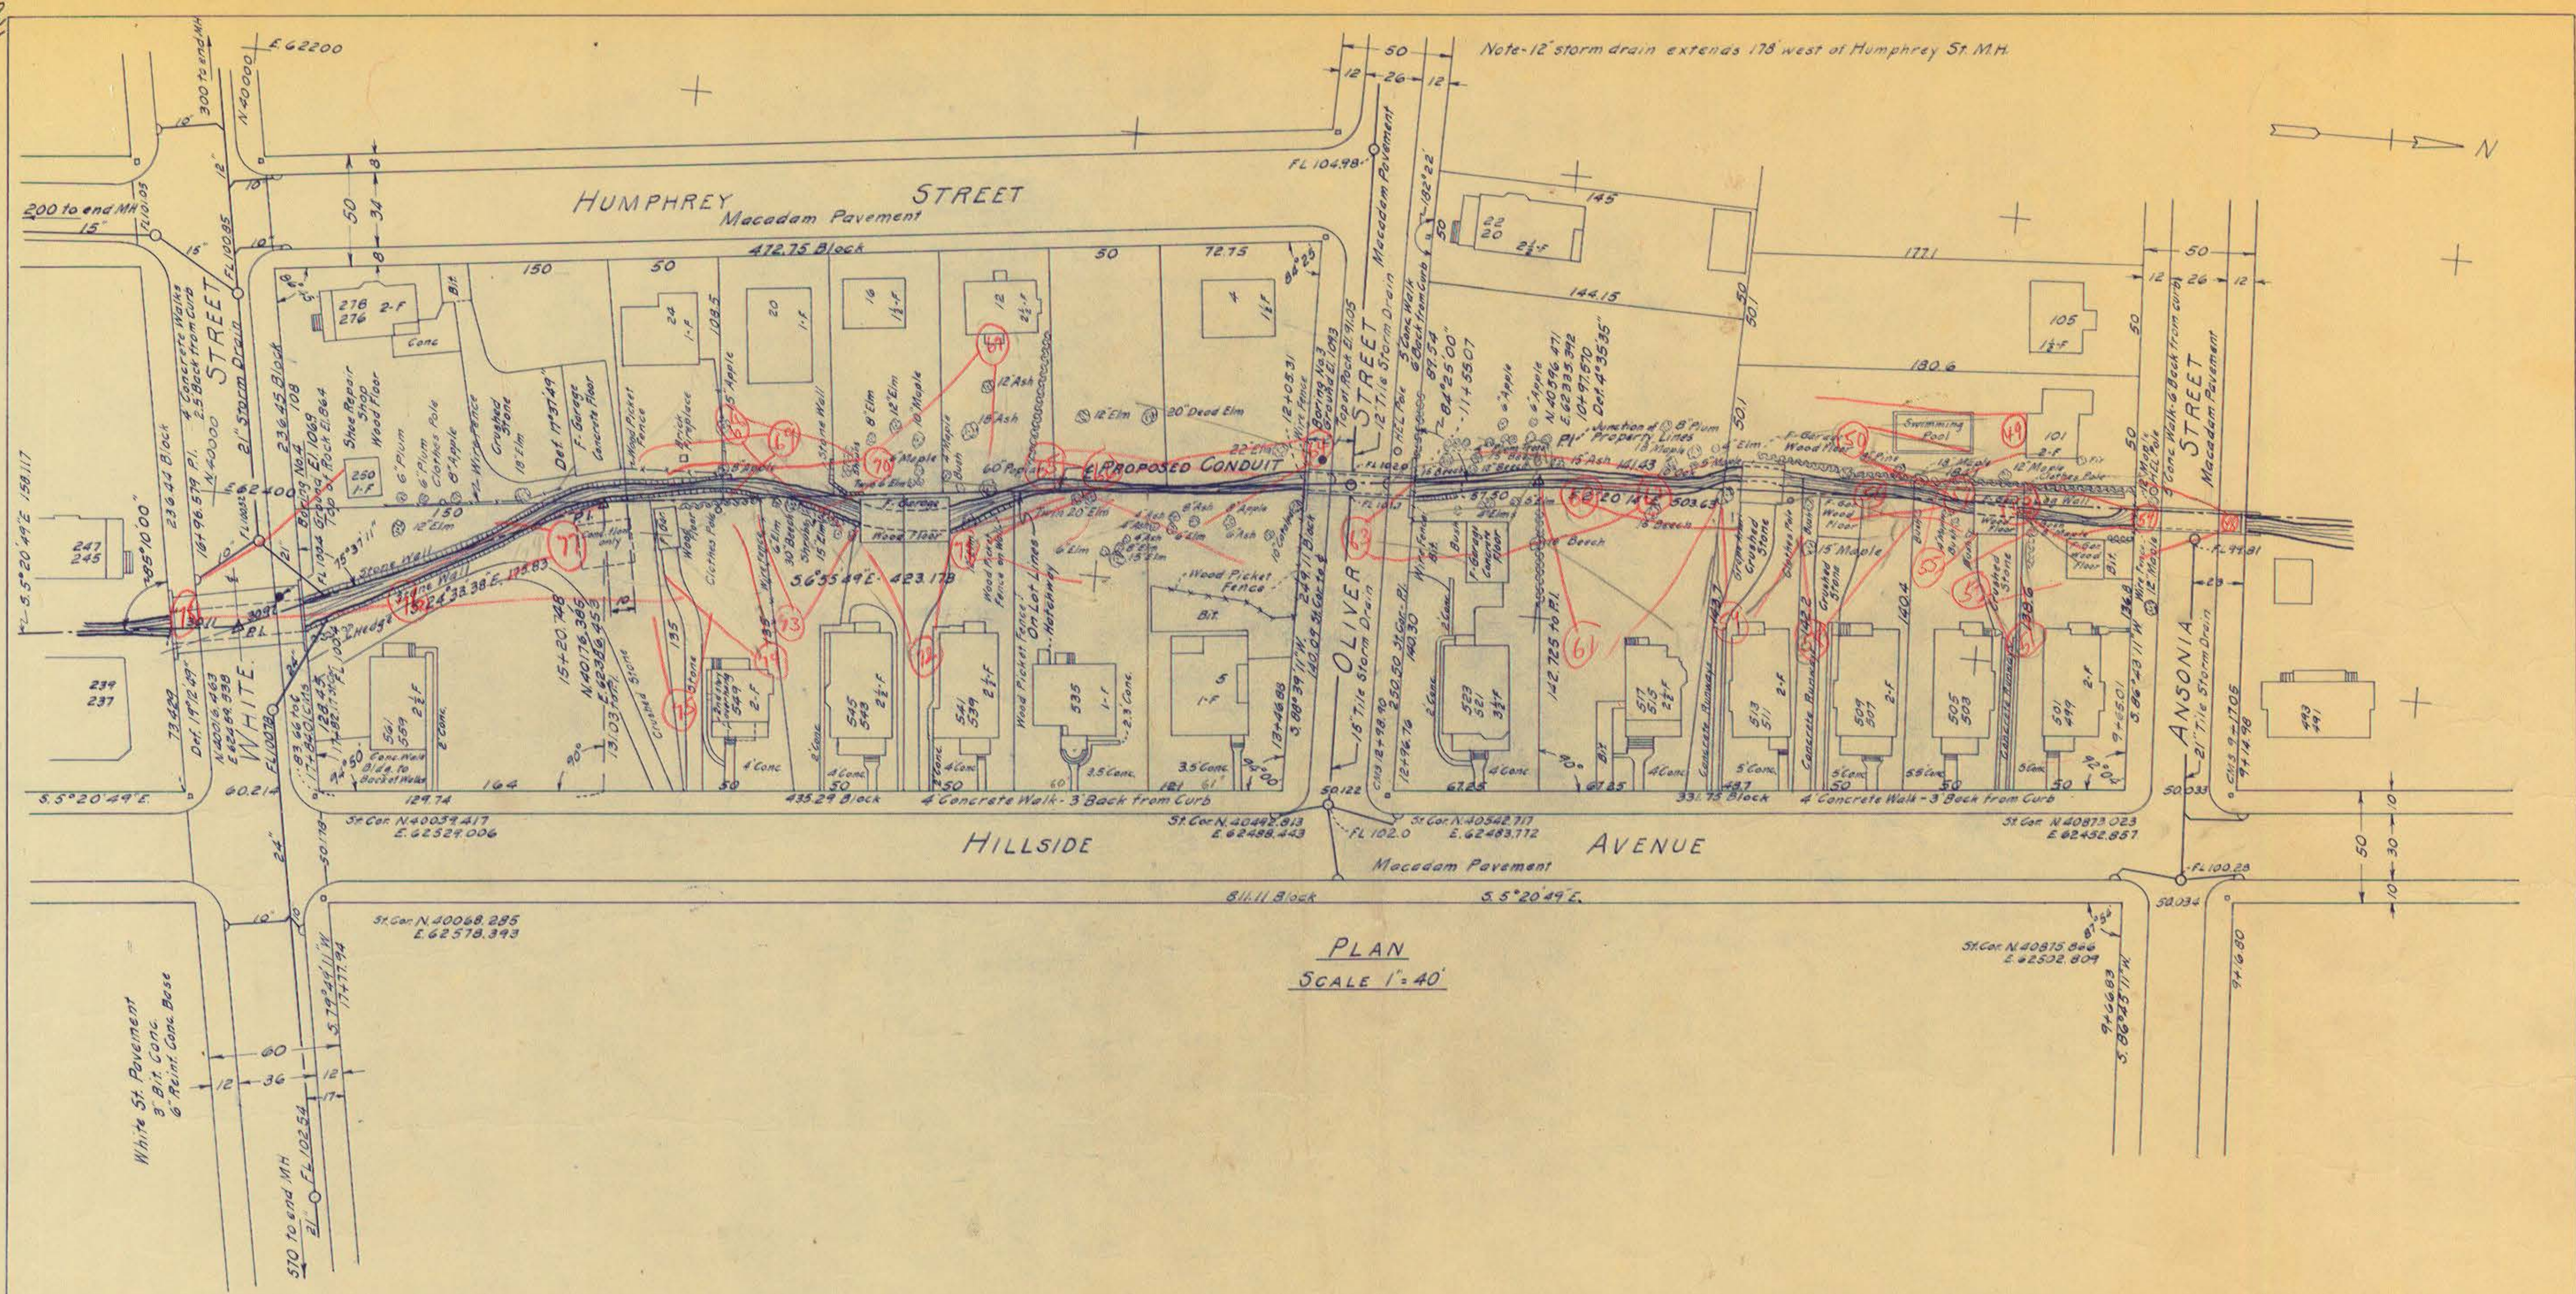

PLAN
SCALE 1"=40'

Revision of October, 1956 - Entrance walks and driveways plotted

SHEET 3 OF

CITY OF HARTFORD, CONNECTICUT DEPARTMENT OF ENGINEERING		
CEMETERY BROOK CONDUIT G.H.F.C. Serial No. 000519		
SUBMITTED	RECOMMENDED	APPROVED
DIVISION ENGINEER	ASST. CITY ENG.	CITY ENGINEER
DESIGN	DRAWN	DAYBOOK NO. 09430
TRACED	CHECK	DATE