


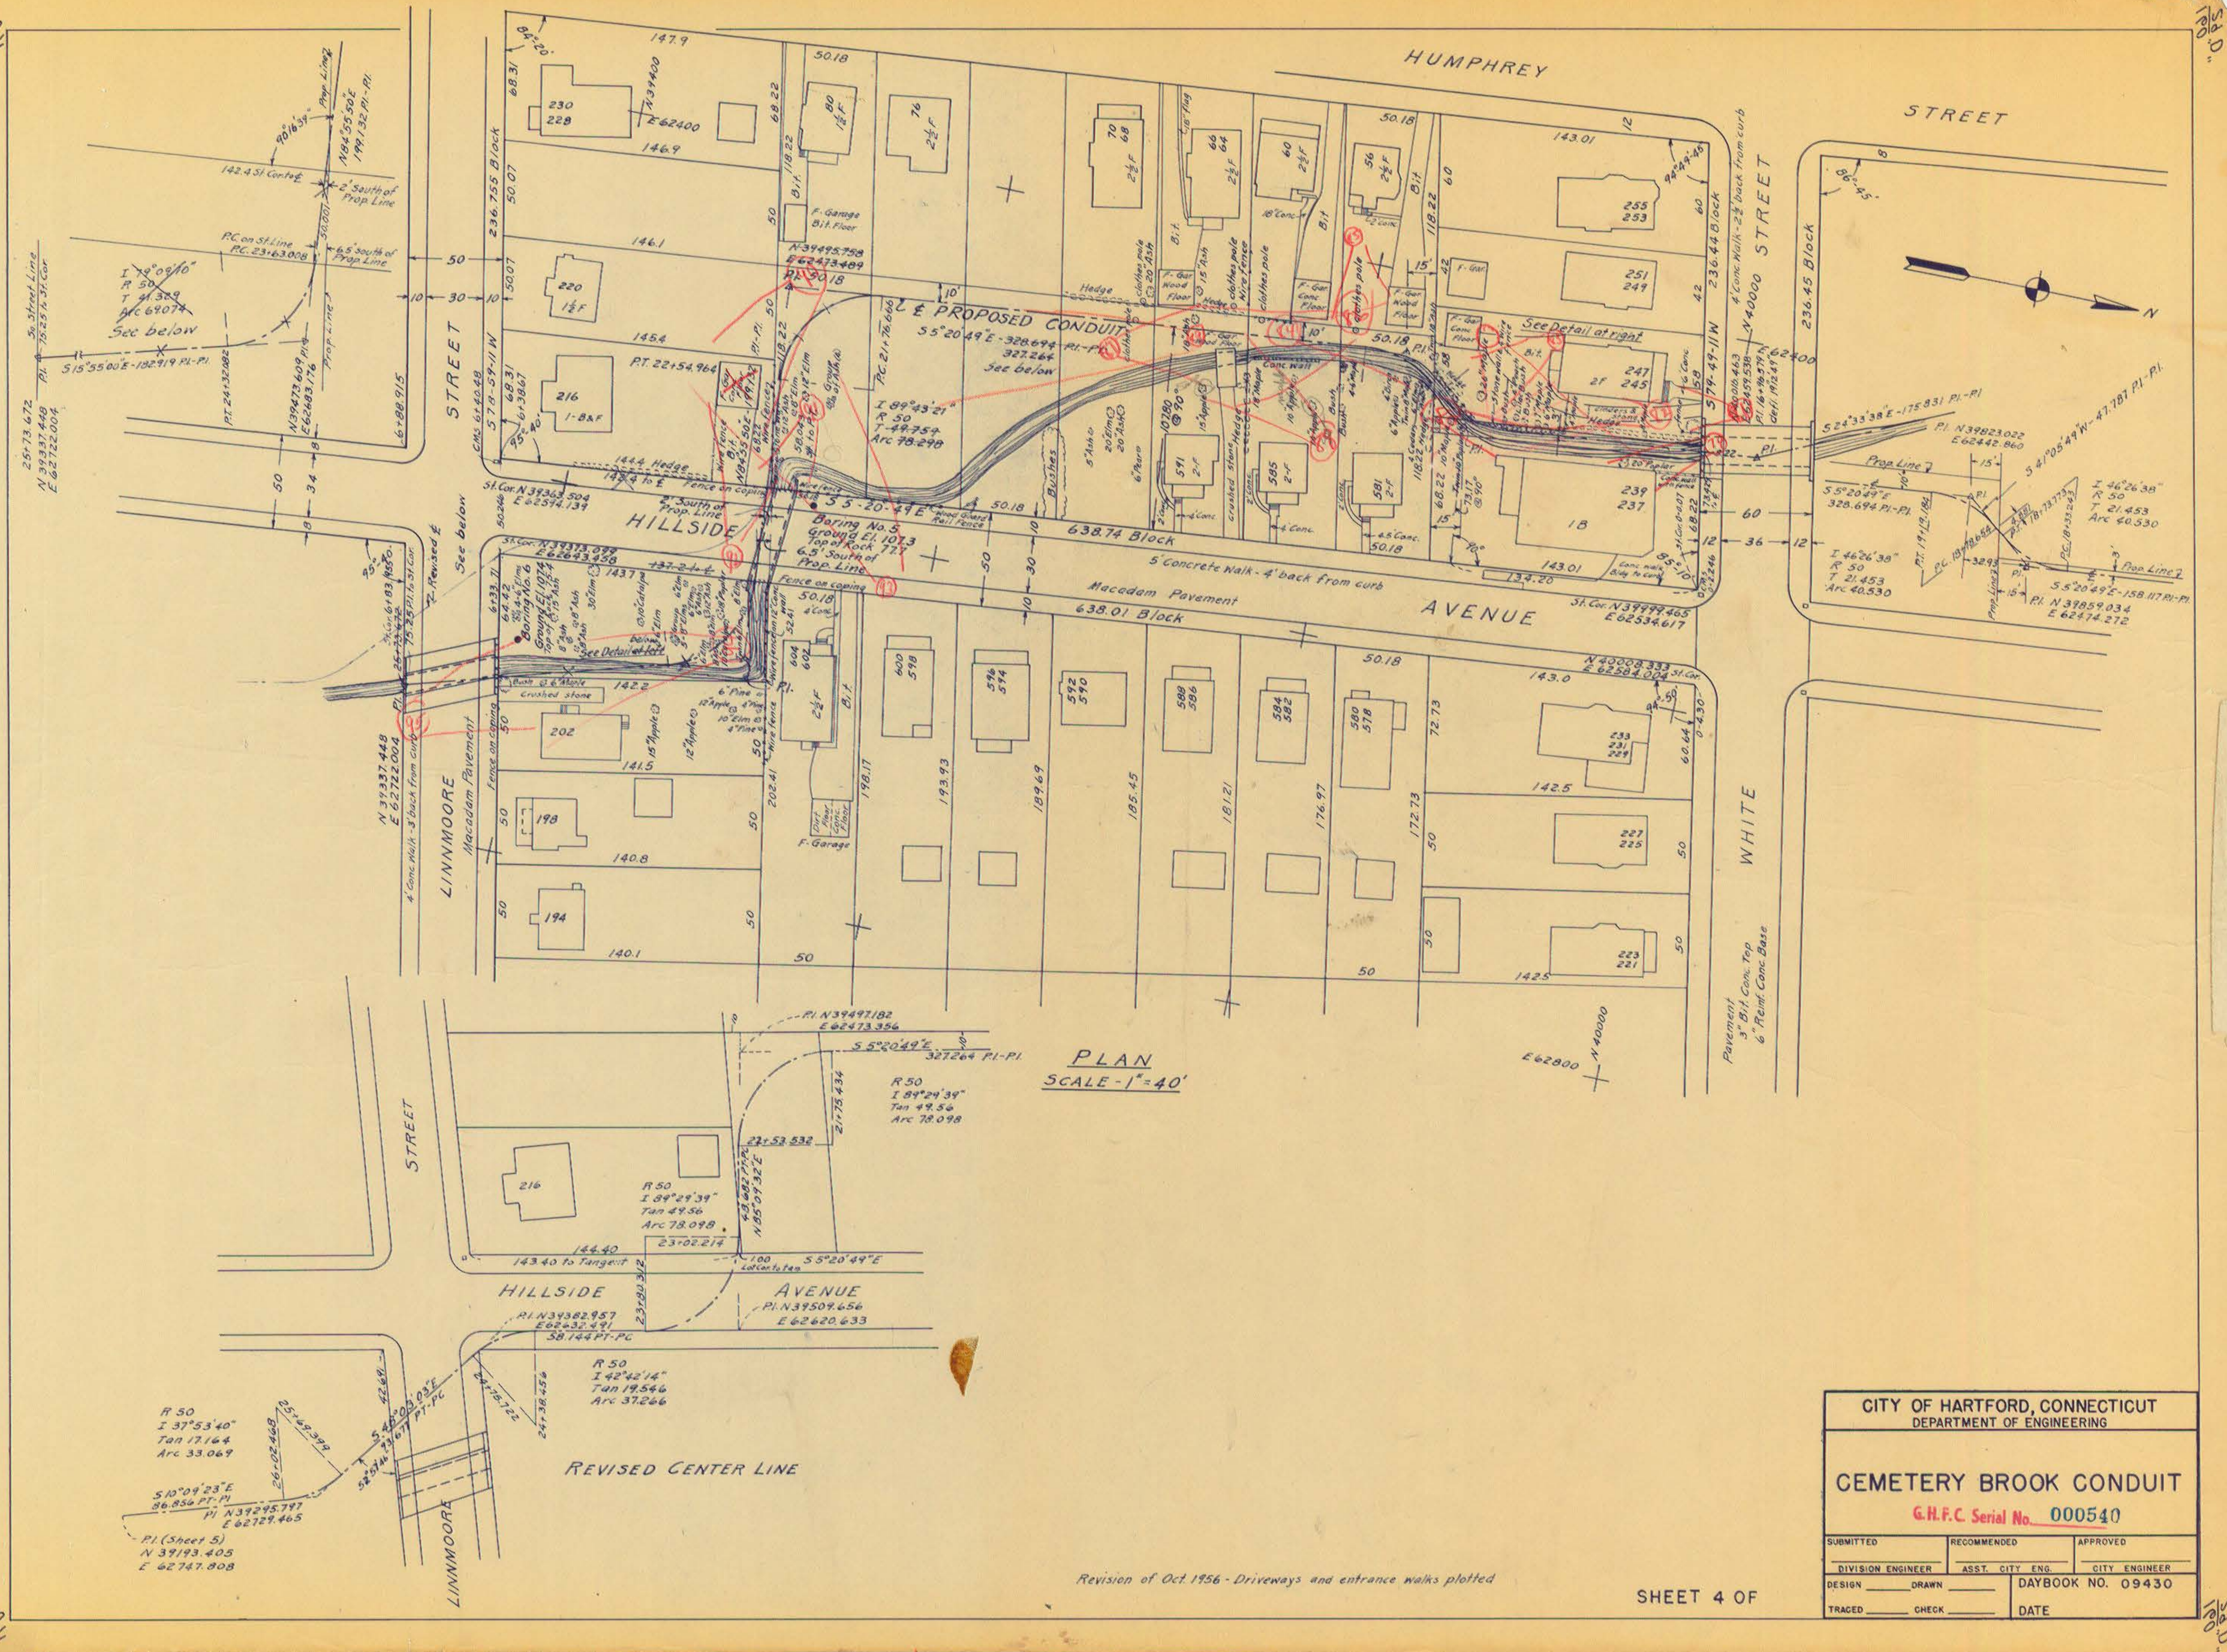

CITY OF HARTFORD, CONNECTICUT DEPARTMENT OF ENGINEERING		
CEMETERY BROOK CONDUIT		
G.H.F.C. Serial No. 000540		
SUBMITTED	RECOMMENDED	APPROVED
DESIGN	ASST. CITY ENG.	CITY ENGINEER
DRAWN	DAYBOOK NO. 09430	
TRACED	CHECK	DATE