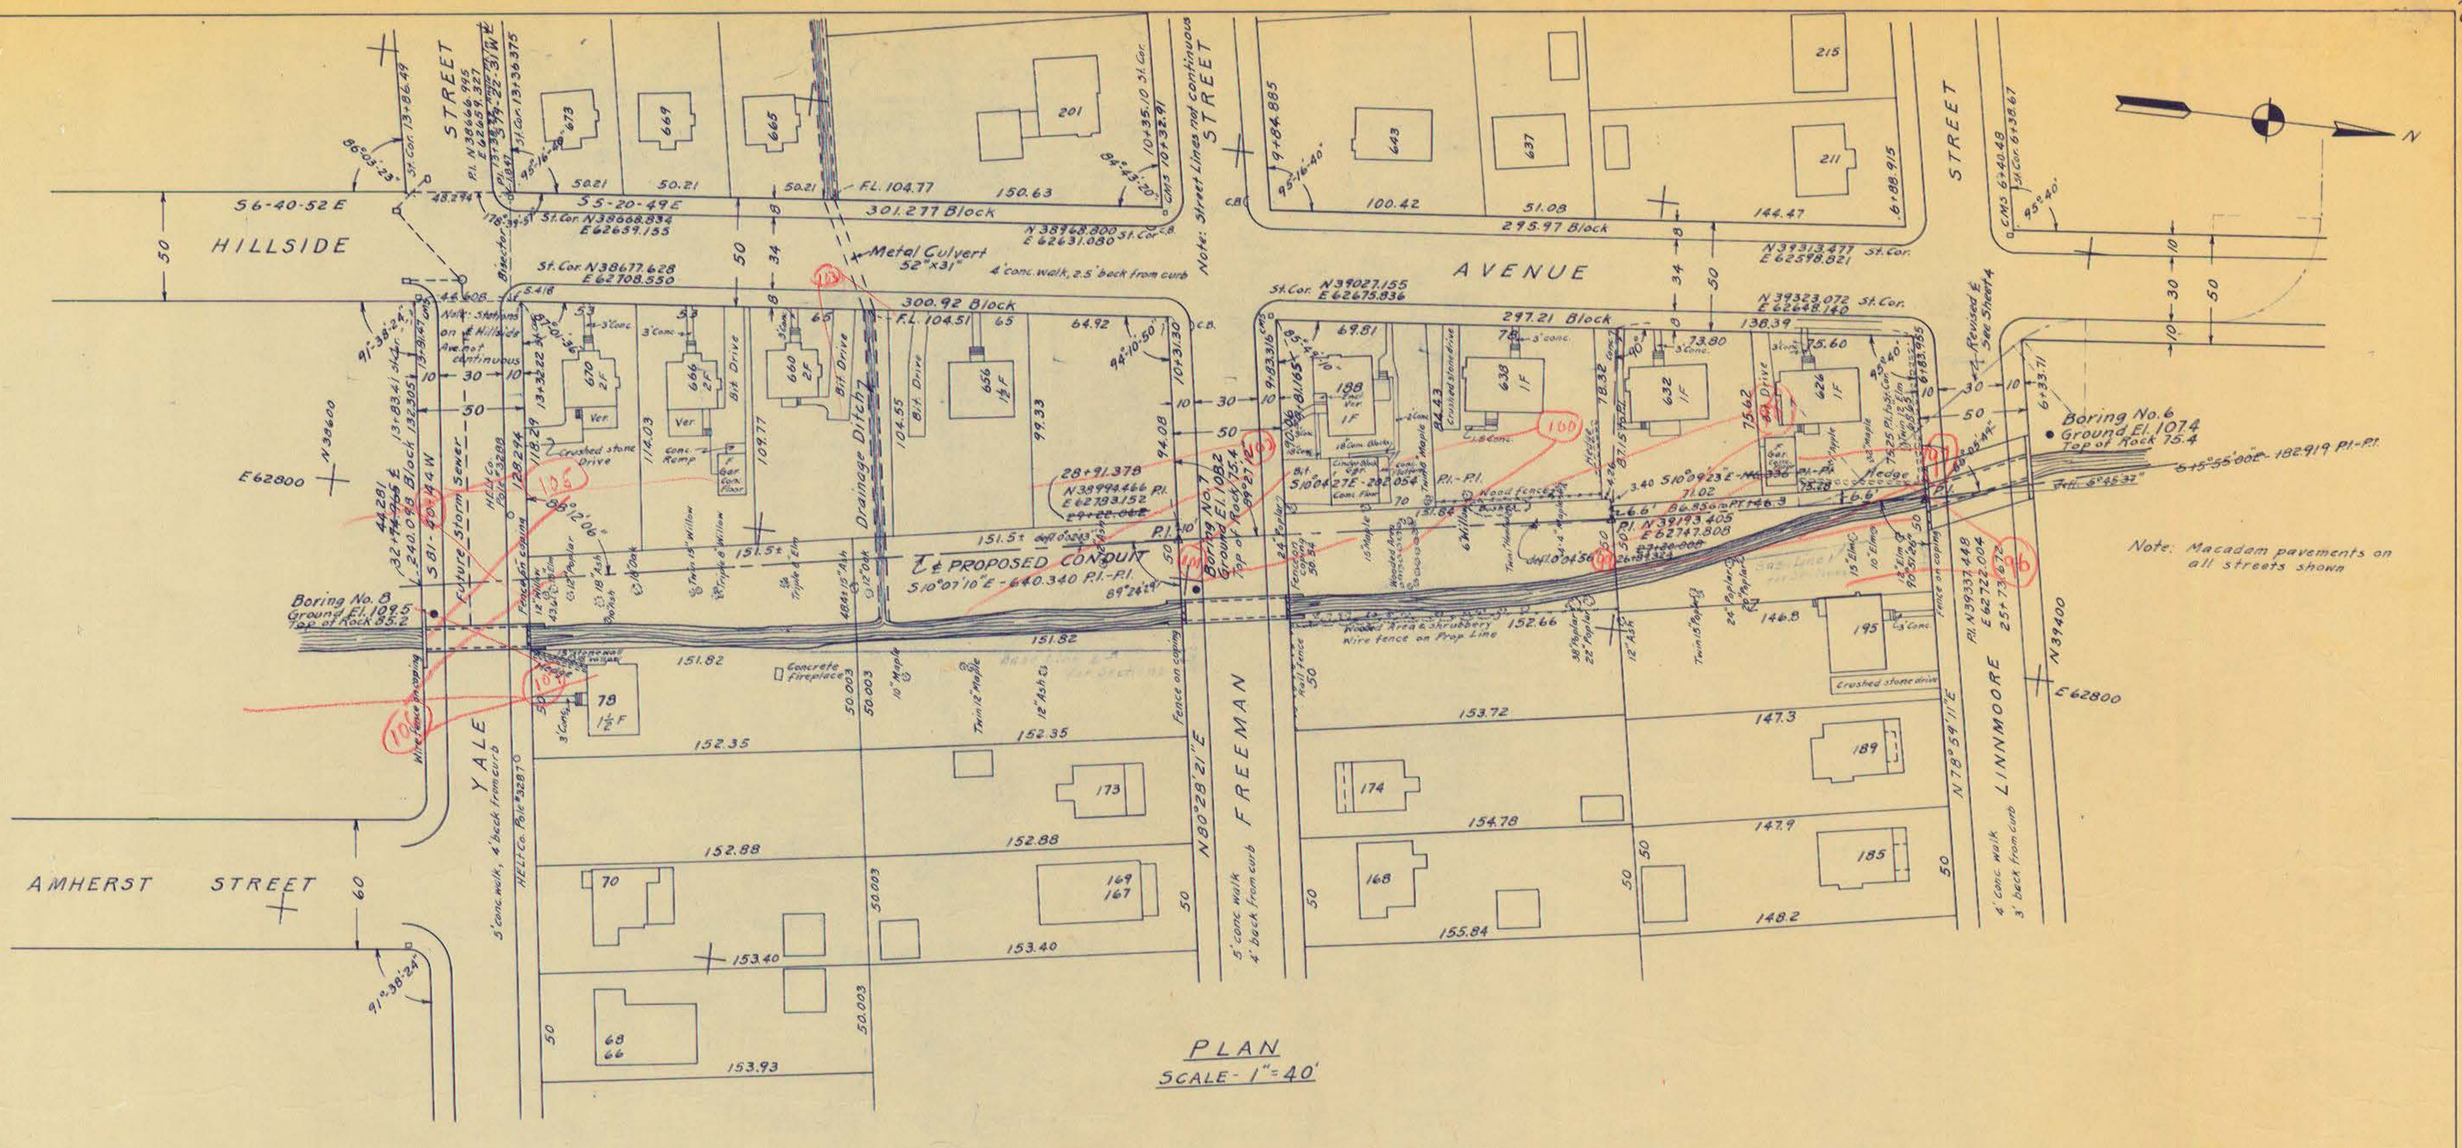

PLAN
SCALE - 1" = 40'

Revision of Oct. 1956 - Driveways and entrance walks plotted

Revision - Stations revised to conform with center line change - Sept. 1956

SHEET 5 OF

CITY OF HARTFORD, CONNECTICUT
DEPARTMENT OF ENGINEERING

CEMETERY BROOK CONDUIT

G.H.F.C. Serial No. 000540

SUBMITTED	RECOMMENDED	APPROVED
DIVISION ENGINEER	ASST. CITY ENG.	CITY ENGINEER

DESIGN _____ DRAWN _____ DAYBOOK NO. 09430

TRACED _____ CHECK _____ DATE