


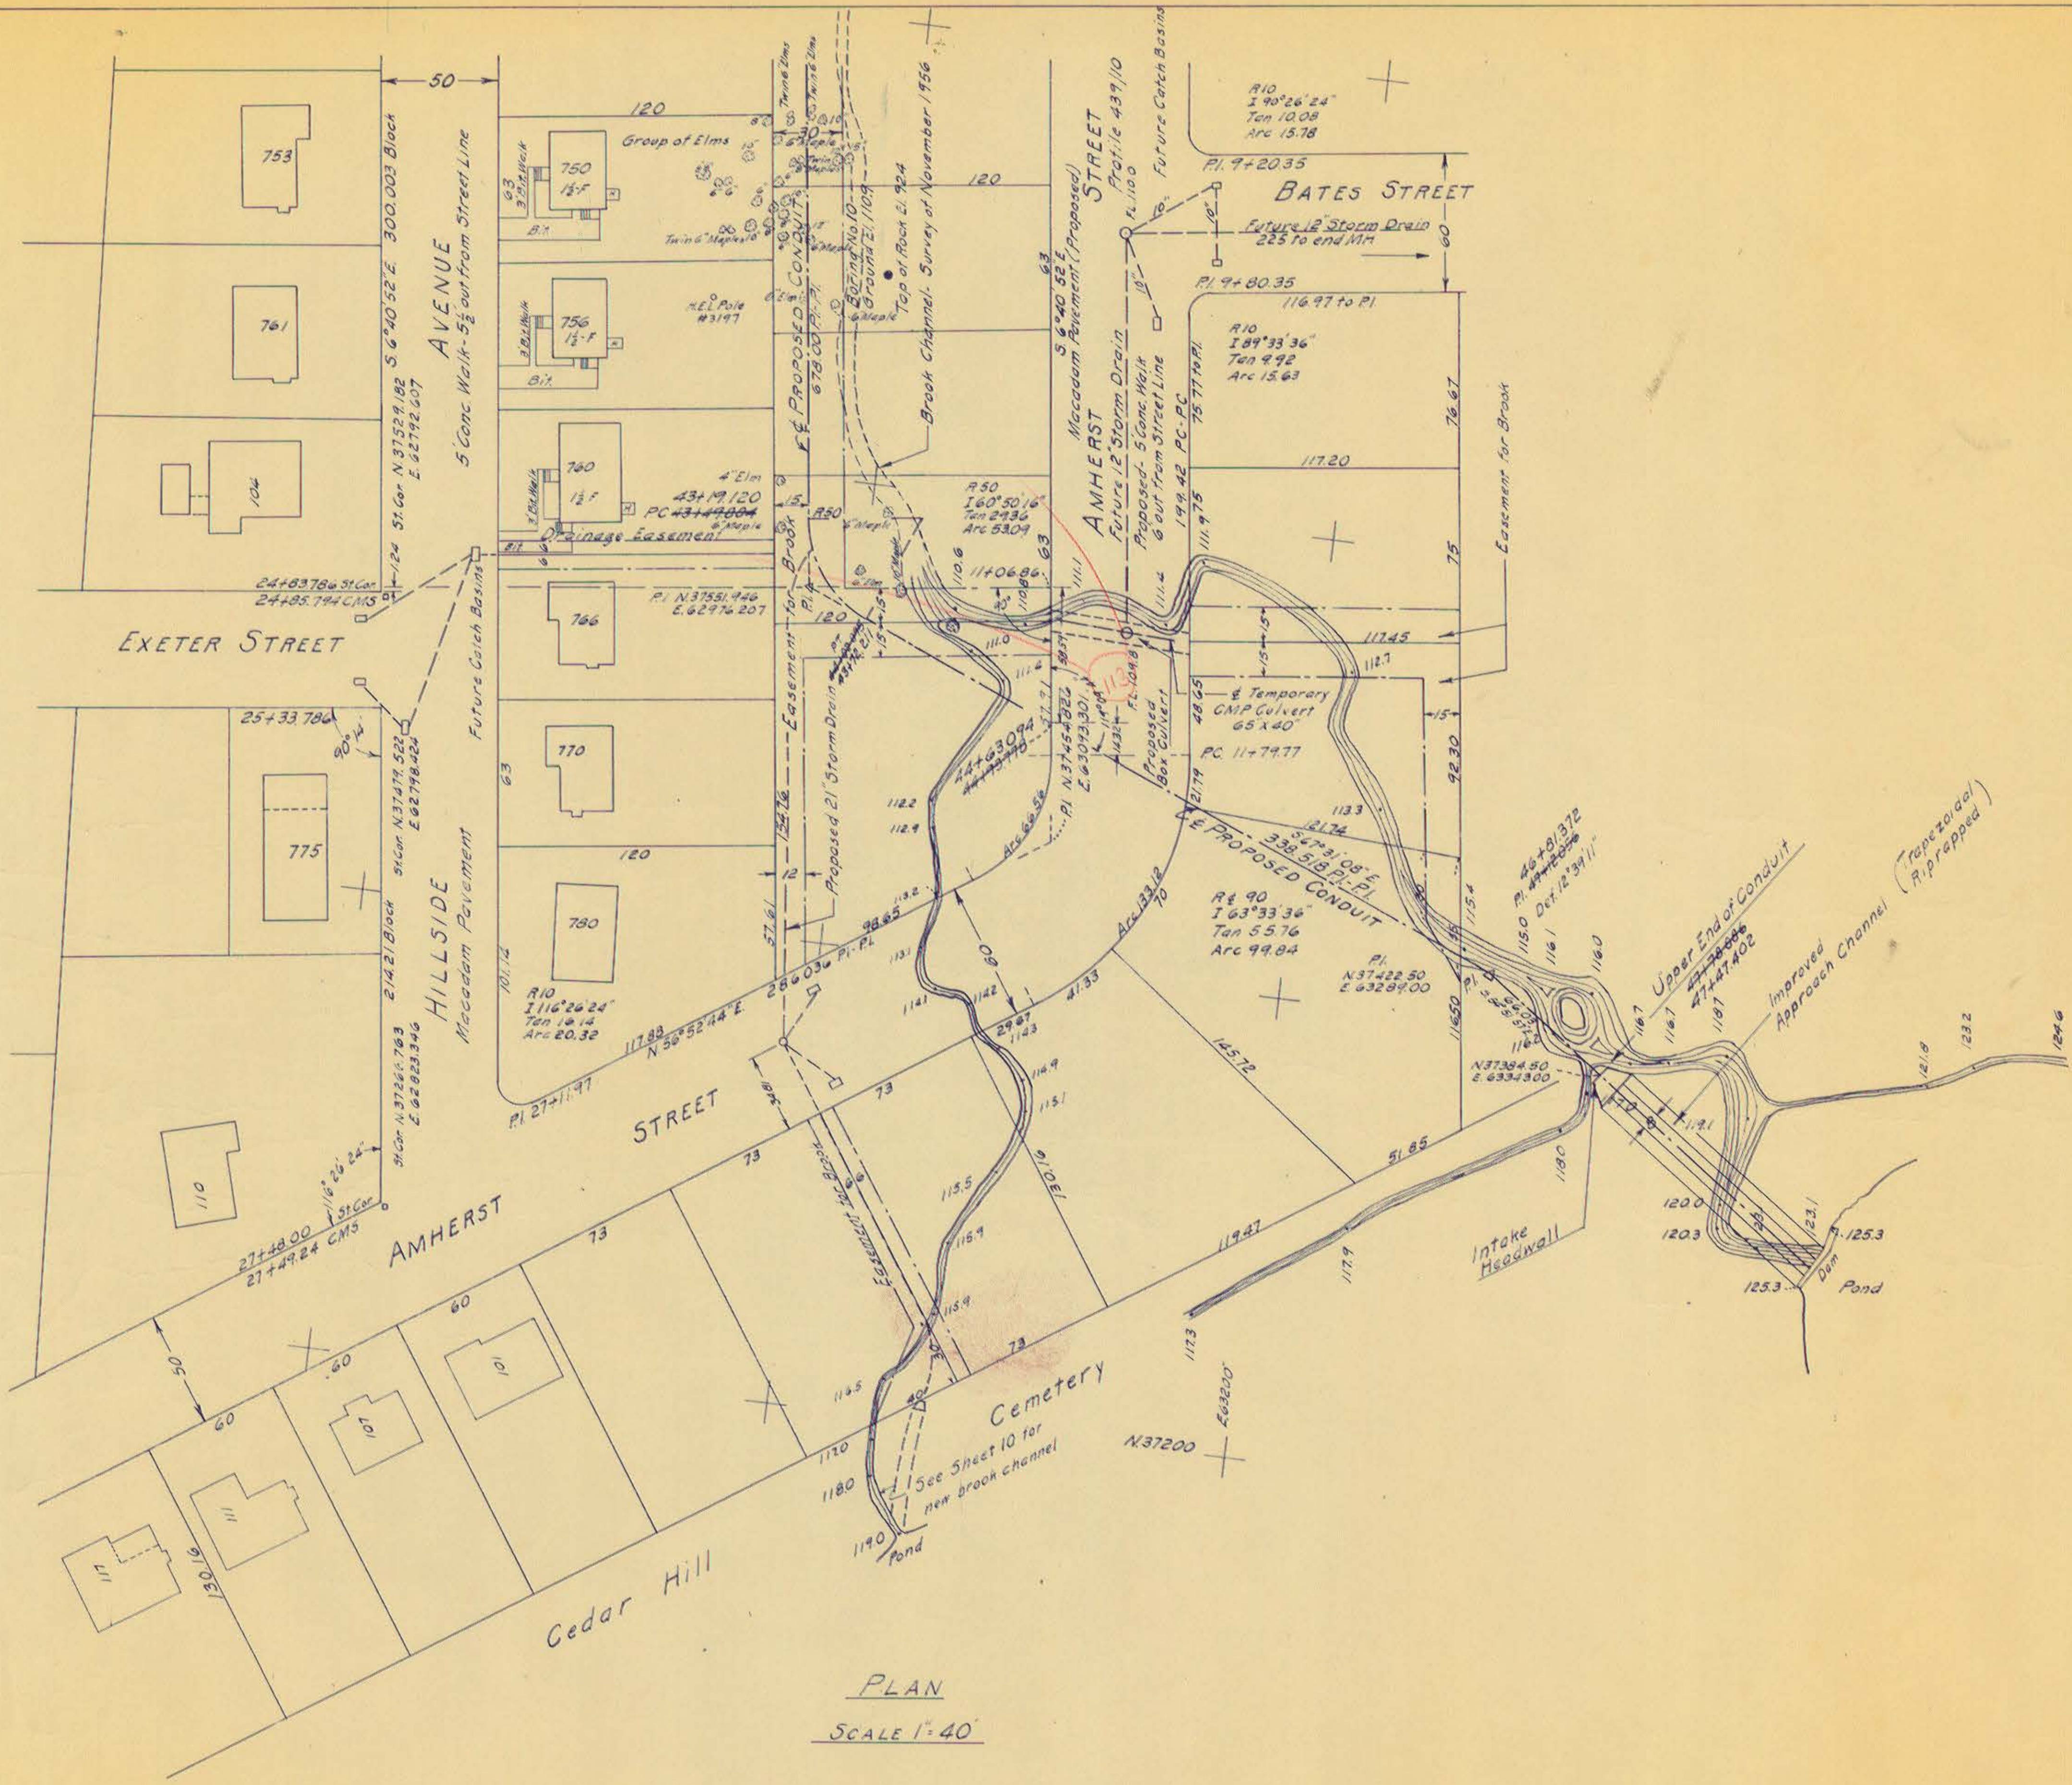

PLAN
SCALE 1"=40'

Revision of November, 1956 - Change in brook channel plotted
Revision of October, 1956 - Entrance walks, driveways, and trees plotted
Revision of September, 1956 - Stations revised to conform with center line change at Linnmoors St.

CITY OF HARTFORD, CONNECTICUT DEPARTMENT OF ENGINEERING		
CEMETERY BROOK CONDUIT		
G.H.F.C. Serial No. 000540		
SUBMITTED	RECOMMENDED	APPROVED
DIVISION ENGINEER	ASST. CITY ENG.	CITY ENGINEER
DESIGN	DRAWN	DAYBOOK NO. 09430
TRACED	CHECK	DATE