


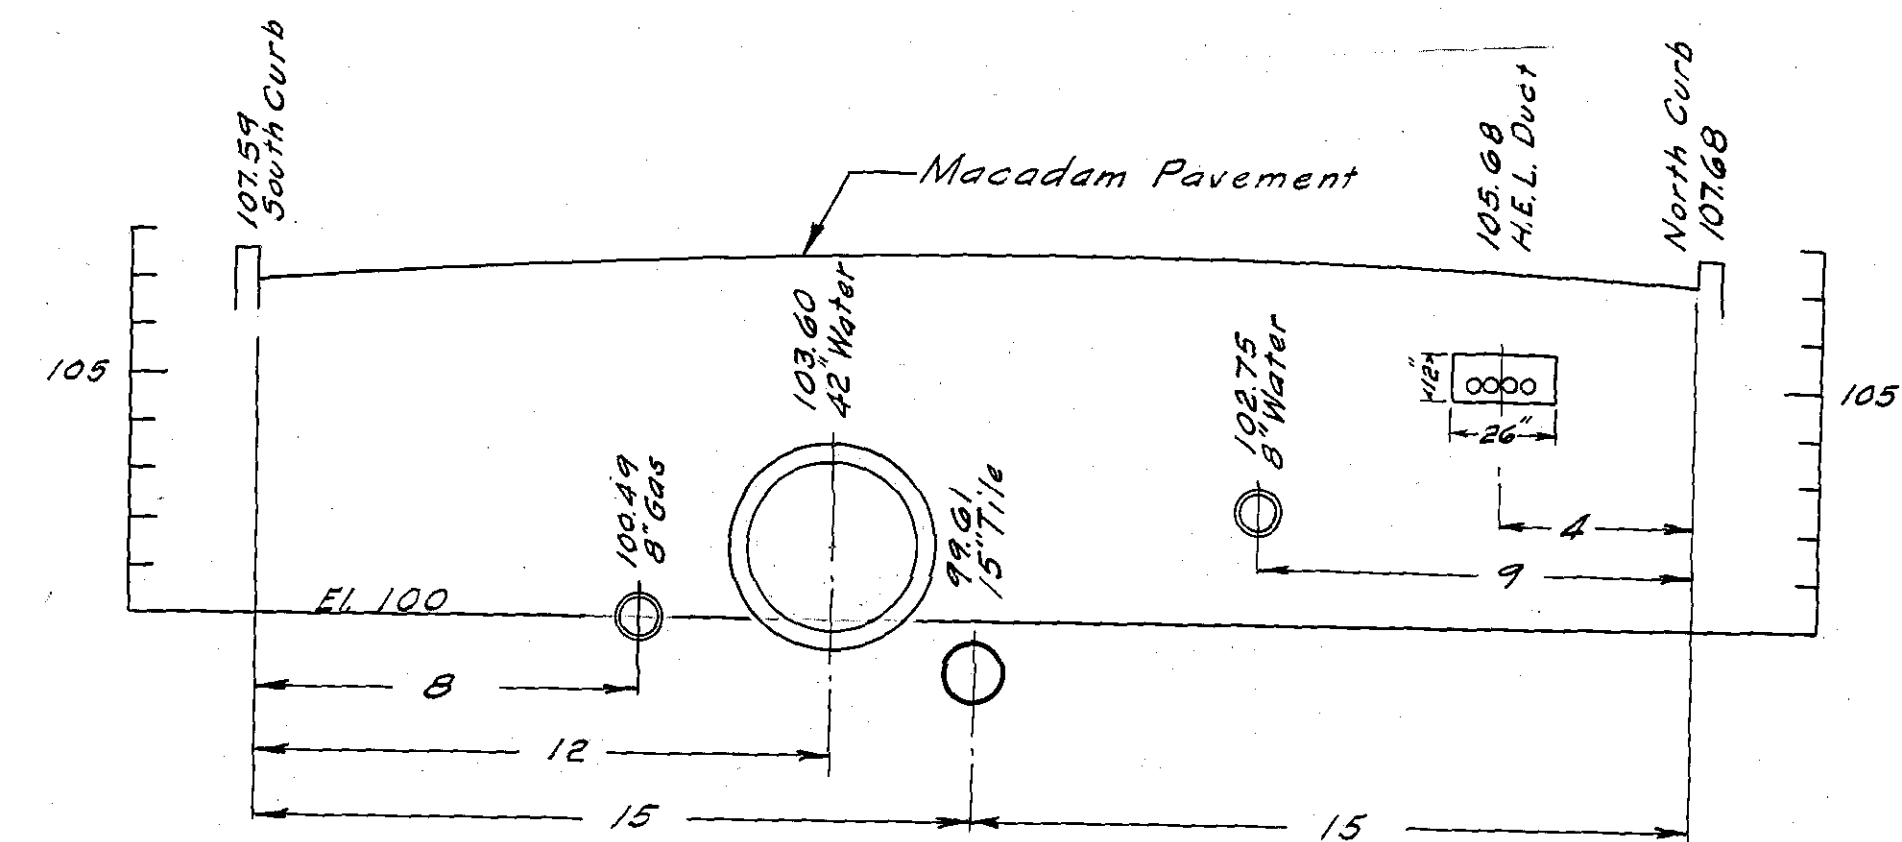

SECTION AT TEST PIT

SCALE - $\frac{1}{4}'' = 1'$

CITY OF HARTFORD, CONNECTICUT DEPARTMENT OF ENGINEERING		
CEMETERY BROOK CONDUIT		
SUBMITTED _____ DIVISION ENGINEER _____	RECOMMENDED _____ ASST. CITY ENG. _____	APPROVED _____ CITY ENGINEER _____
DESIGN _____ DRAWN _____	DAYBOOK NO. 09430 _____	
TRACED _____ CHECK _____	DATE JULY 1956 _____	