


ALBANY AVENUE

WALNUT STREET

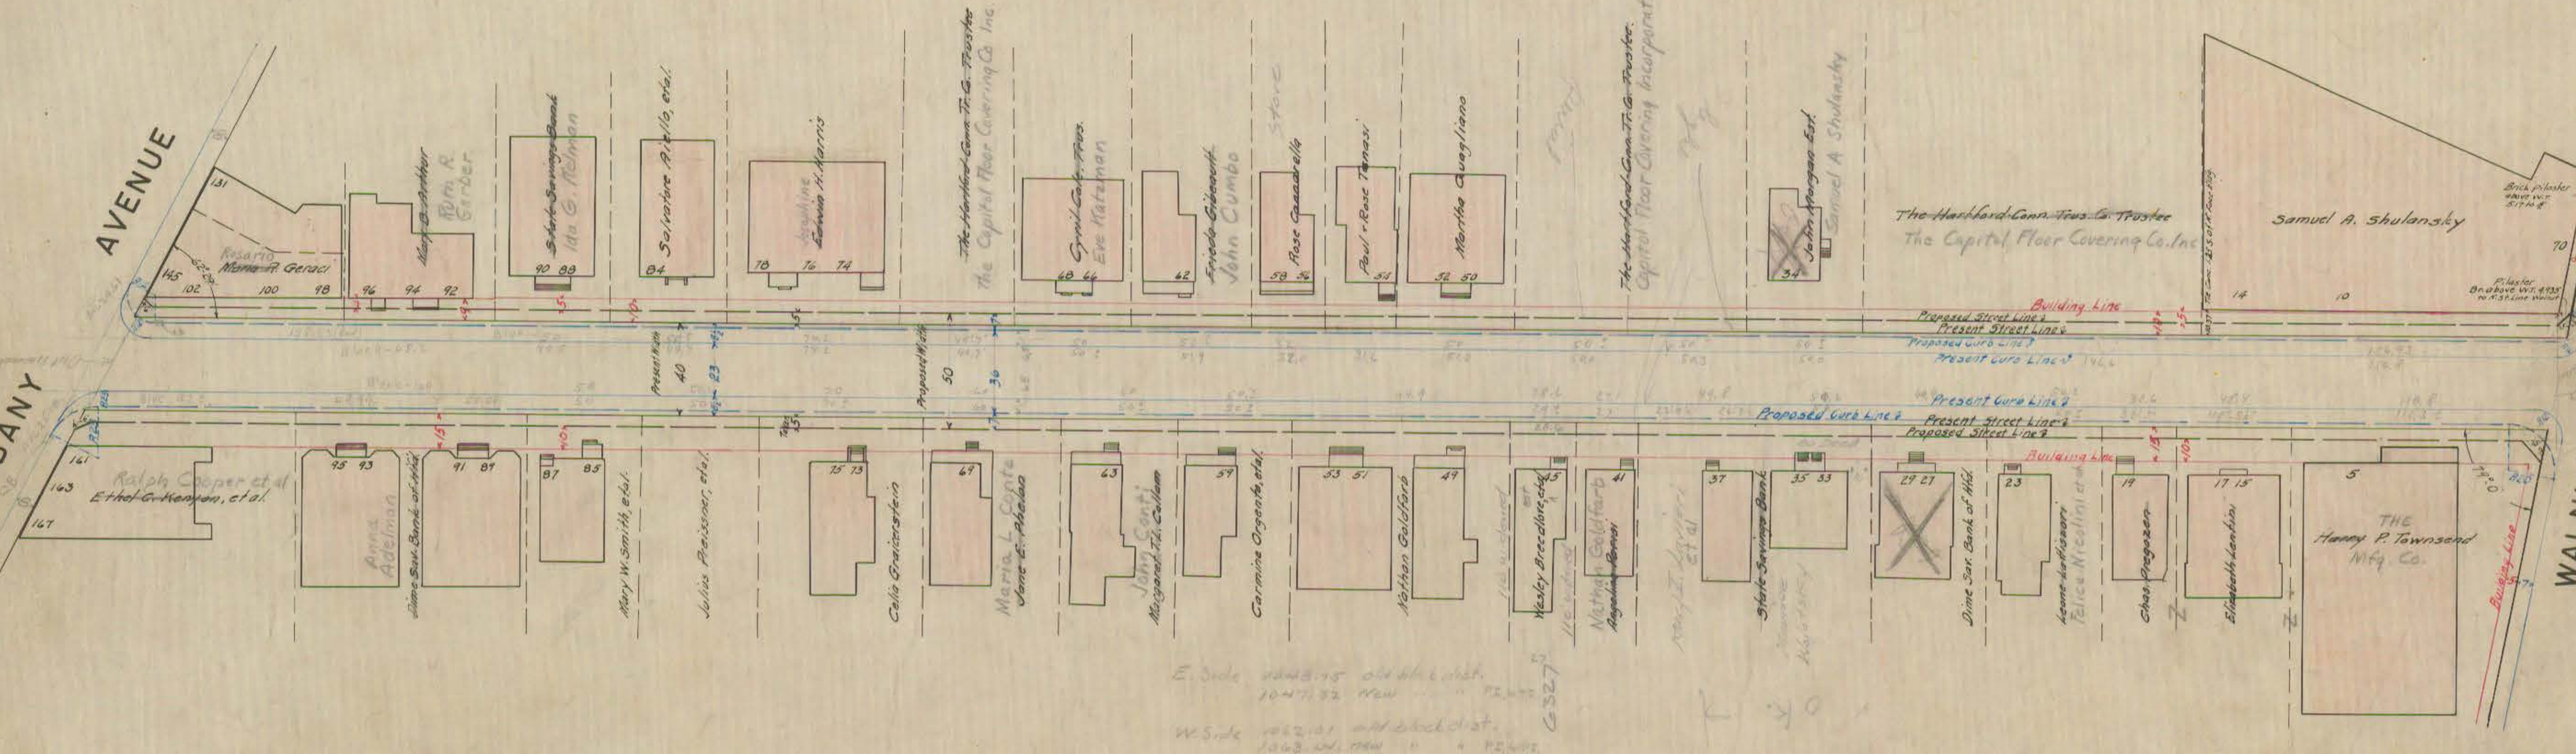

E. Side 1042.15 old block dist.
1047.82 new " " " "
W. Side 1042.01 old block dist.
1043.04 new " " " "

For ties to St. Line See N.B. 373 P. 102-3

DEPT. OF ENGINEERING, HARTFORD CONN.		
ROBERT J. ROSS, CITY ENGINEER		
CHESTNUT STREET		
WIDENING PLAN		
SCALE 1" = 40'		
CERTIFIED 10-10-1940 DIVISION ENG.	SUBMITTED 10-10-1940 ASST. CITY ENG.	APPROVED 10-10-1940 CITY ENGINEER
TRACED W.W.D.	CHECKED W.W.D.	DAYBOOK NO. 08069
		MAY 8, 1940