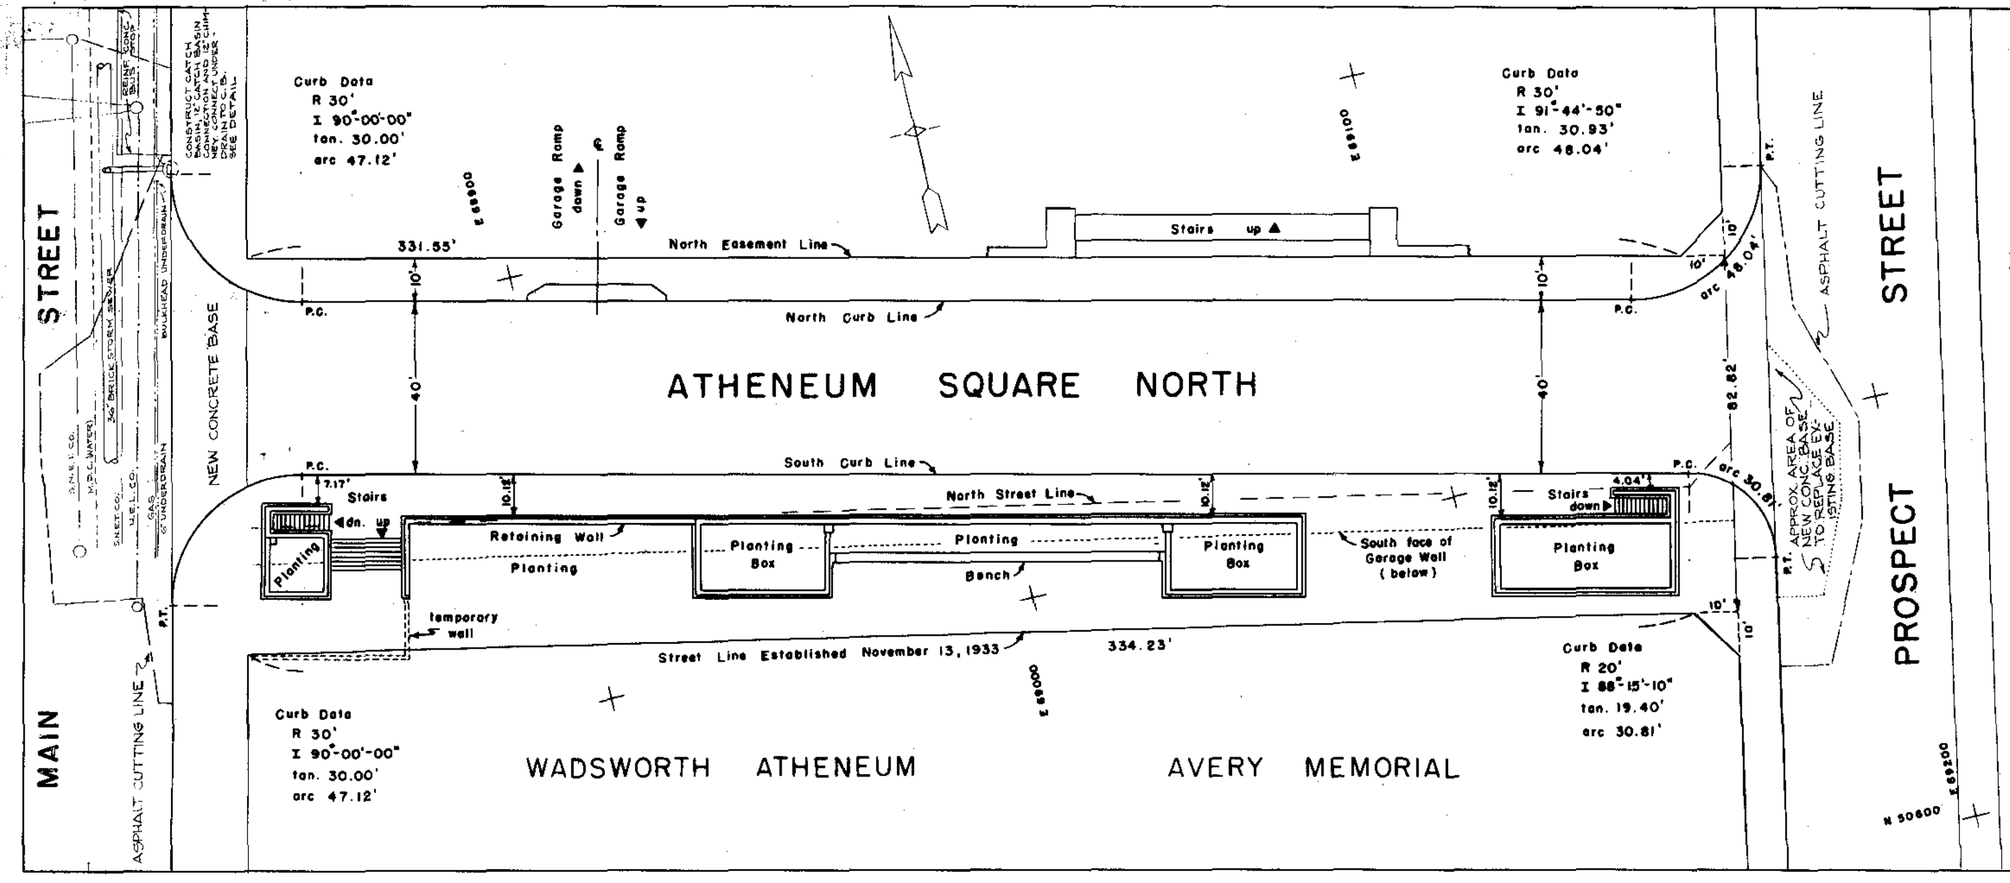

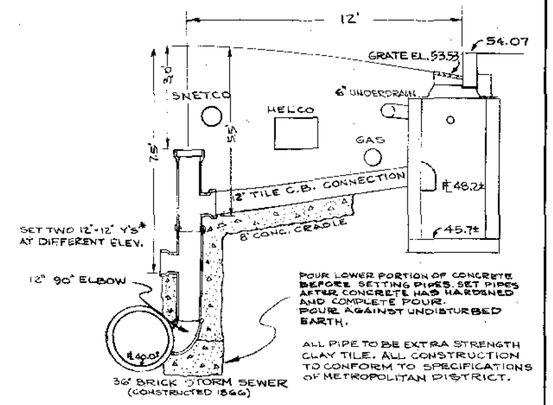

DETAIL OF CATCH BASIN AND CHIMNEY
NOT TO SCALE

12-23-64 - Revised Catch Basin Detail to "As-Built"
10-23-64 - Revised Catch Basin Detail

CITY OF HARTFORD, CONNECTICUT
DEPARTMENT OF ENGINEERING

ATHENEUM SQUARE NORTH PAVING

SUBMITTED	RECOMMENDED	APPROVED
Richard L. Sommer	Roger F. Hoffman	Peter H. Brennan
DIVISION ENGINEER	ASST. CITY ENG.	CITY ENGINEER

DESIGN — DRAWN R.L.L.
TRACED B.J.B. CHECK E.J.P.
DAYBOOK NO. 09838A
SCALE 1" = 20'
DATE SEPT. 1964