


20  
120

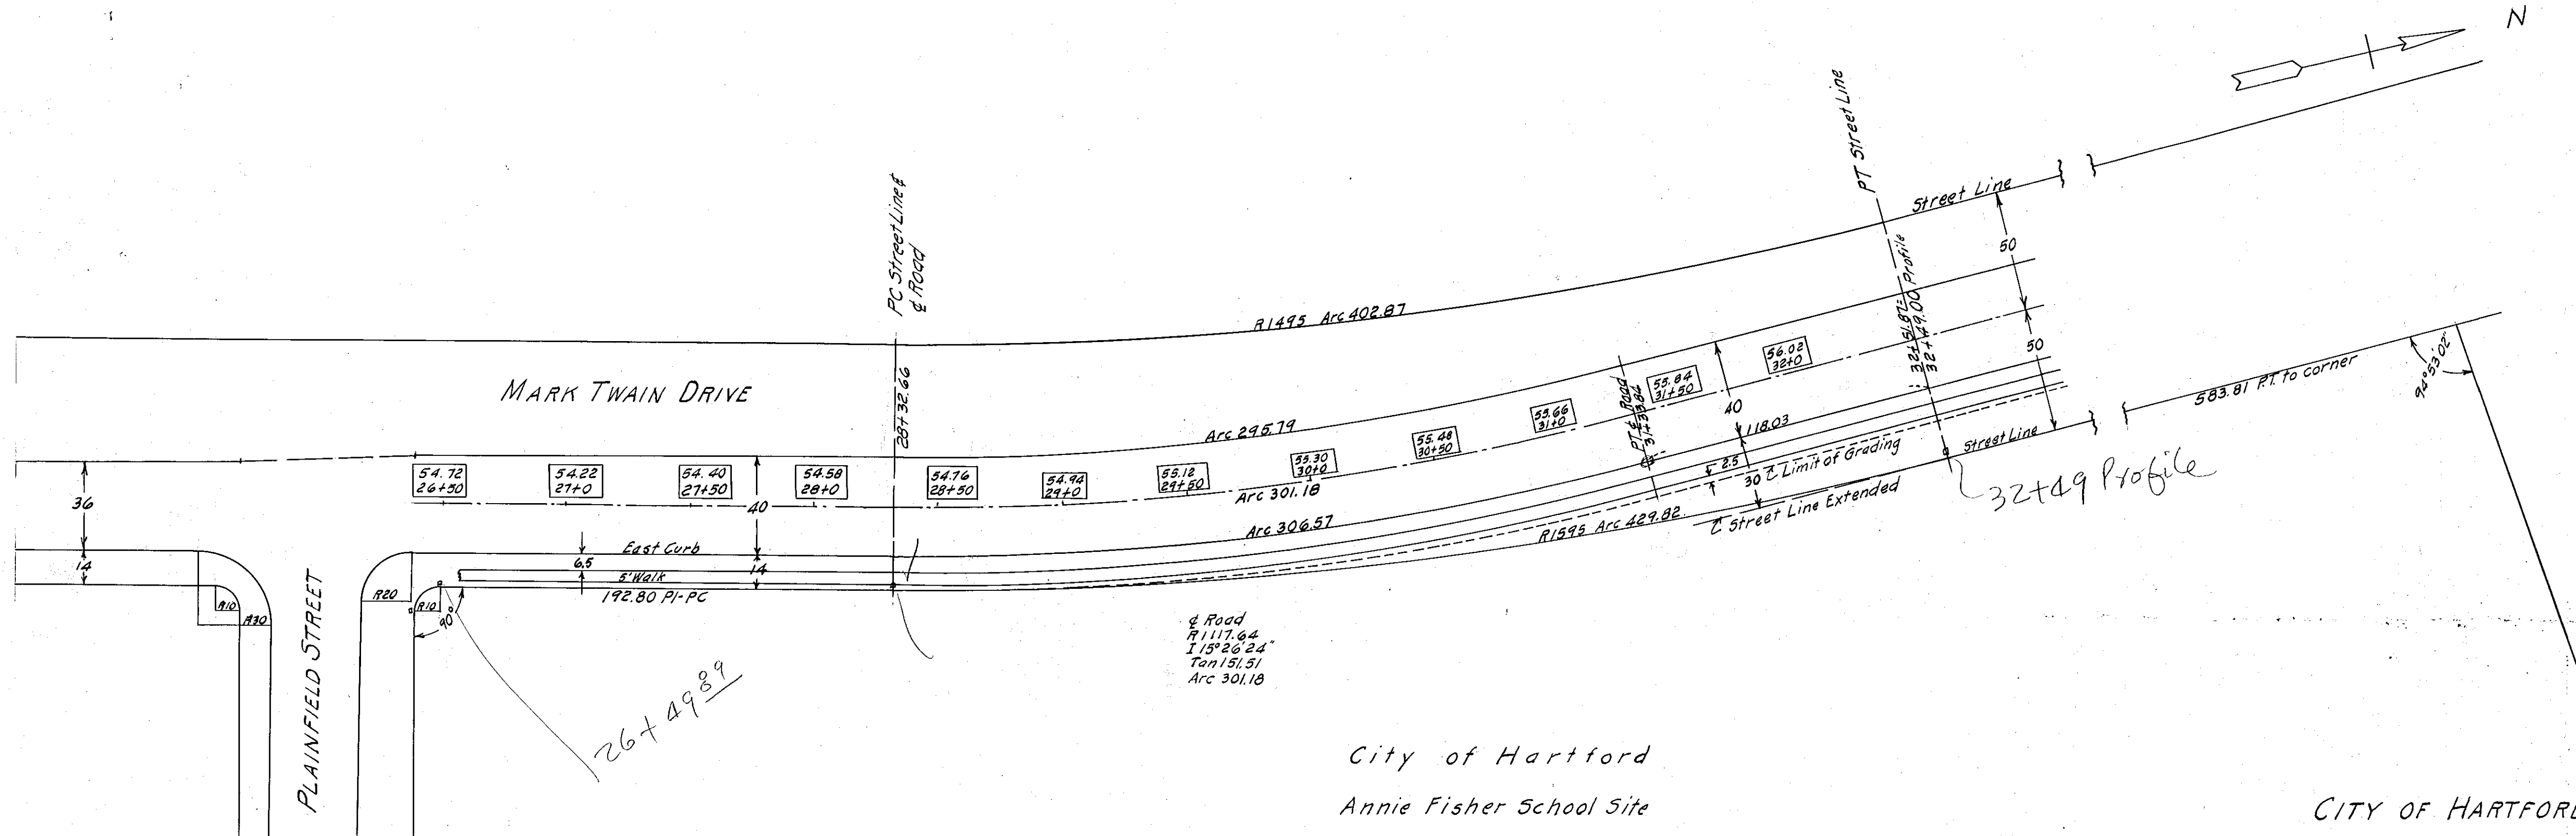

City of Hartford  
Annie Fisher School Site

CITY OF HARTFORD  
DEPARTMENT OF ENGINEERING  
SCALE 1"=40' JUNE 1965  
DAYBOOK No. 09878