

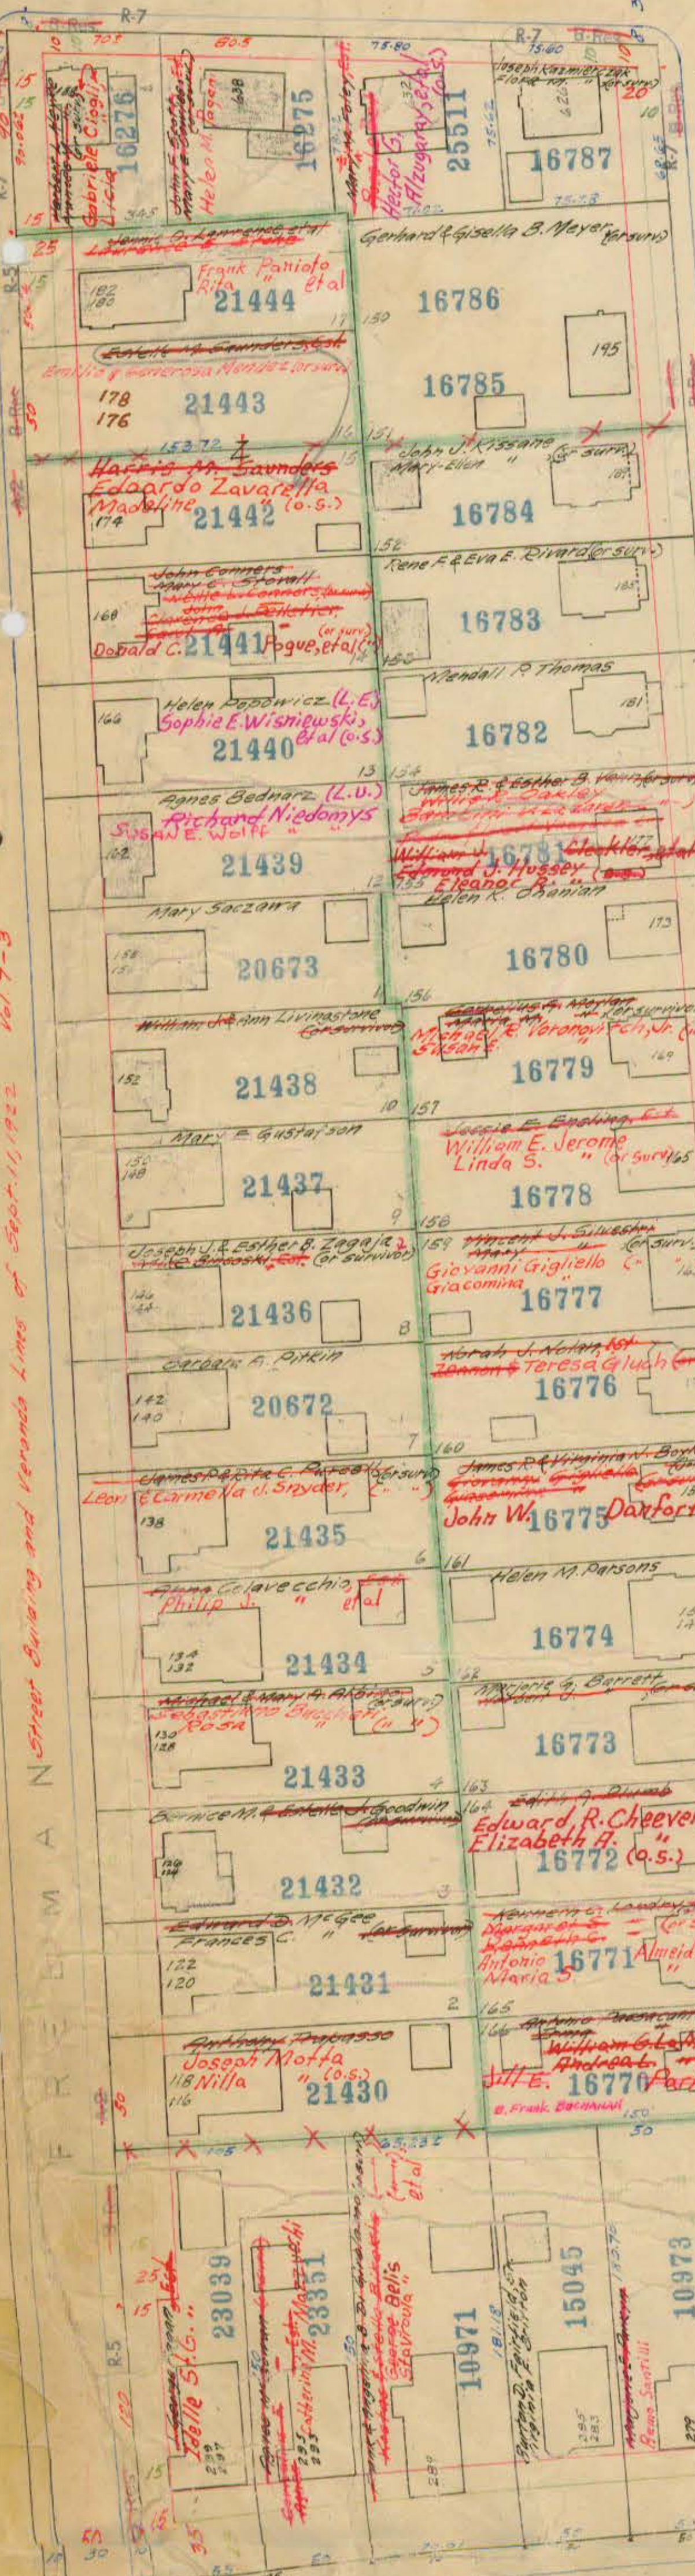
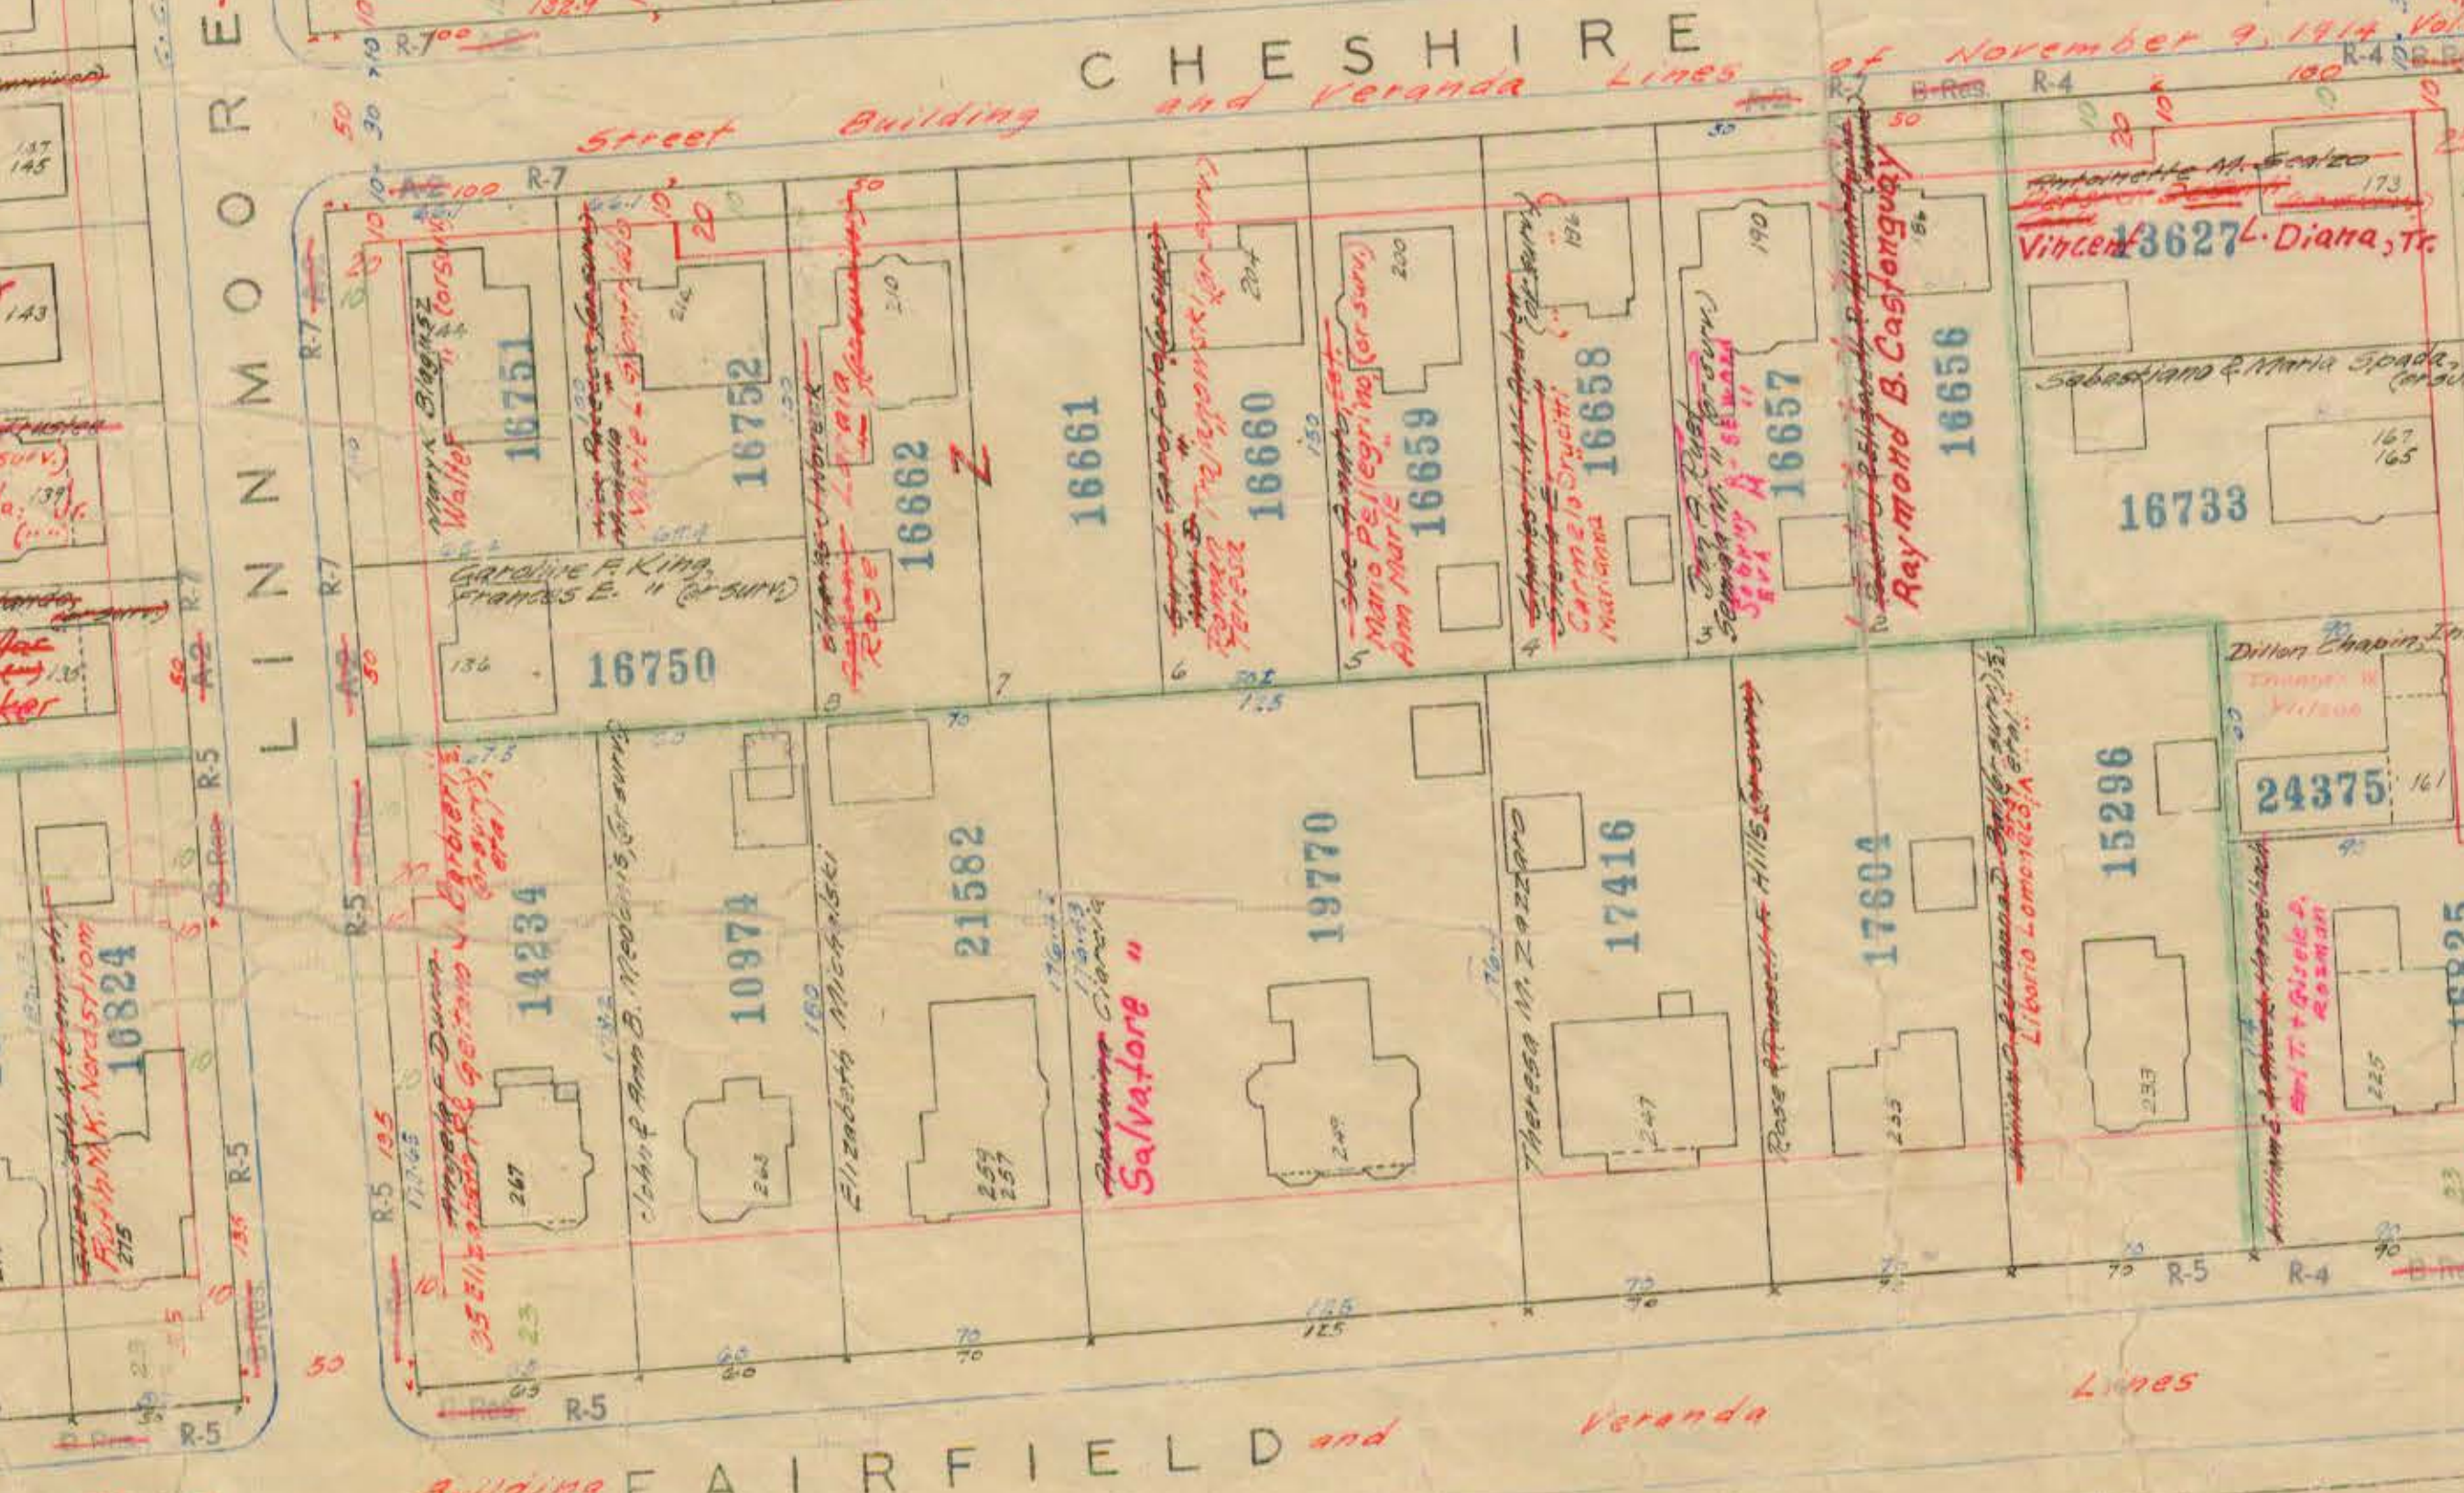





Street, Building & Veranda Lines of Sept. 11, 1922 Vol. 7-4

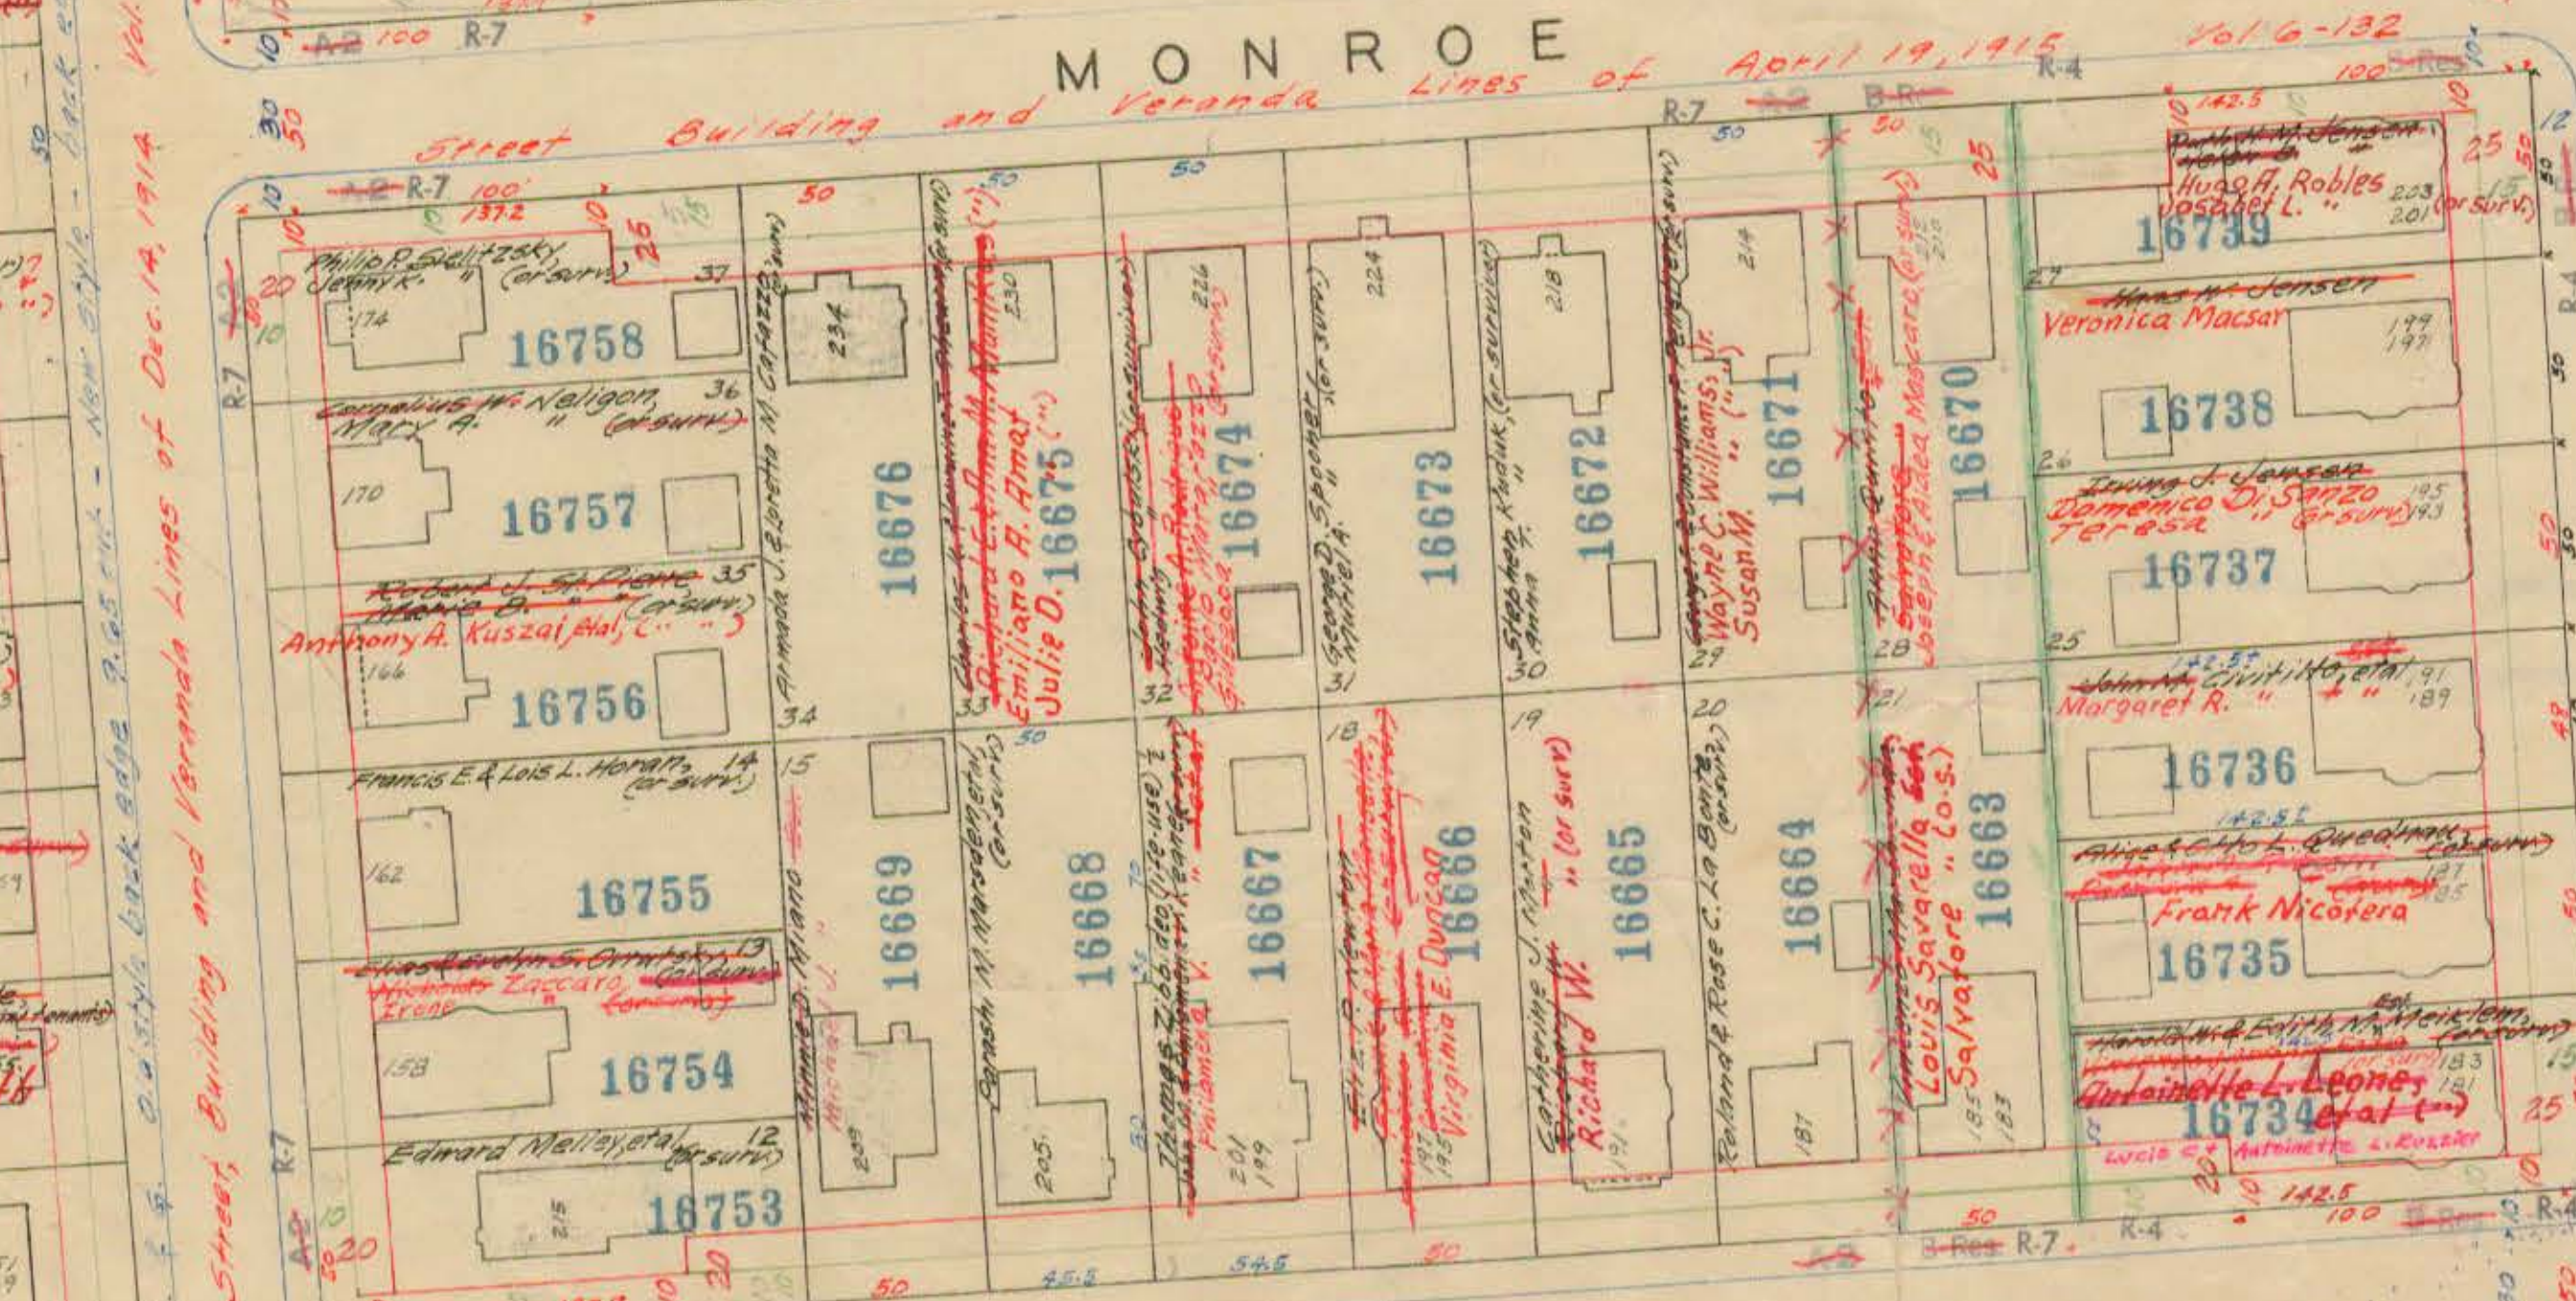

HILLSIDE Street, Building and Veranda Lines of September 10, 1917 Vol. 6-240

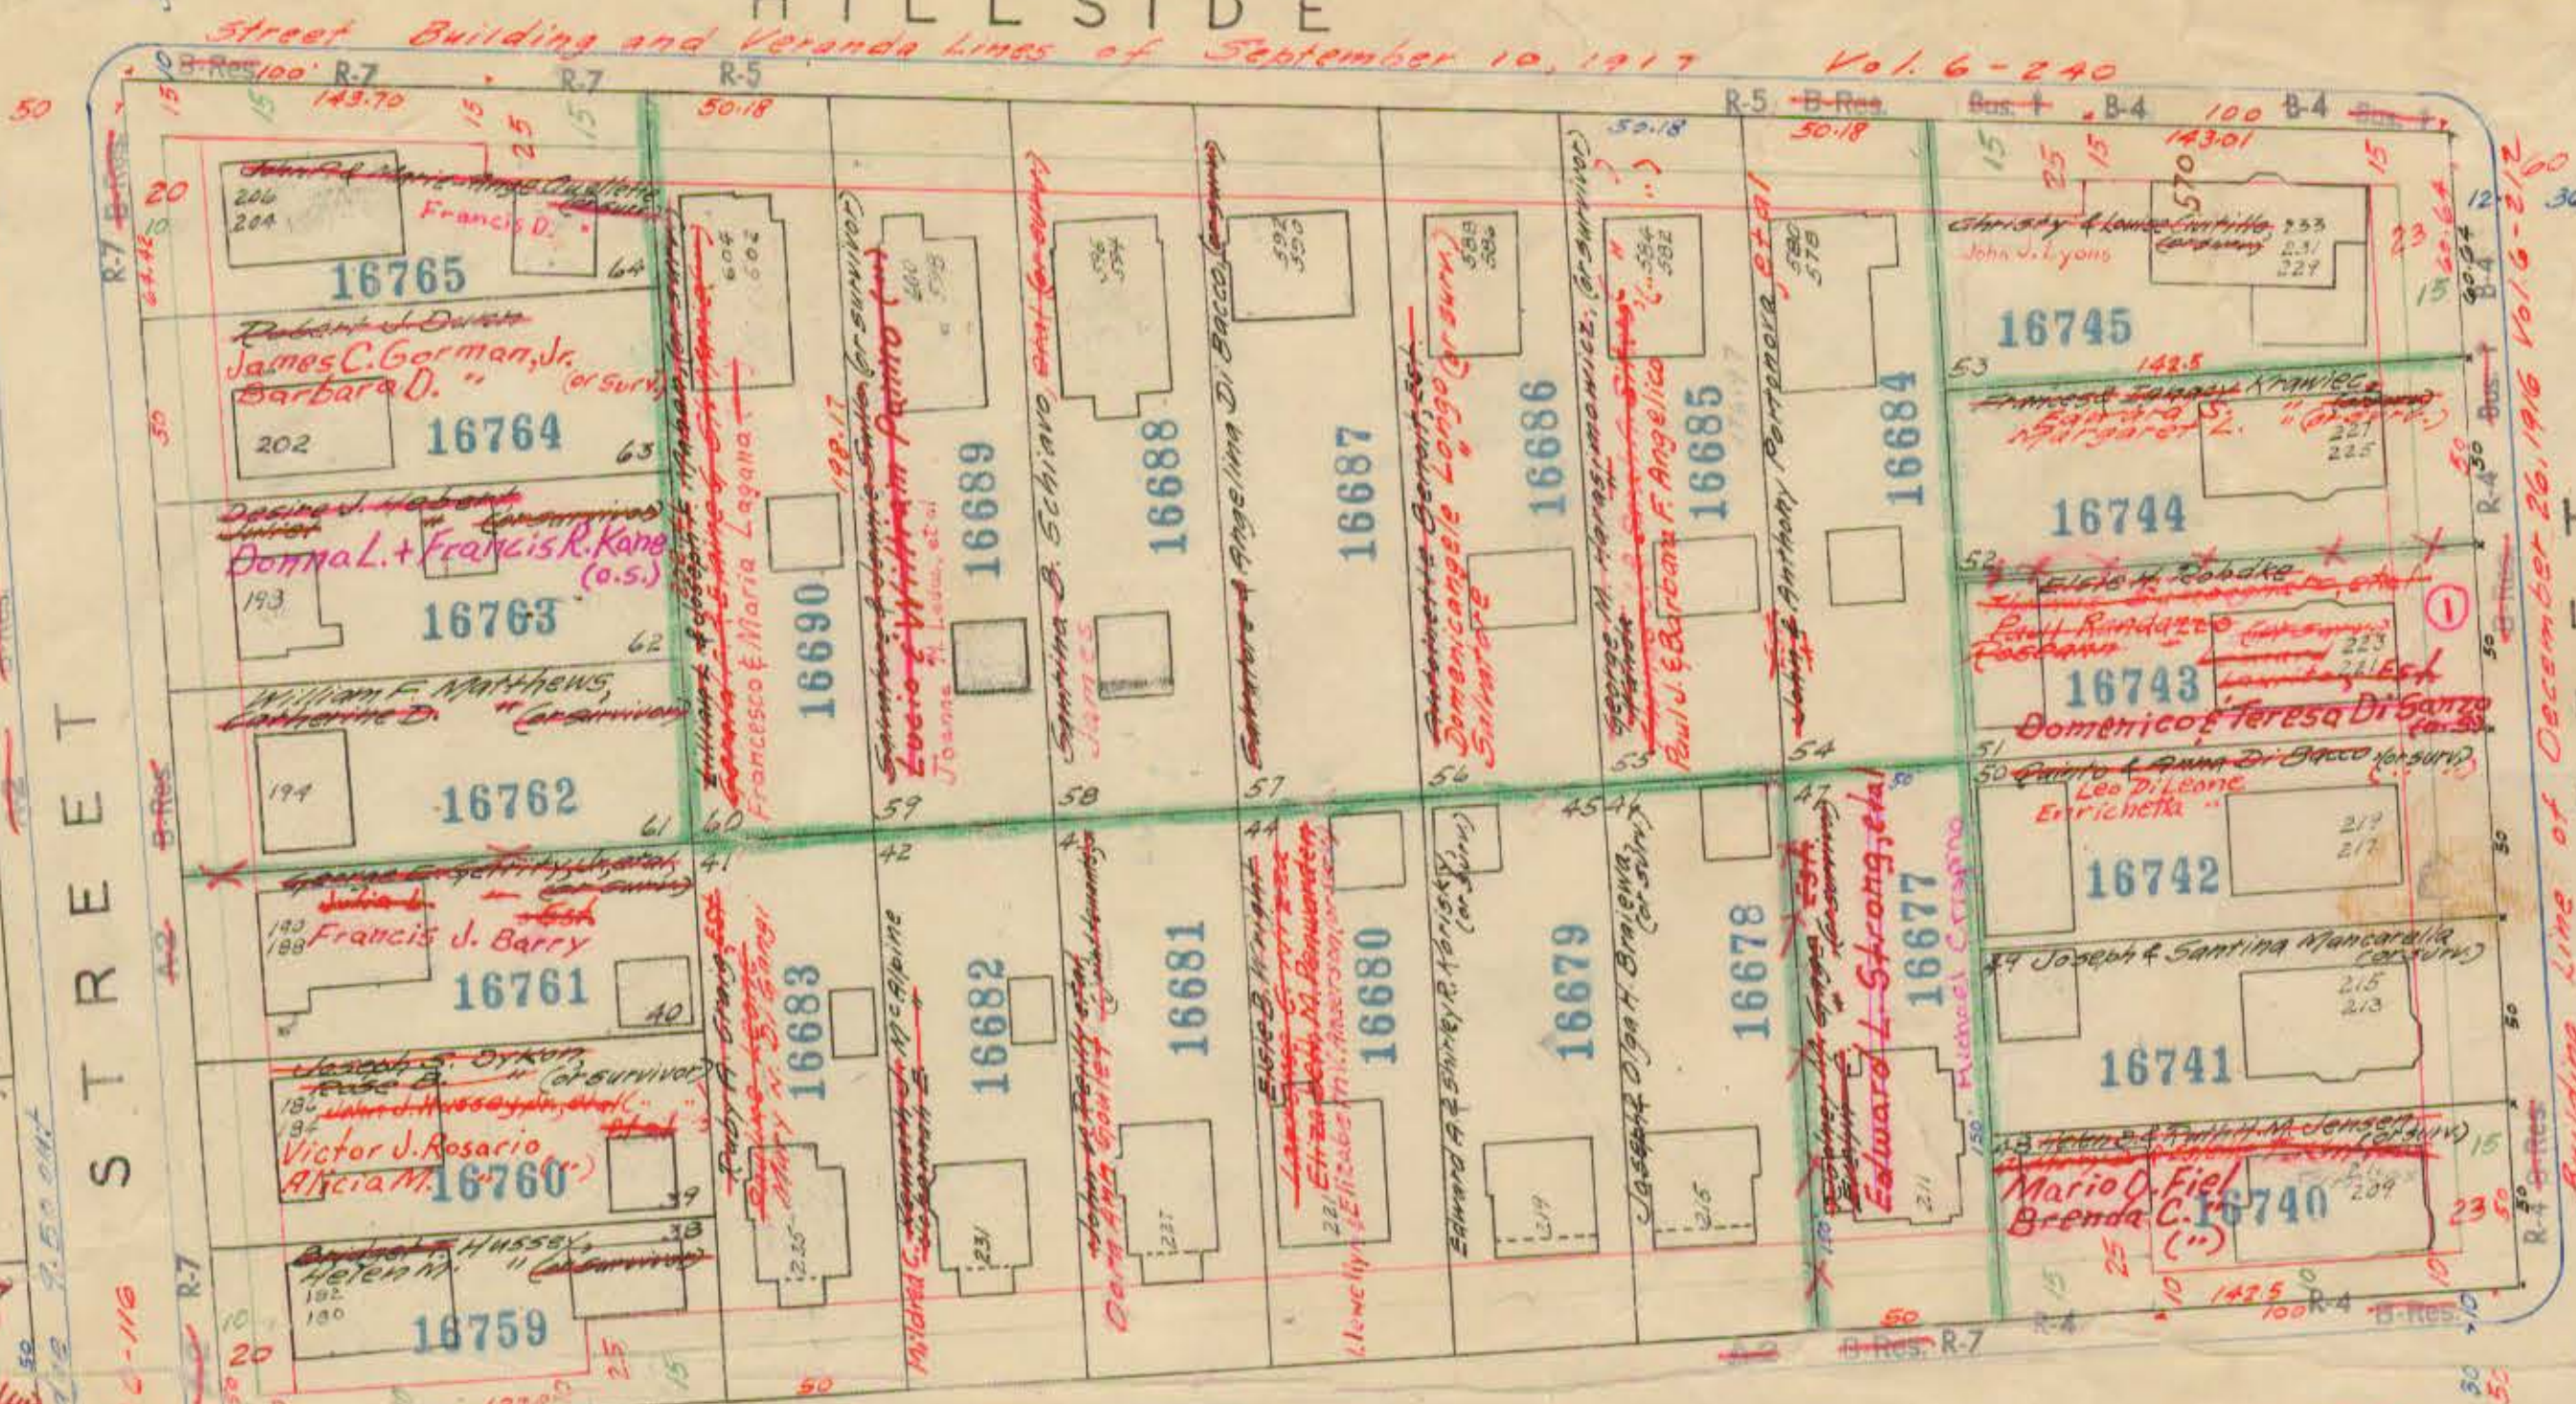

See Sheet 161

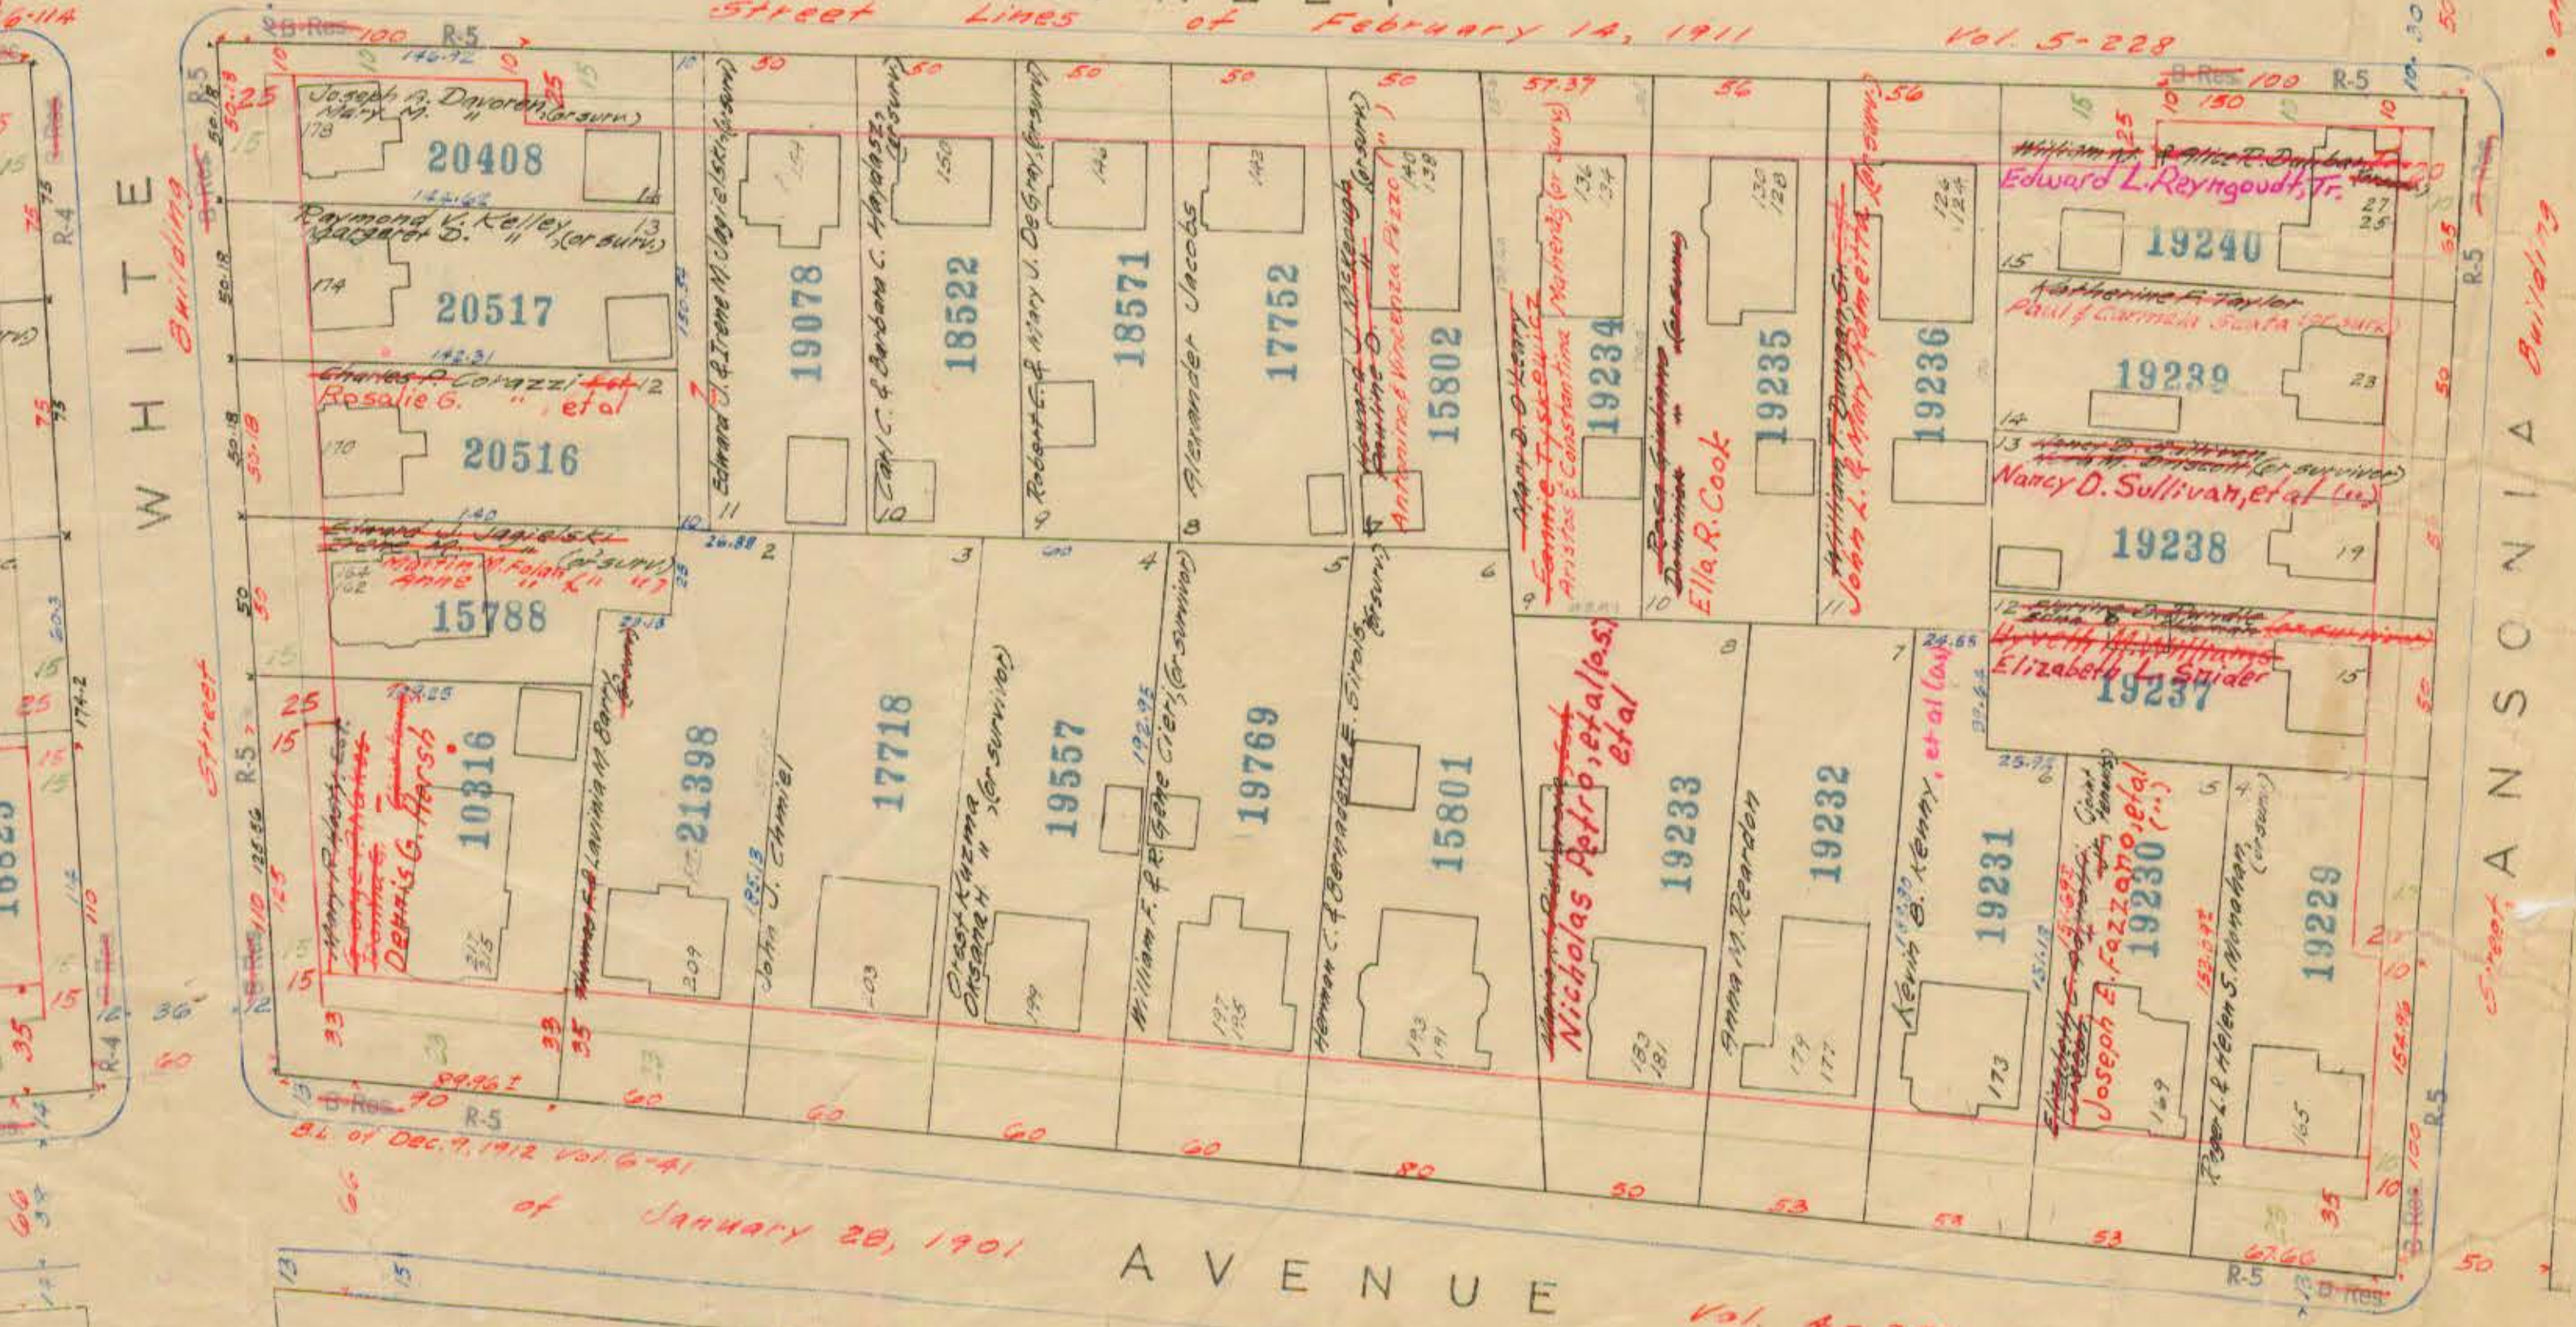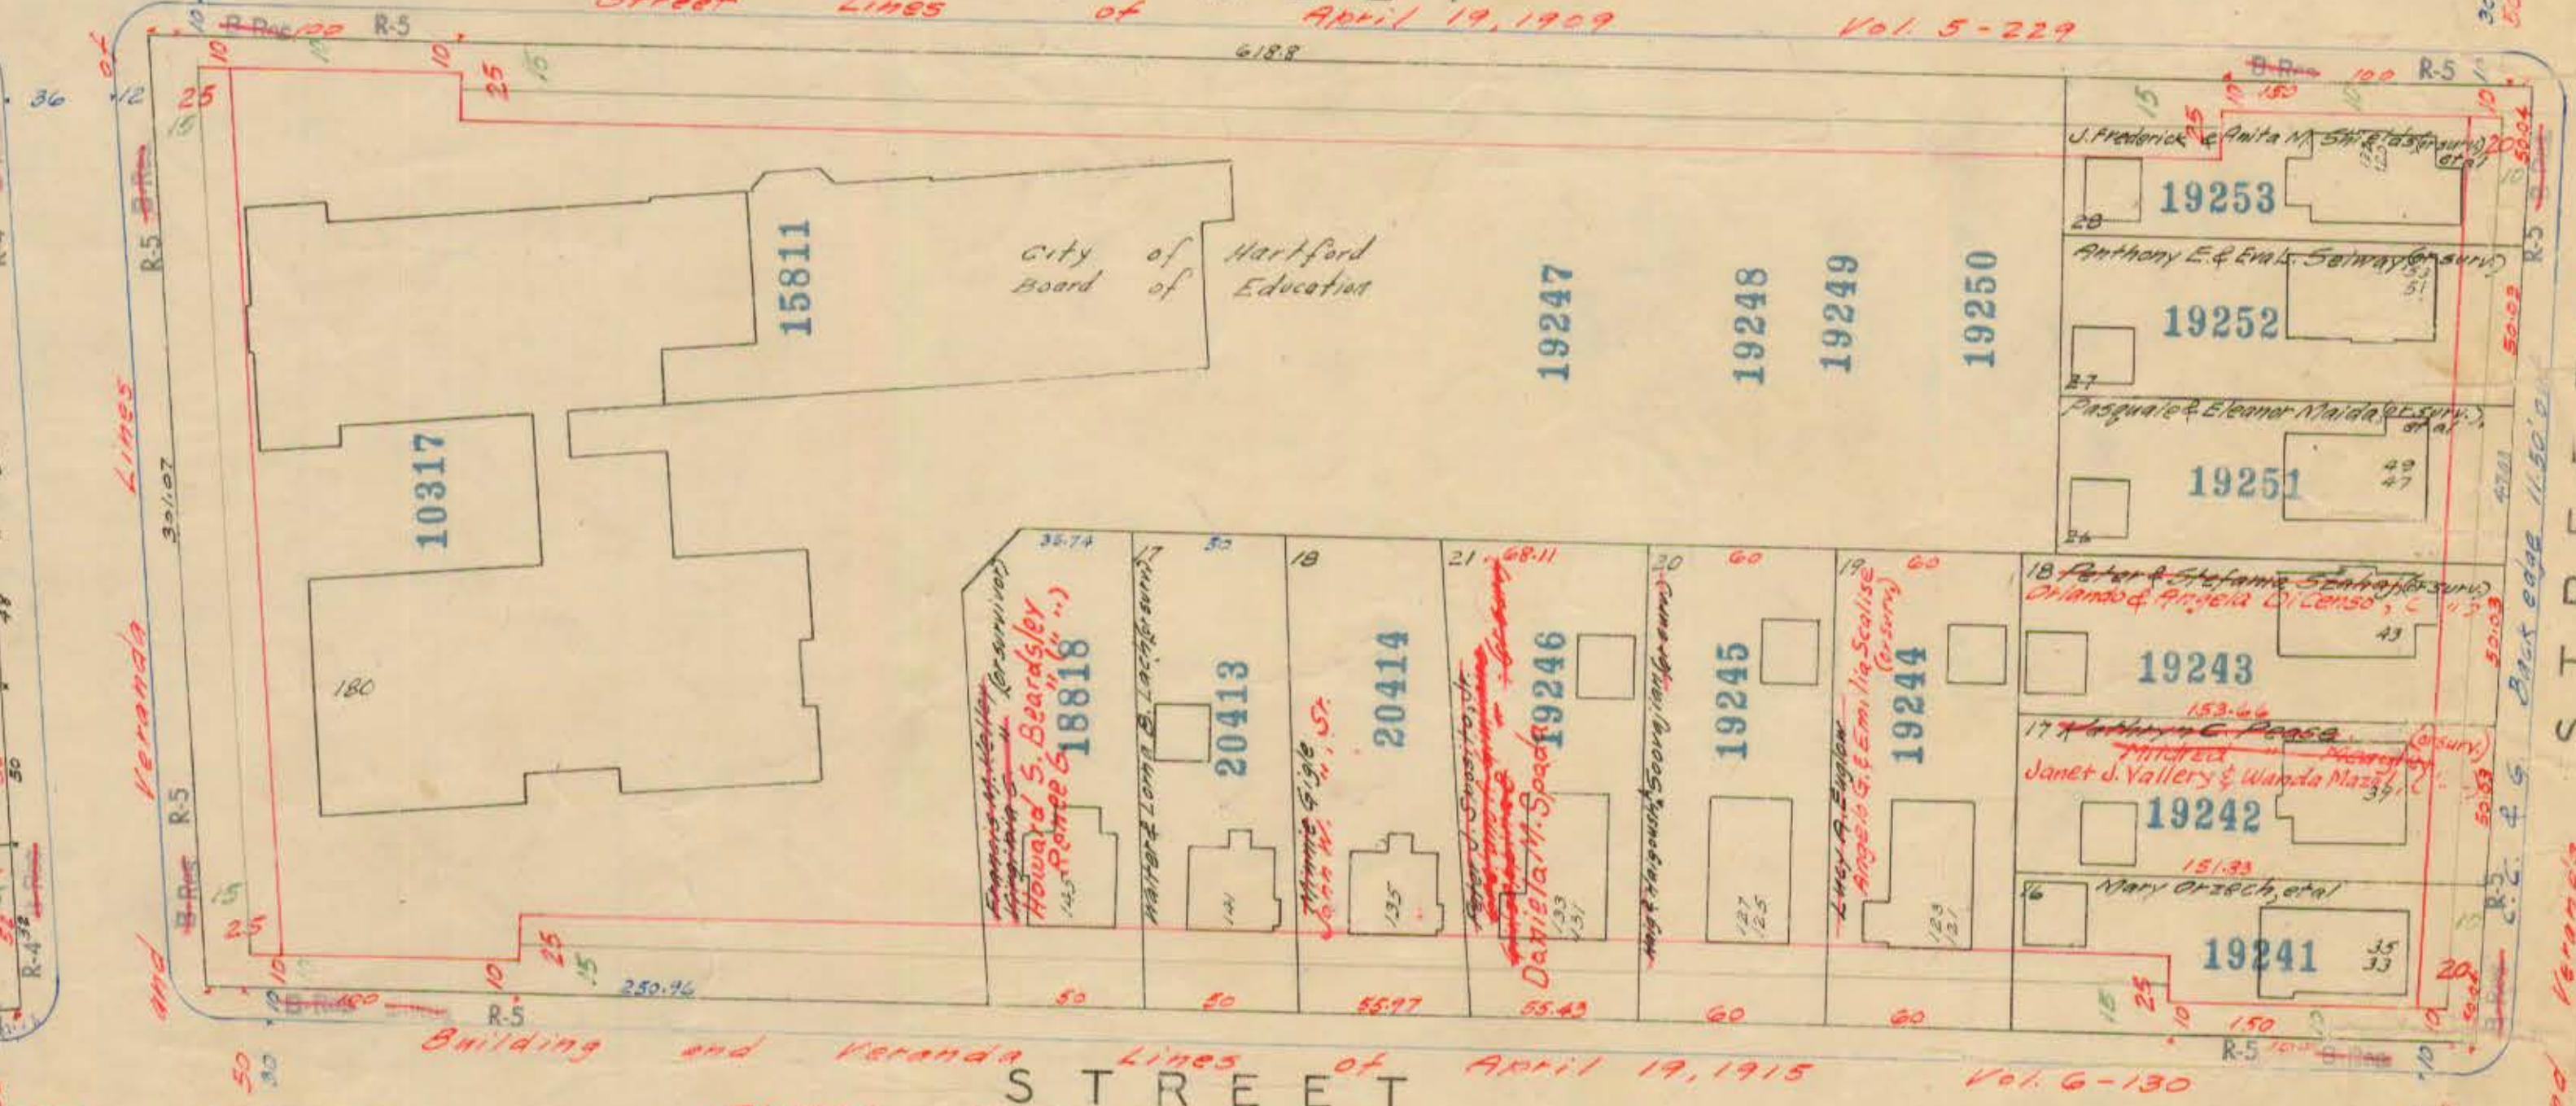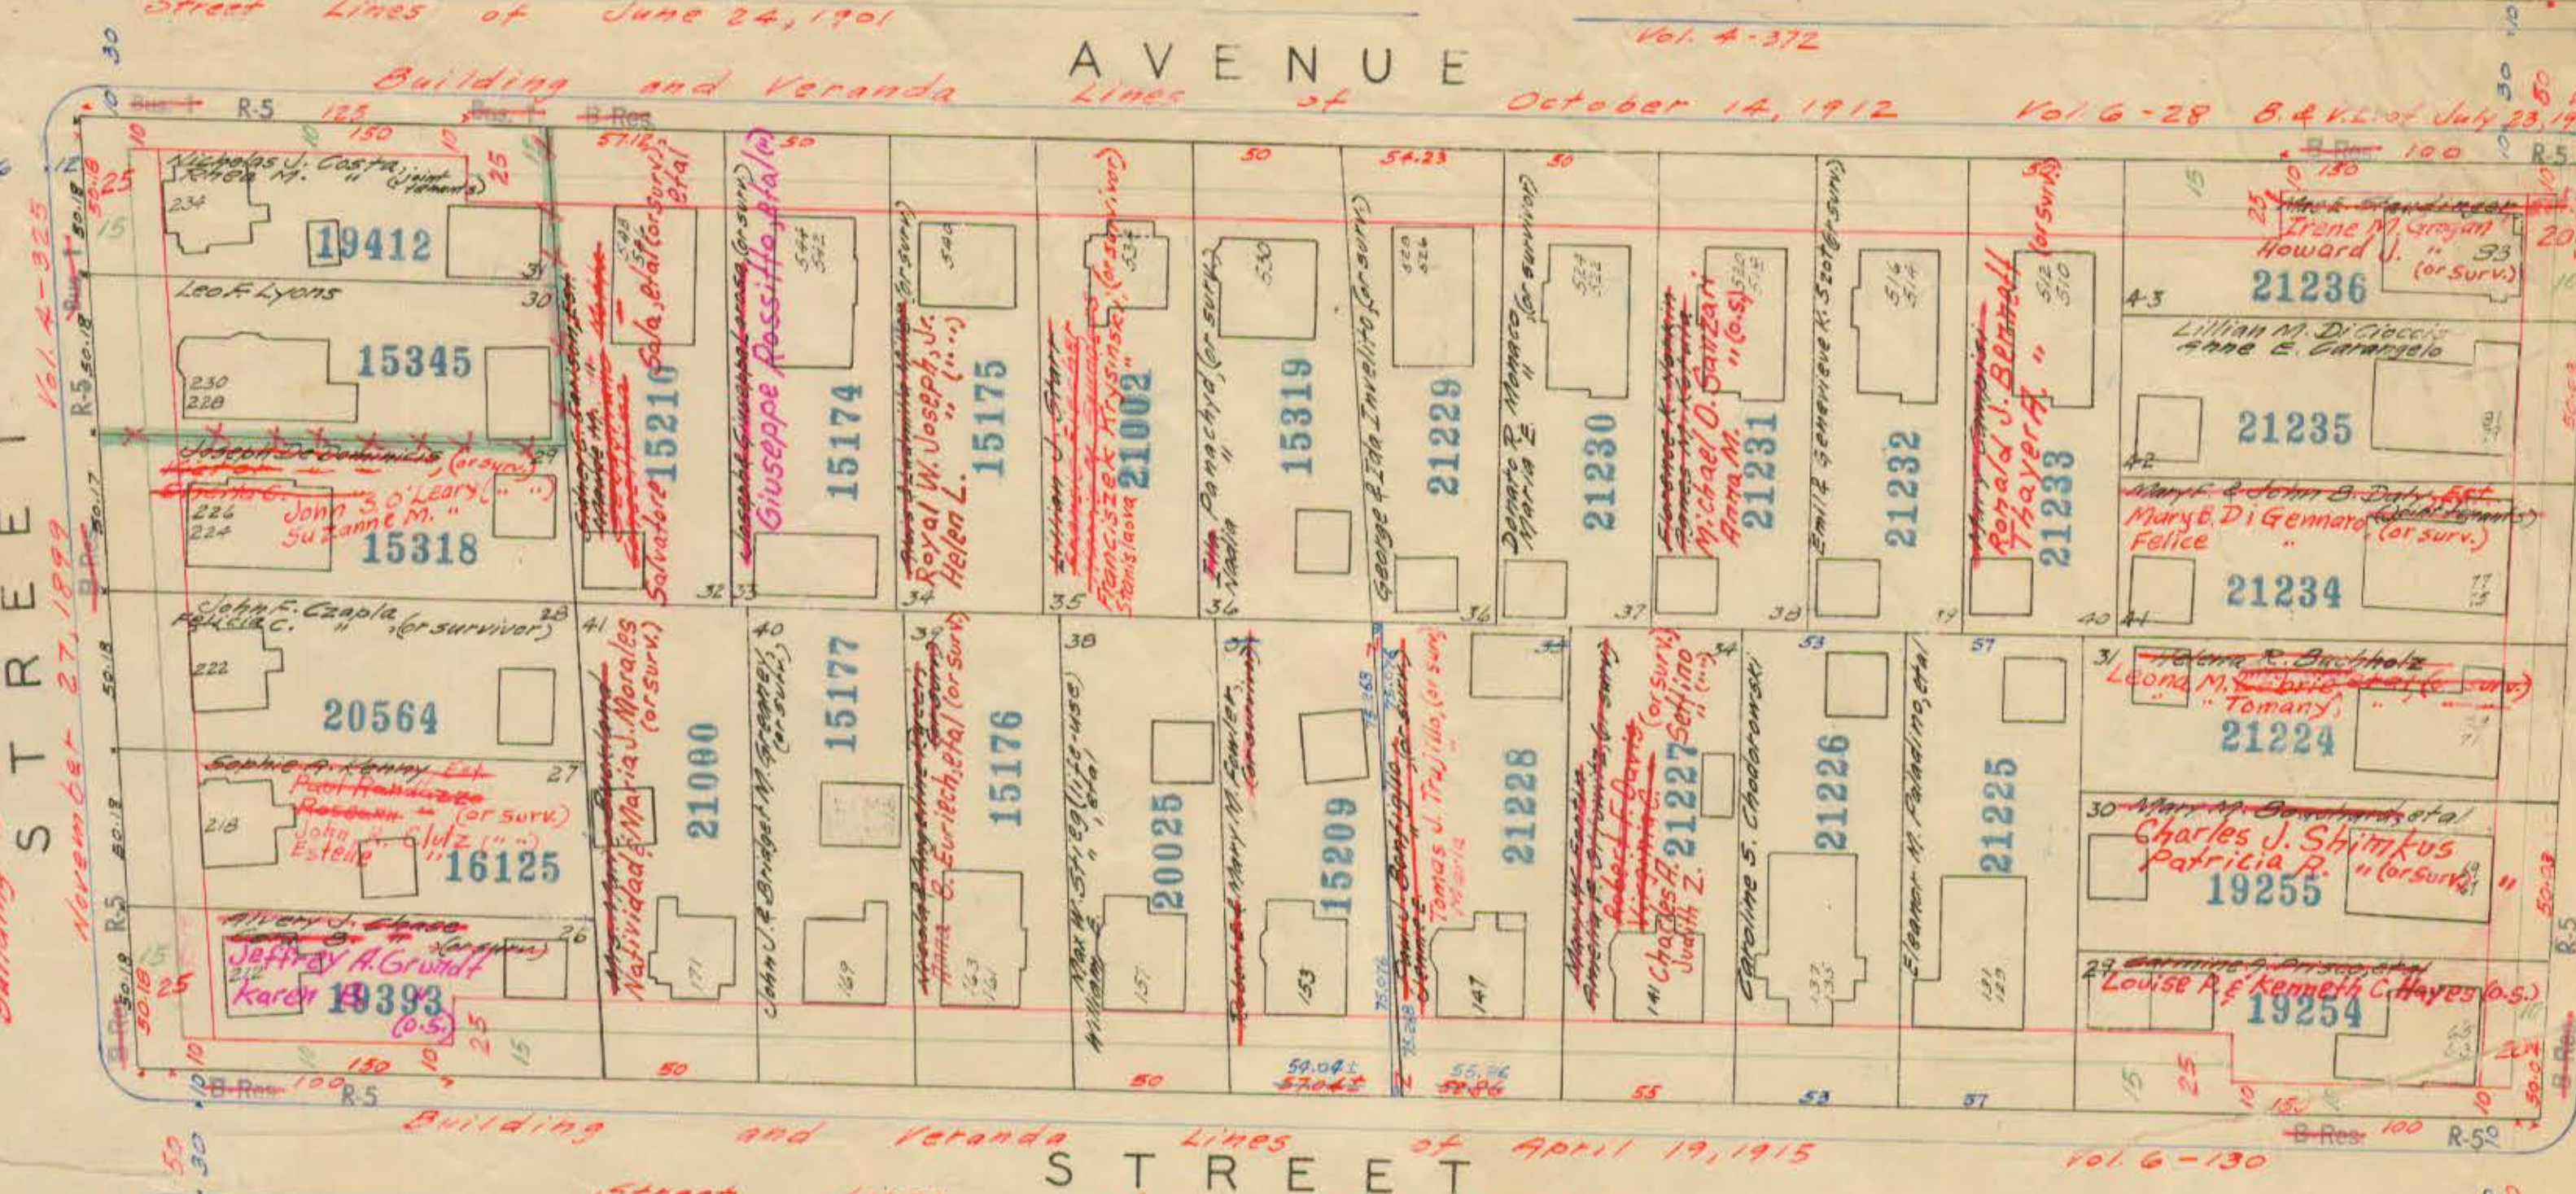

See Sheet 161

