


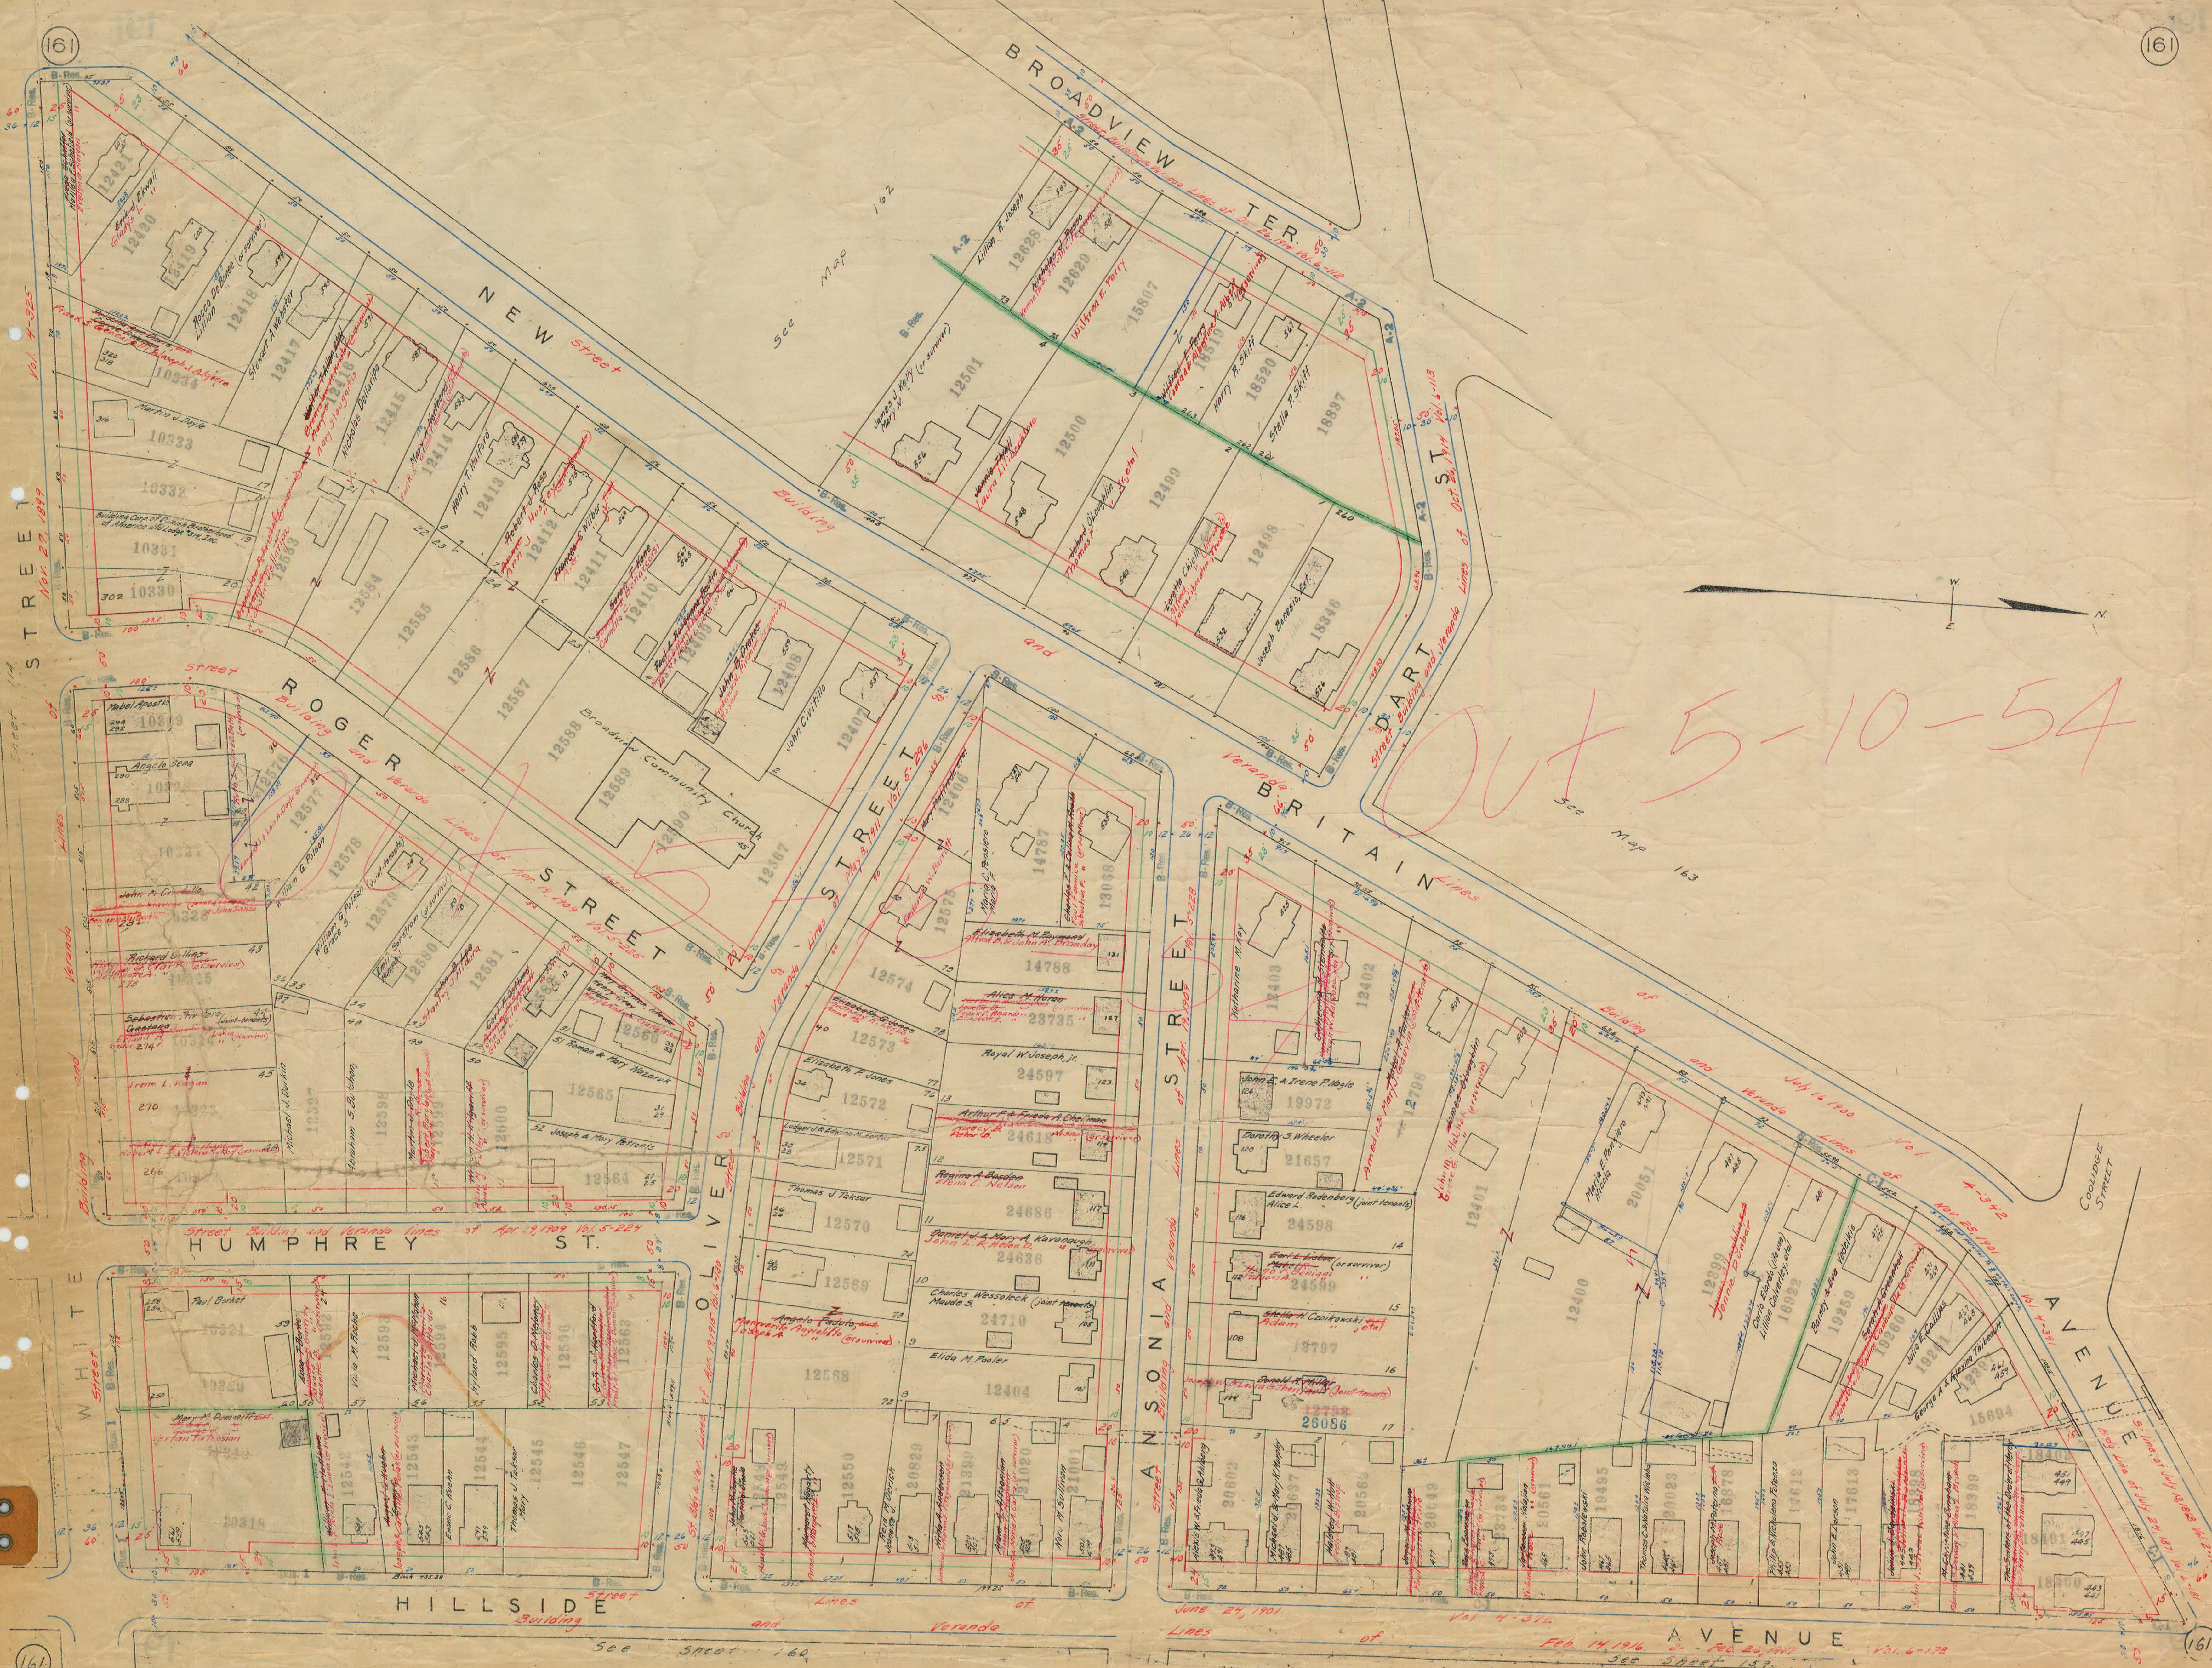

Dut 5-10-54

