


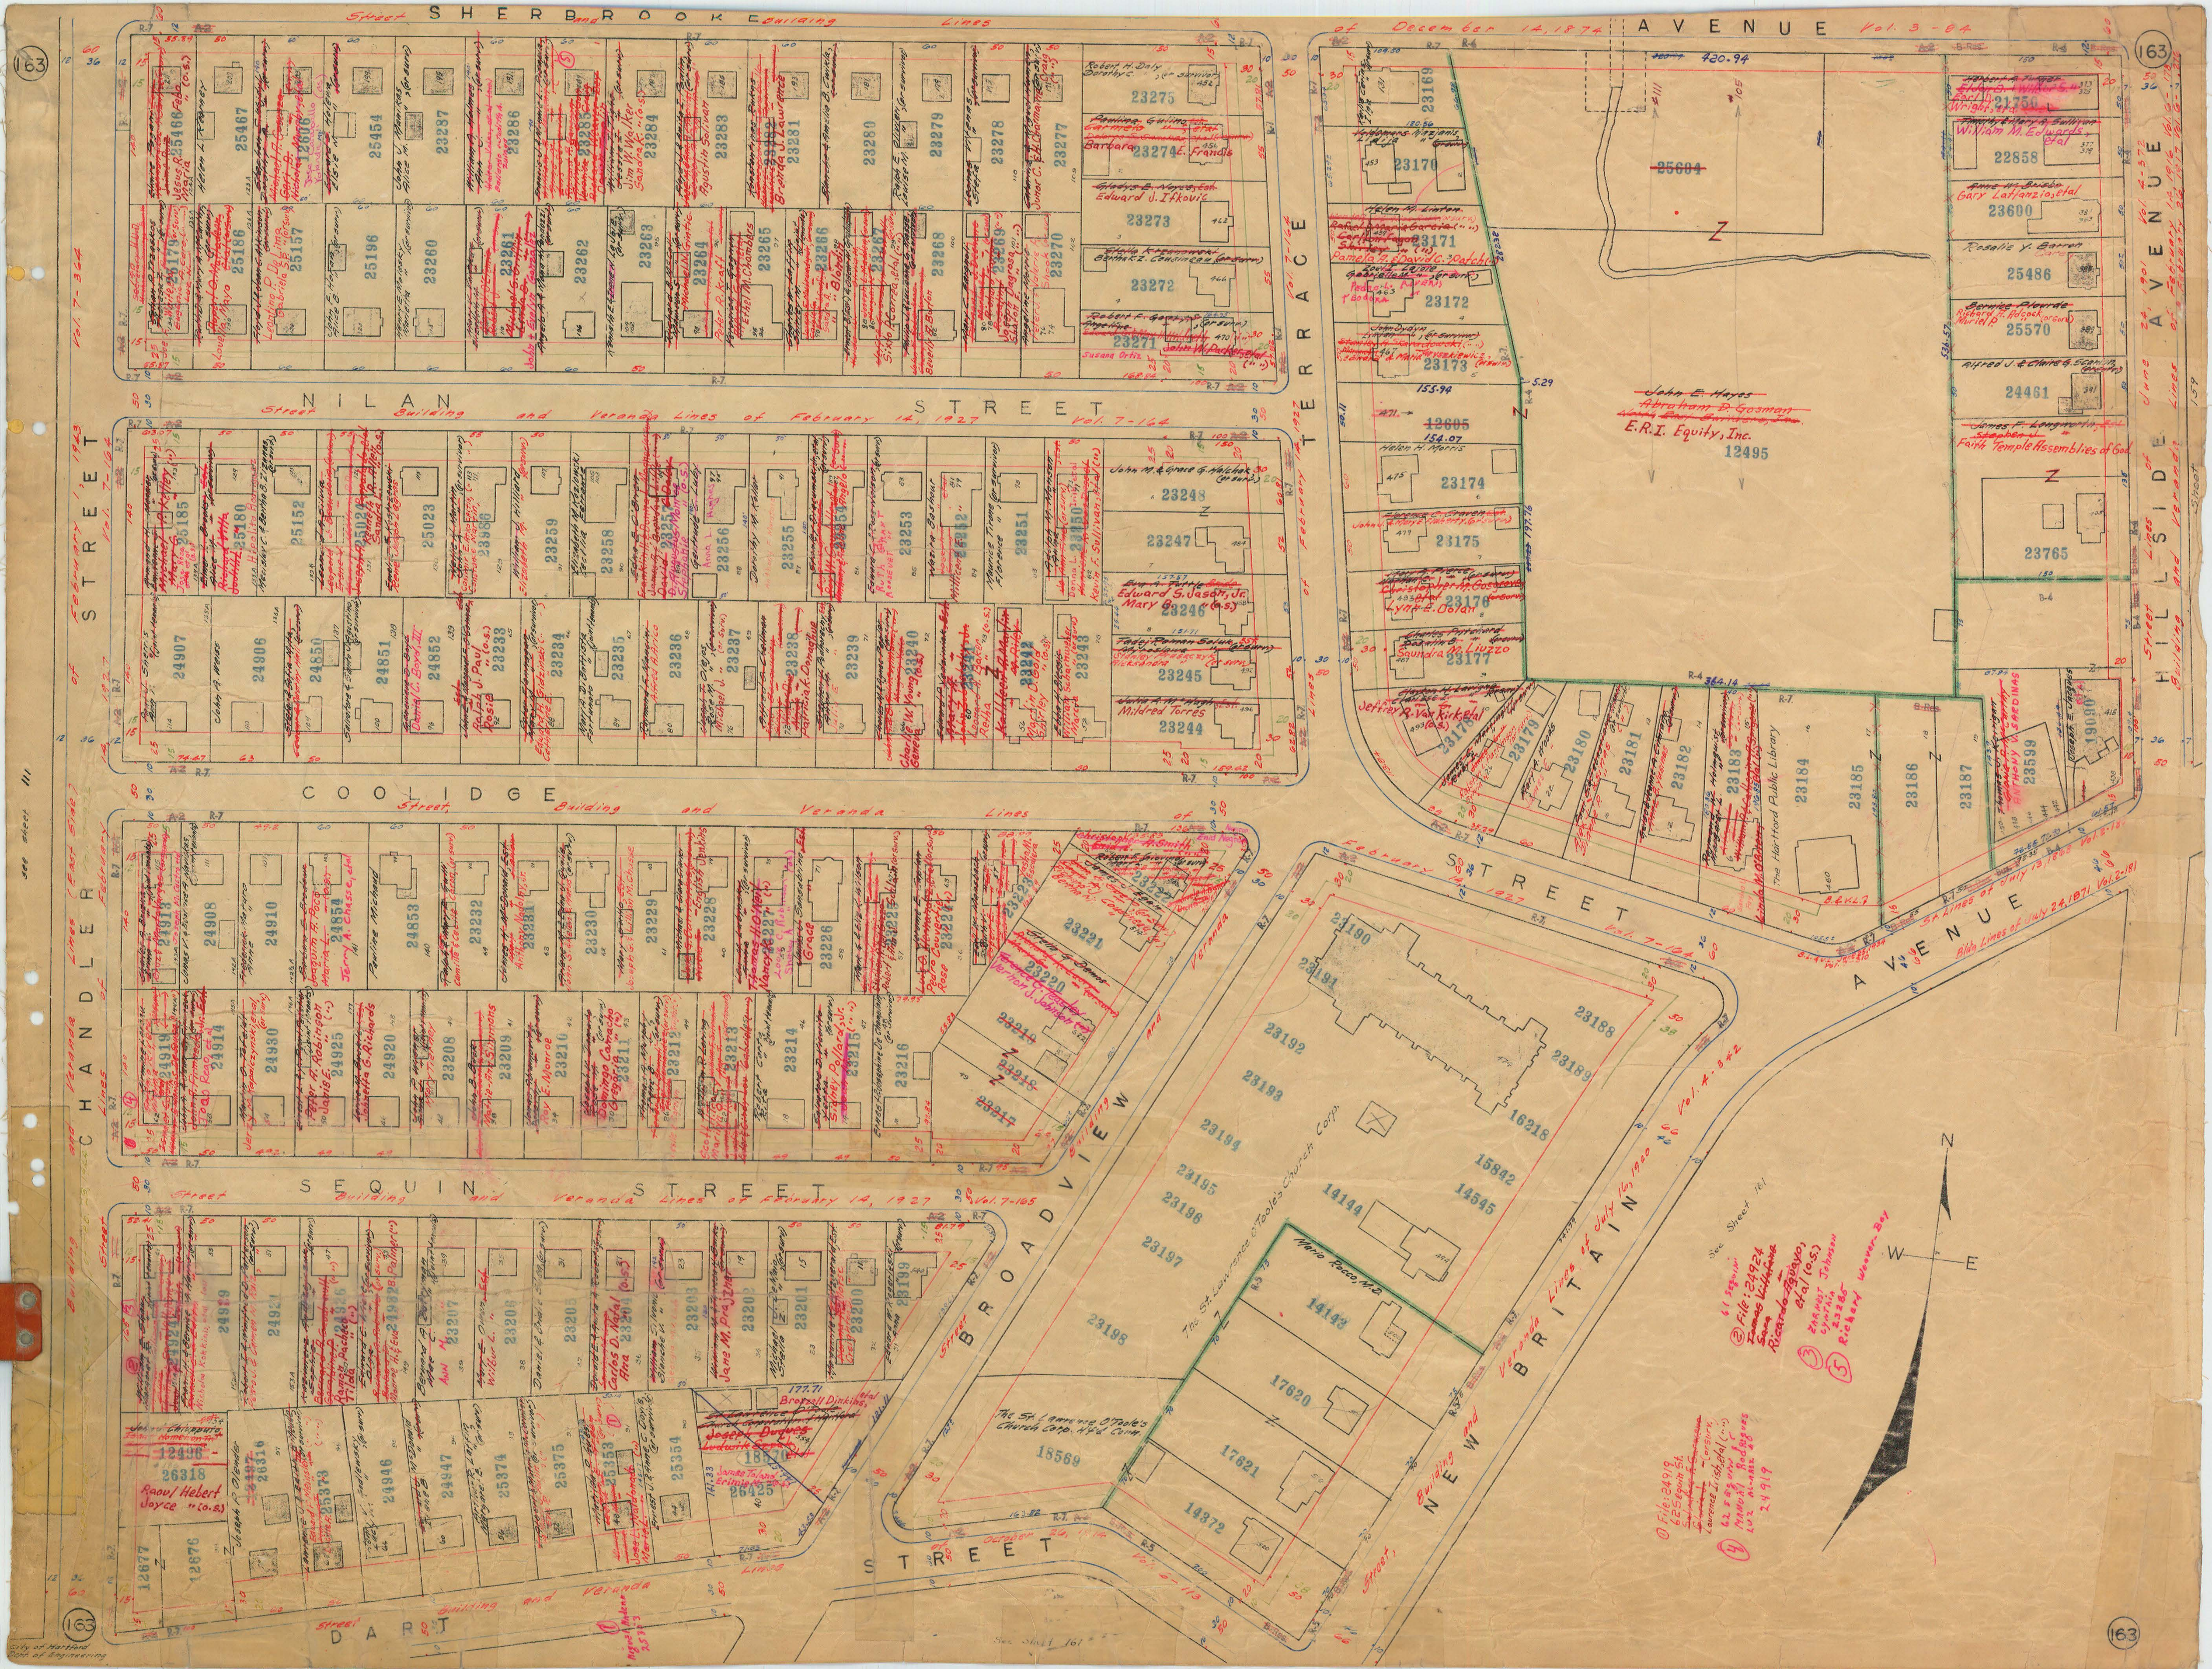

See sheet 161

See sheet 161

- ① File: 24919
625 sqm 54
Lorraine F. Johnson
