


See Sheet 224

HUBBARD Street

Goodwin Park


January 12, 1925

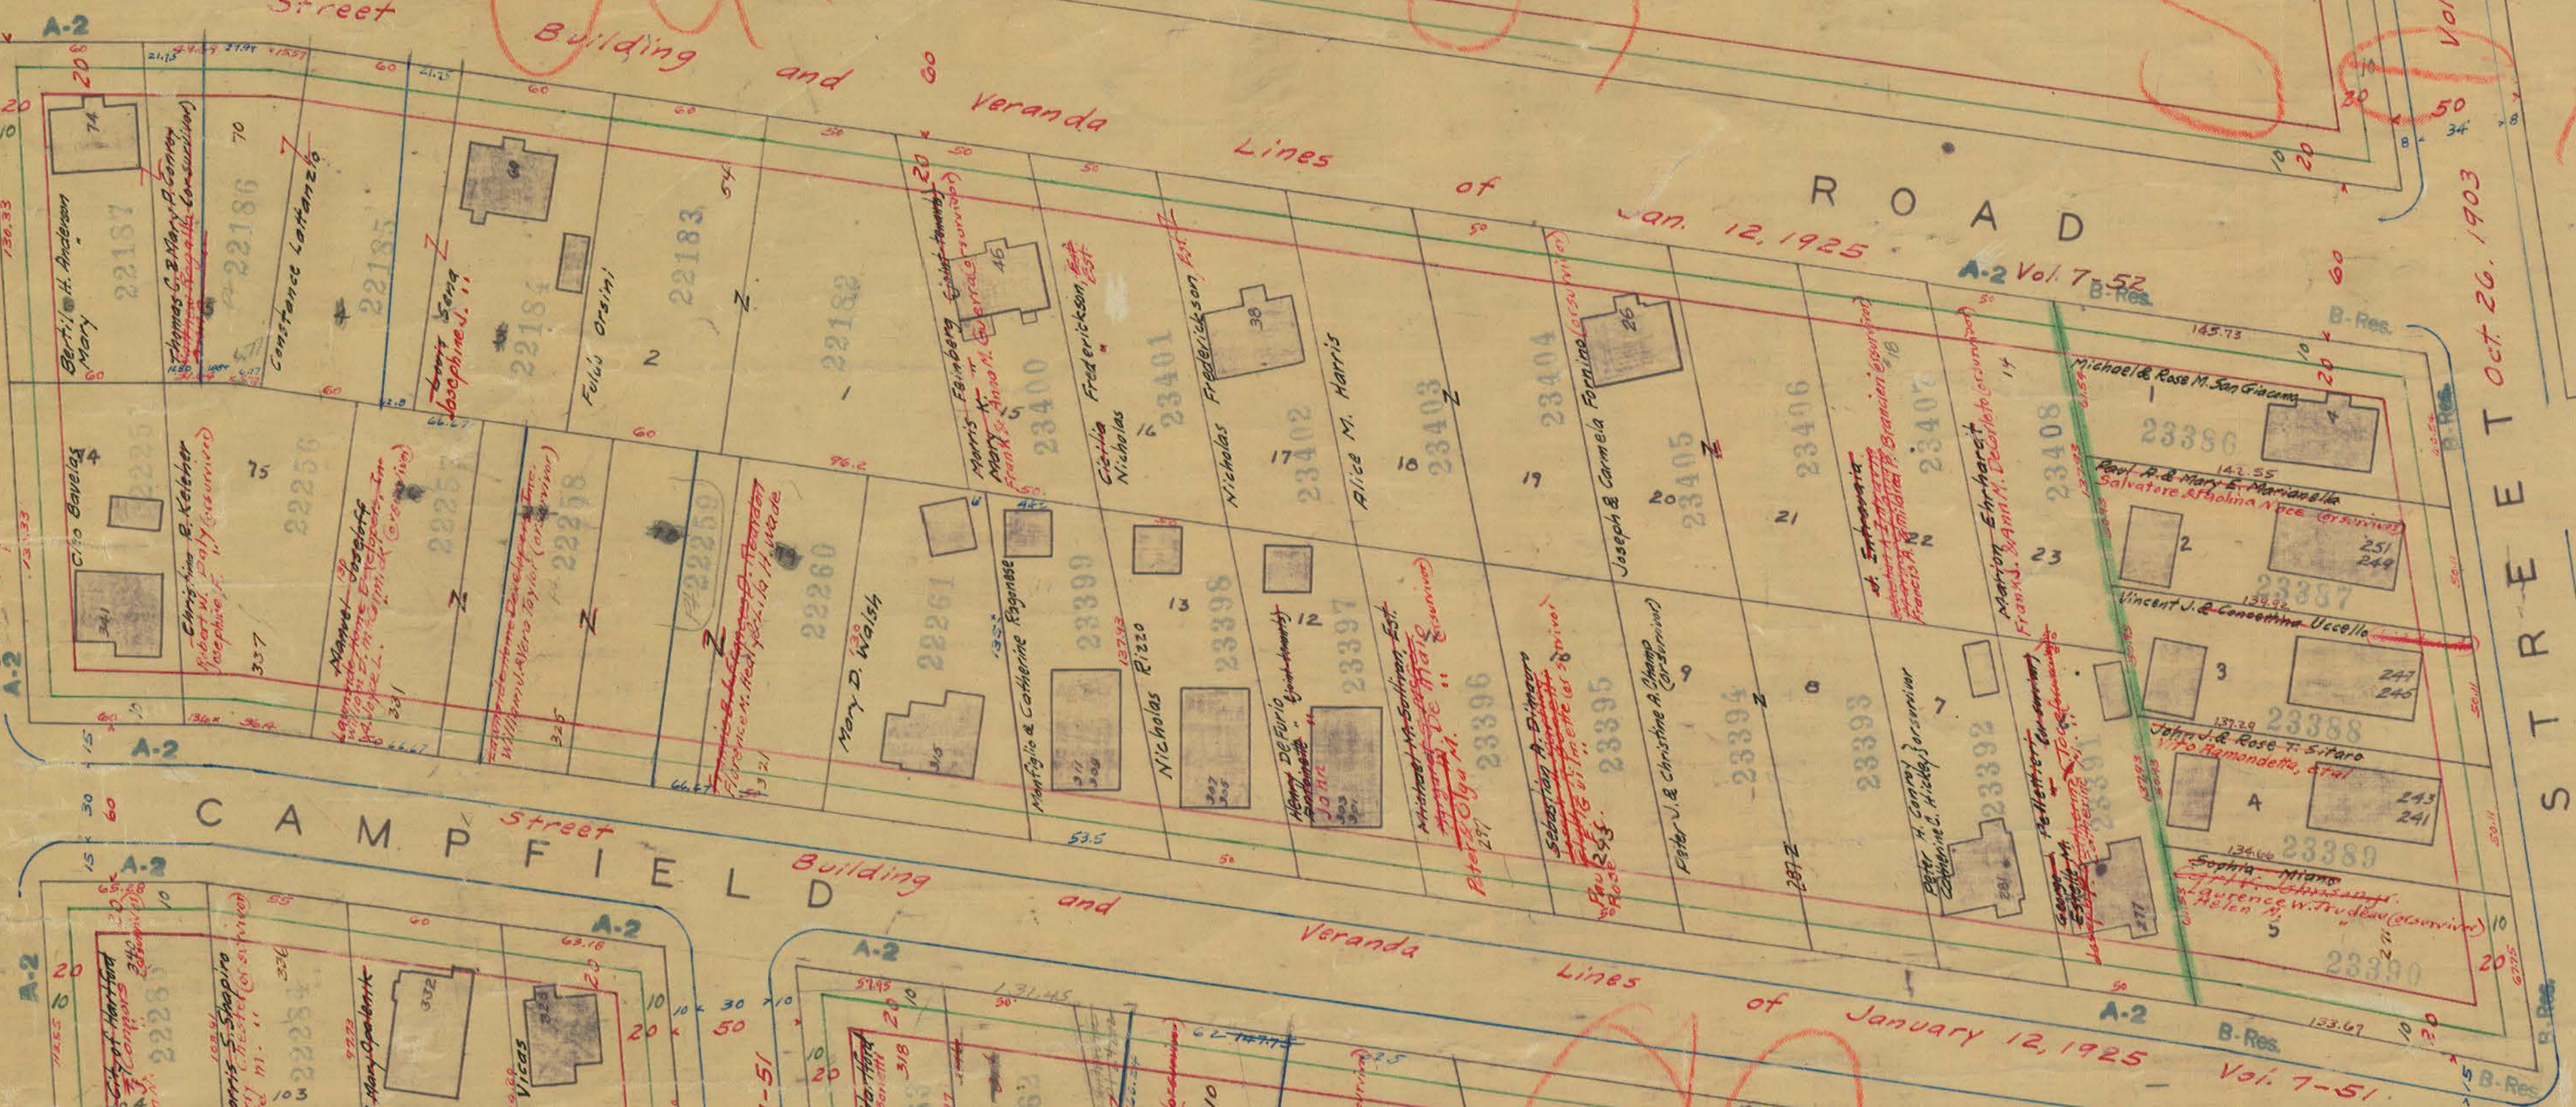

BECKET ST.

See Sheet 153

CAMPFIELD Street

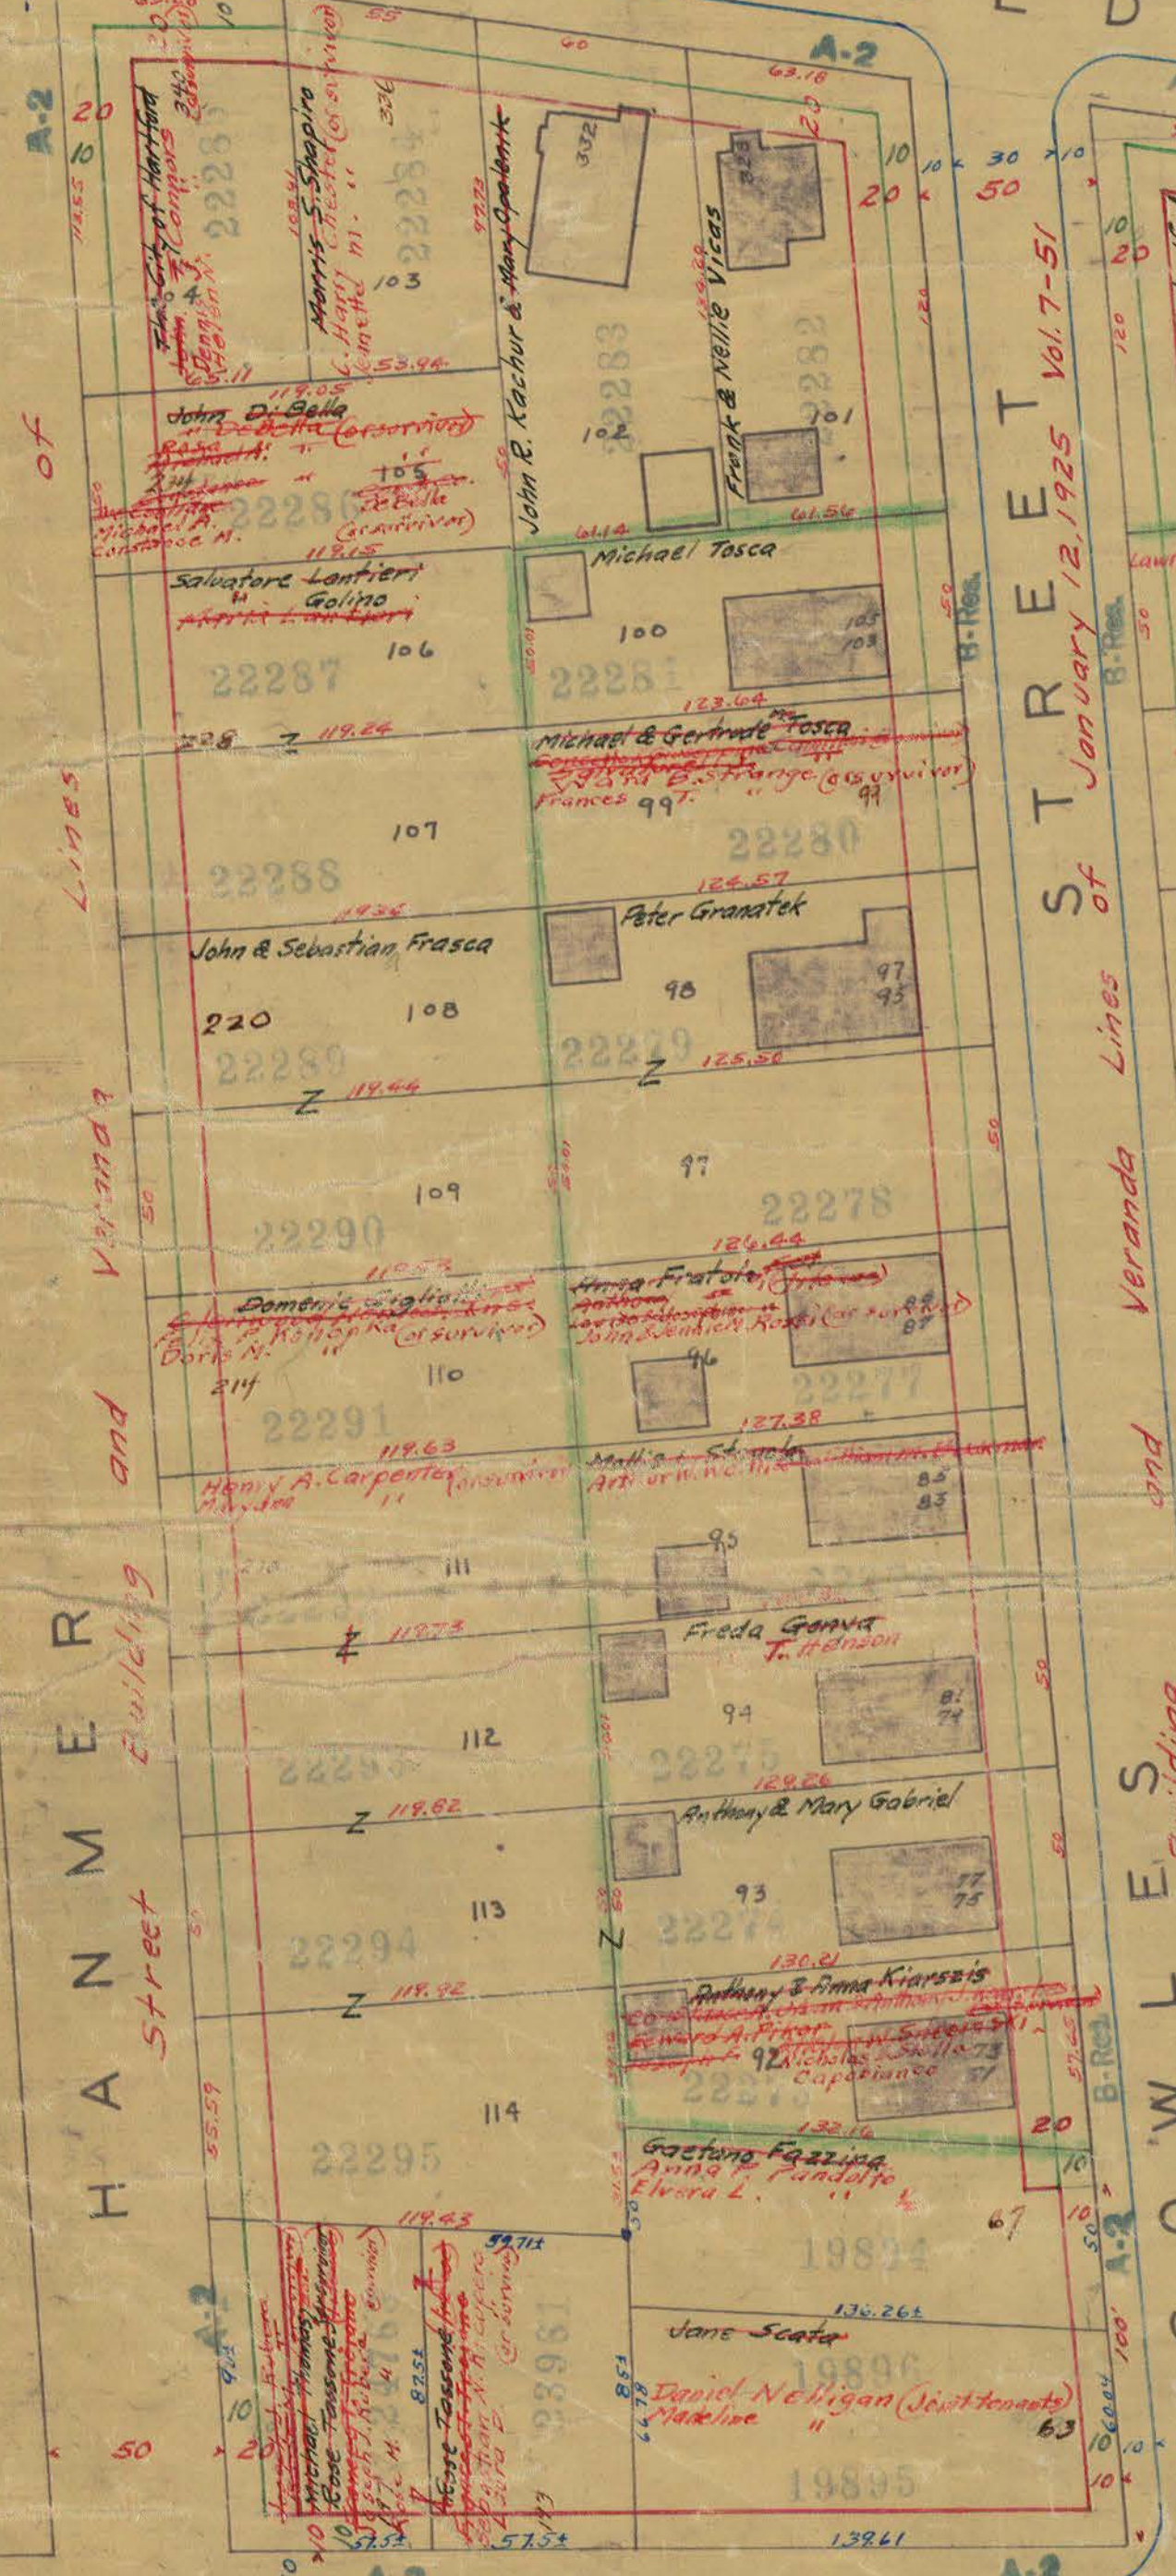

STREET Vol. 7-51
January 12, 1925

HANMER Street

GEORGE Street

Building and Veranda Lines of July 19, 1915 Vol. 6-138

See

ROOSEVELT STREET

Sheet

165

1915