


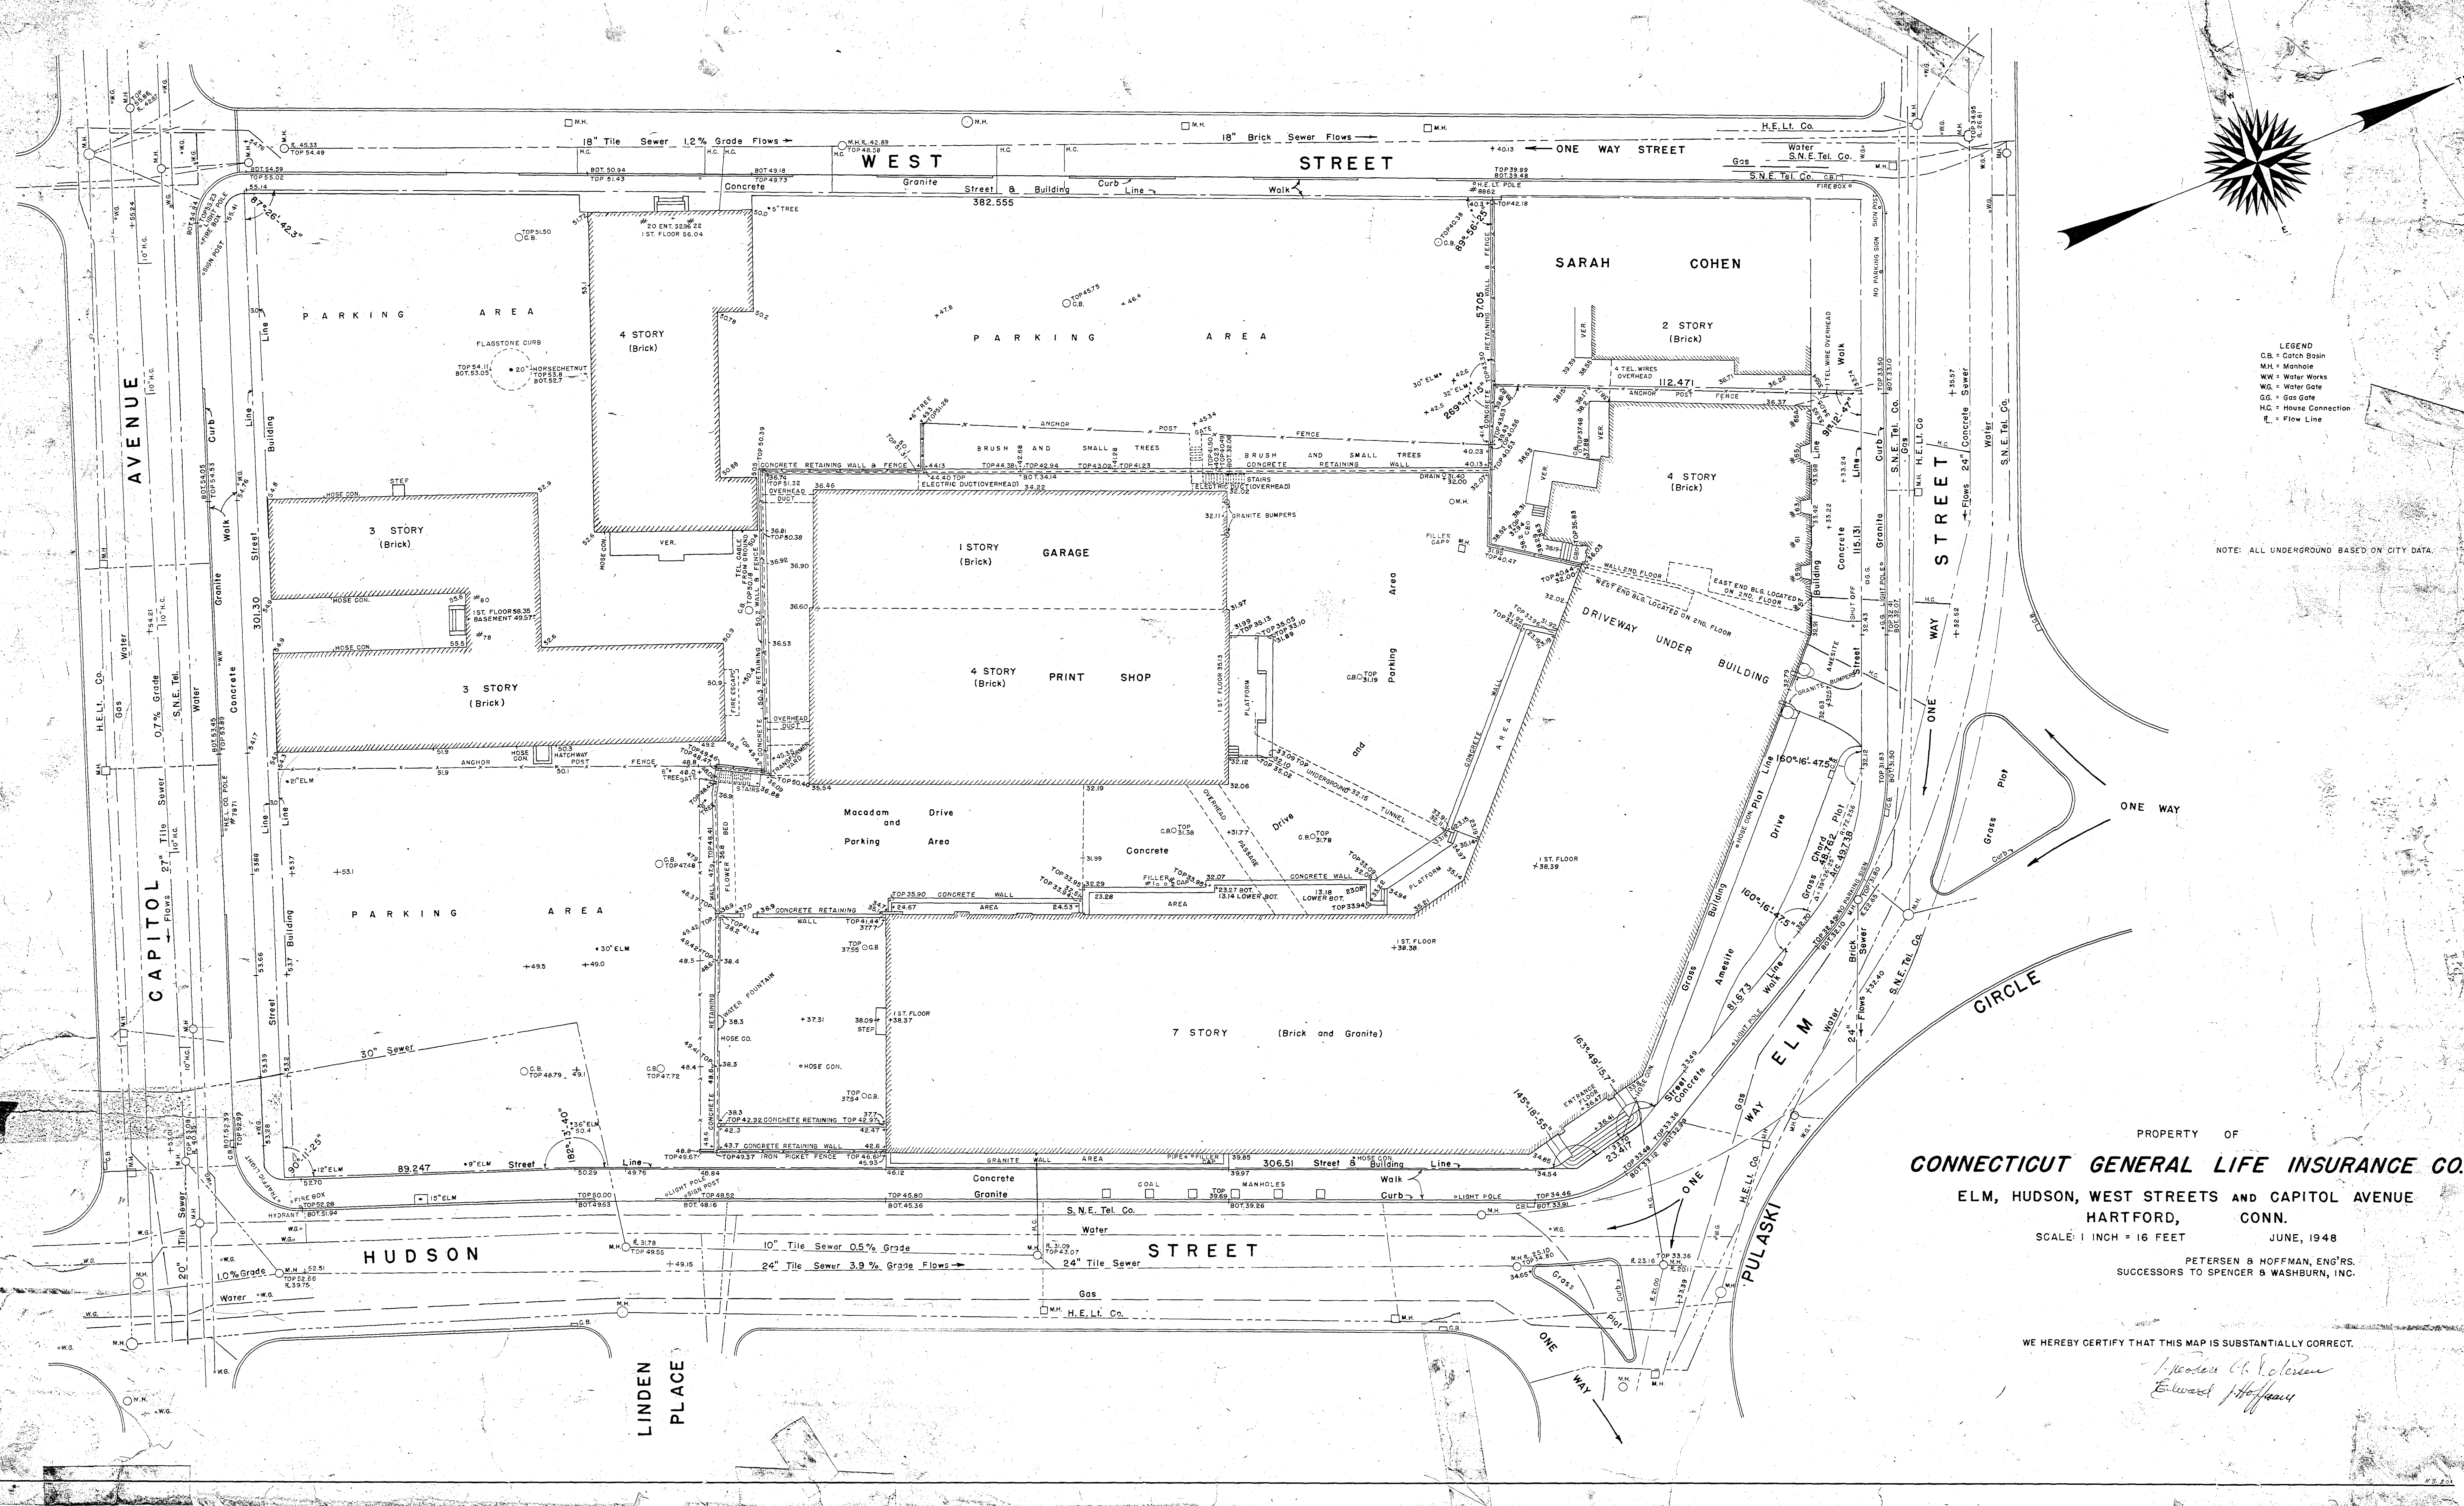

- LEGEND
- C.B. = Catch Basin
 - M.H. = Manhole
 - W.W. = Water Works
 - W.G. = Water Gate
 - G.C. = Gas Gate
 - H.C. = House Connection
 - F. = Flow Line

NOTE: ALL UNDERGROUND BASED ON CITY DATA.

PROPERTY OF
CONNECTICUT GENERAL LIFE INSURANCE CO.

ELM, HUDSON, WEST STREETS AND CAPITOL AVENUE
HARTFORD, CONN.

SCALE: 1 INCH = 16 FEET

JUNE, 1948

PETERSEN & HOFFMAN, ENG'RS.
SUCCESSORS TO SPENCER & WASHBURN, INC.

WE HEREBY CERTIFY THAT THIS MAP IS SUBSTANTIALLY CORRECT.

Edward Hoffman