
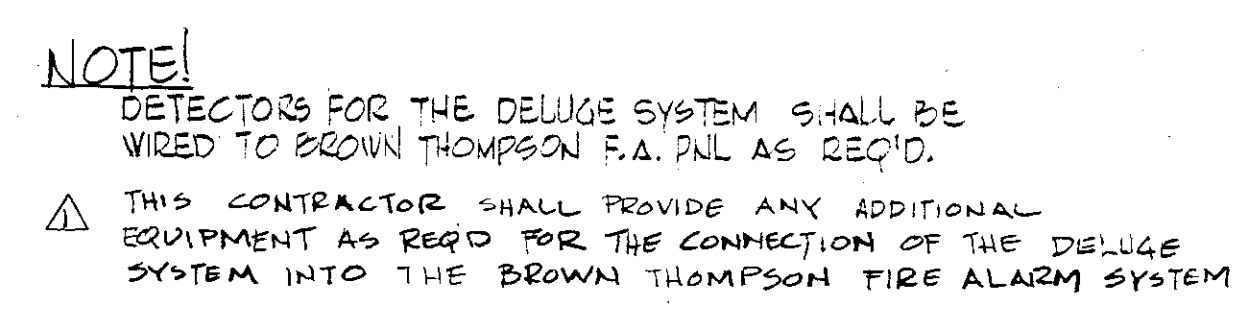


PART PLAN. SITE LIGHTING.  
SCALE - 1/4" = 1'-0"

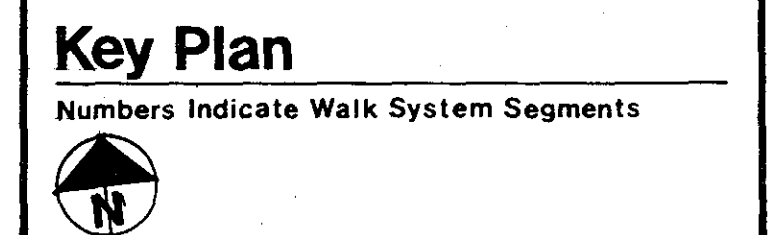

SECOND FLOOR PLAN (EL 89.955)  
SCALE: 1/8" = 1'-0"

[illegible][illegible][illegible]

**Construction Manager**  
Cusim Construction Services Corporation  
Box 14510 Barry Square Station  
Hartford, Ct. 06114 203/278-1540

---


---

**Mechanical Engineers**  
Koton, Allen & Associates, Inc.  
510 Cottage Grove Road  
Bloomfield, Ct. 06002 203/243-1701

---

---

**Landscape Architect**  
Johnson & Deo  
Brownstone Court  
Aves. Ct. 06001 203/678-0669



PLANS PREPARED BY

**ih** ARCHITECTS

IRWIN JOSEPH HIRSCH & ASSOCIATES, INC.  
231 FARMINGTON AVE. / FARMINGTON, CT. 06032

203/677-0273

<p>FLOOR PLAN LIGHTING &amp; POWER</p>	
<p><b>Hartford Walk System - Mixmaster</b> Hartford, Connecticut</p>	
<p>Project Number 11H-210-II</p>	<p>Drawing Number <b>1E - 2</b></p>
<p>Scale AS NOTED</p>	