



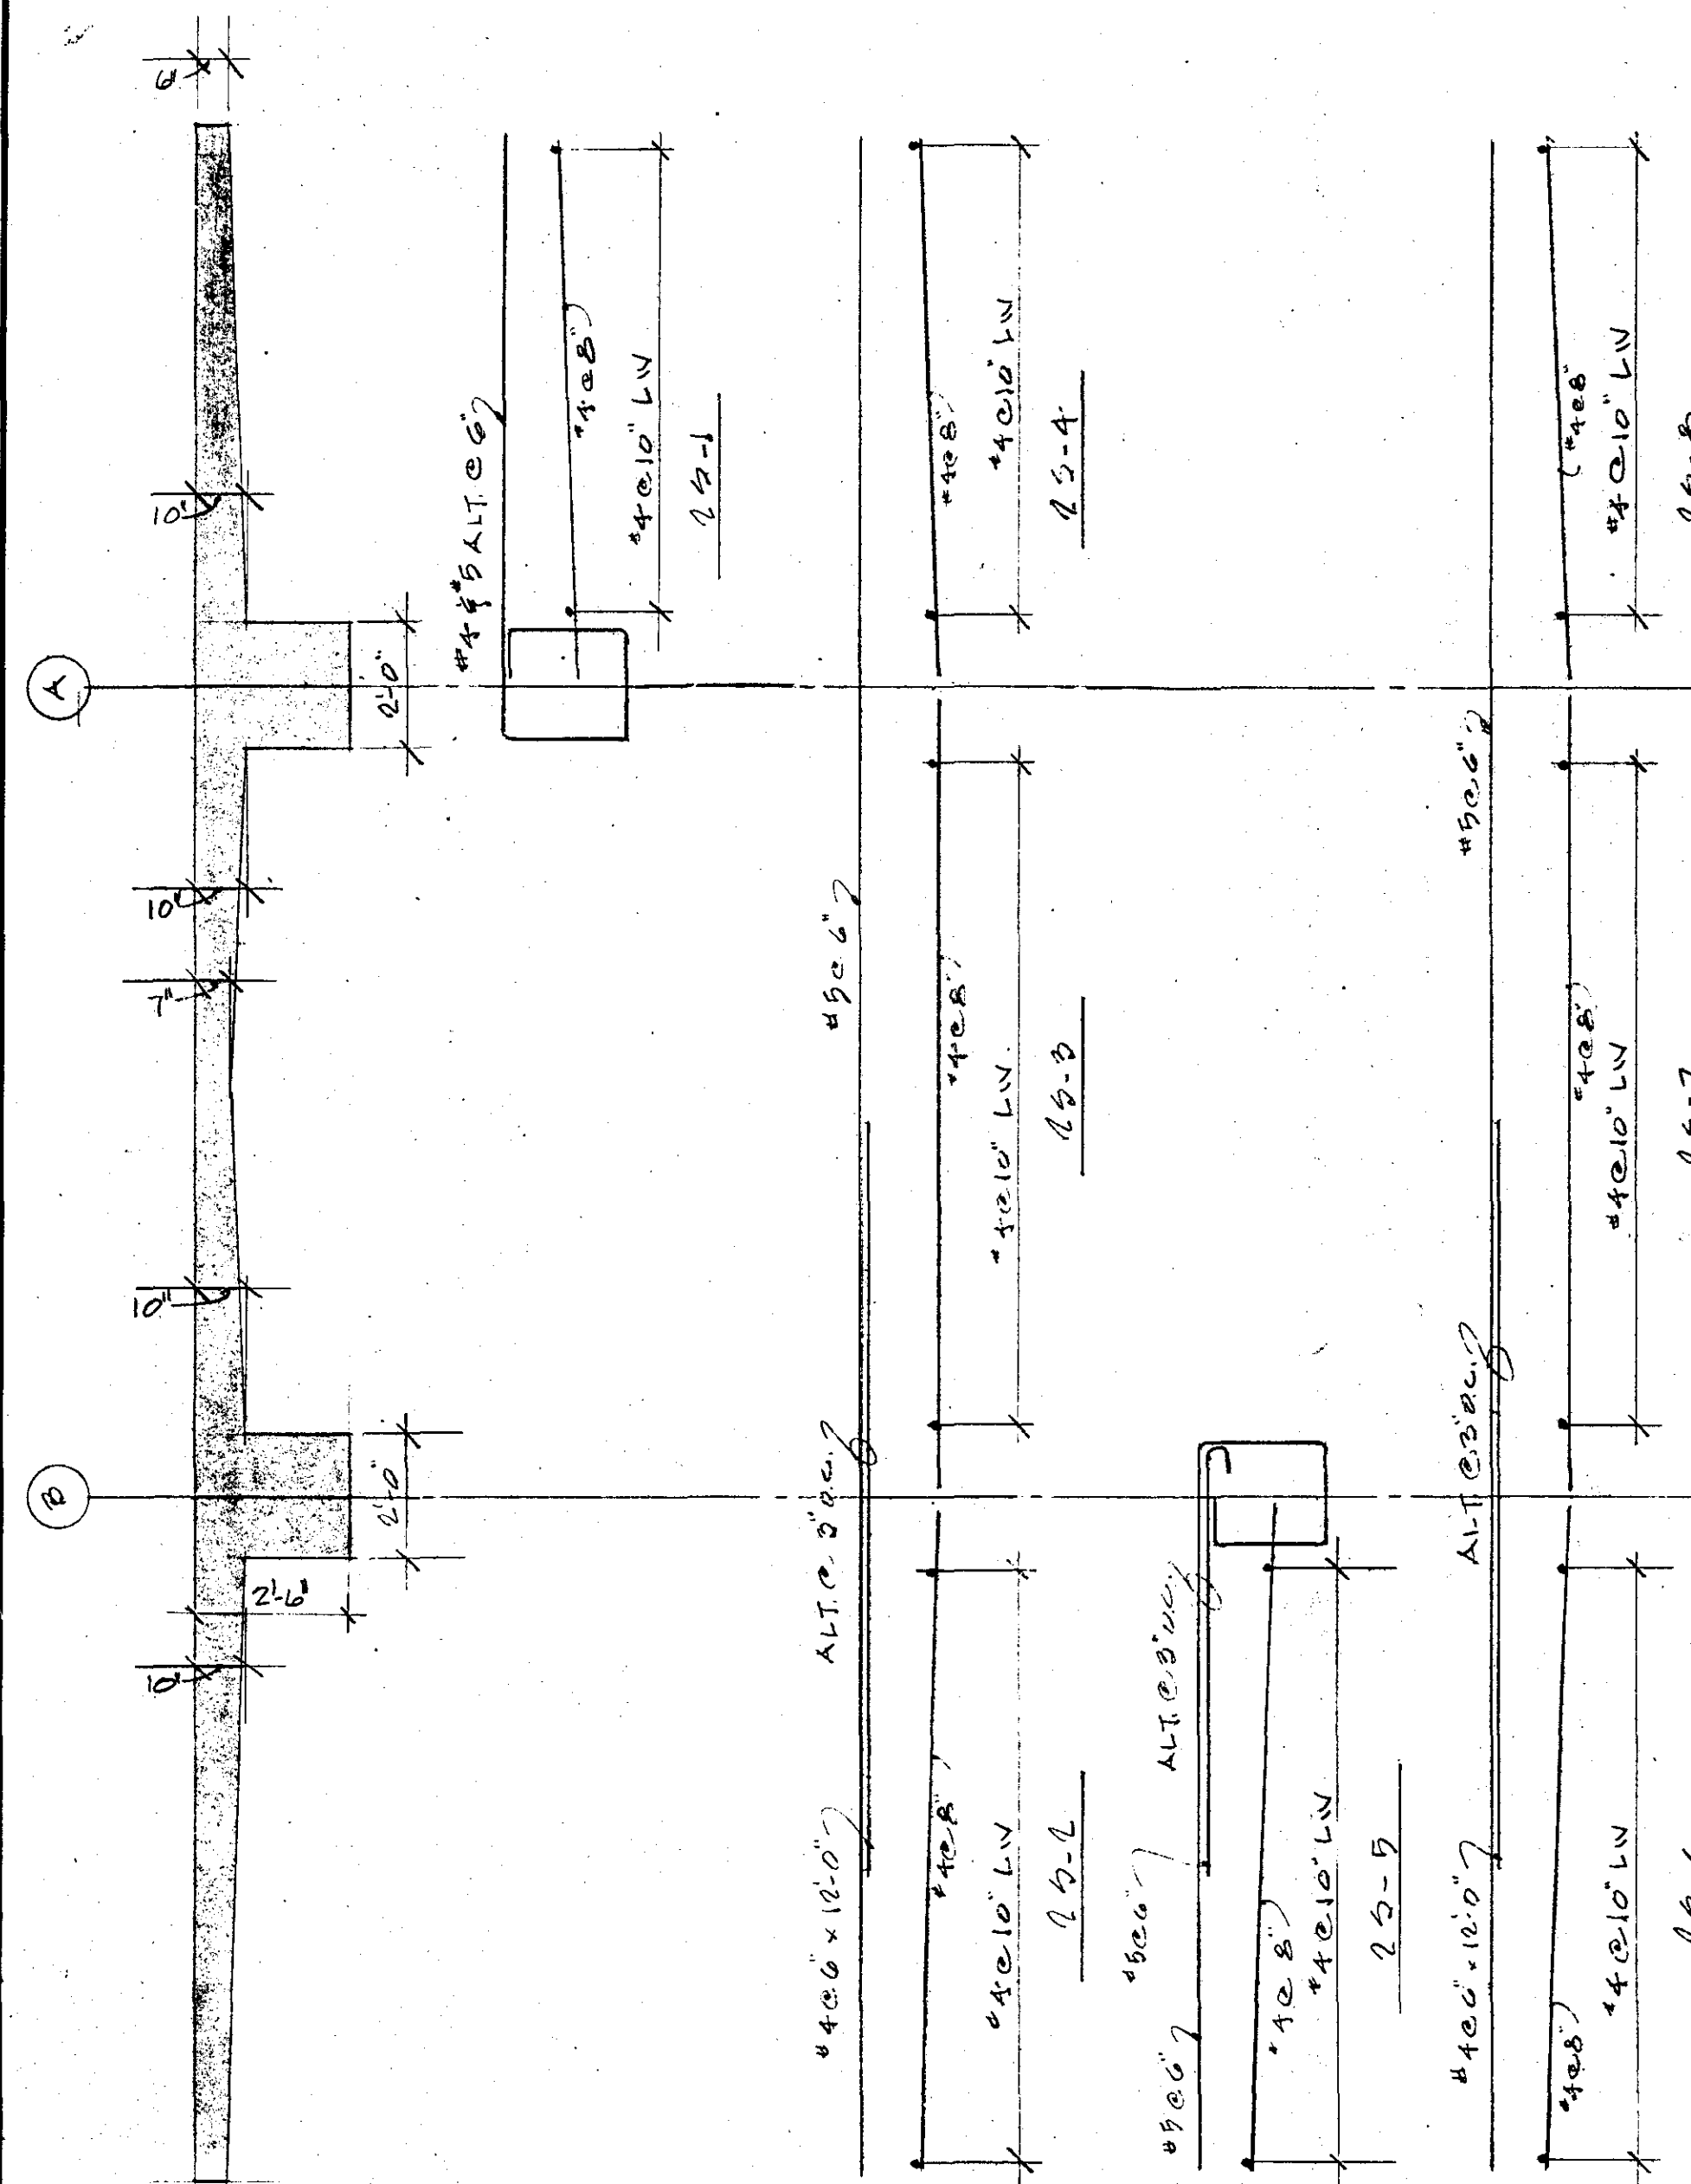


11/10/1963

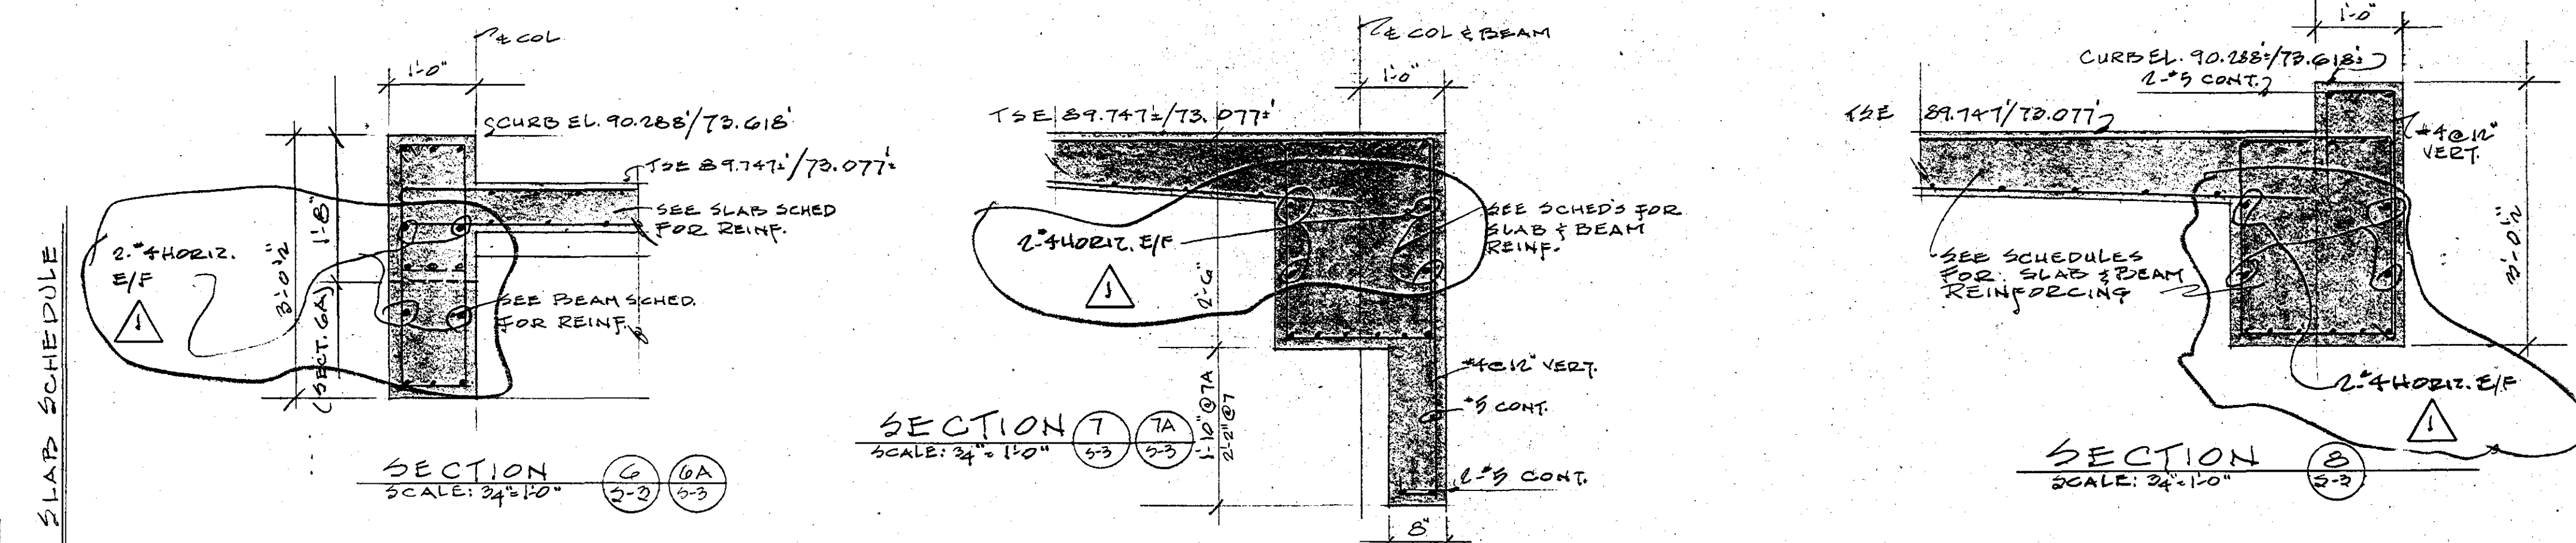

SECTION
SCALE: 34"=1'-0"

SECTION 7 7A
SCALE: 3/4" = 1'-0" 5-3 5-3 1'-10" 2'-2"

SECTION
SCALE: 3/4" = 1'-0"

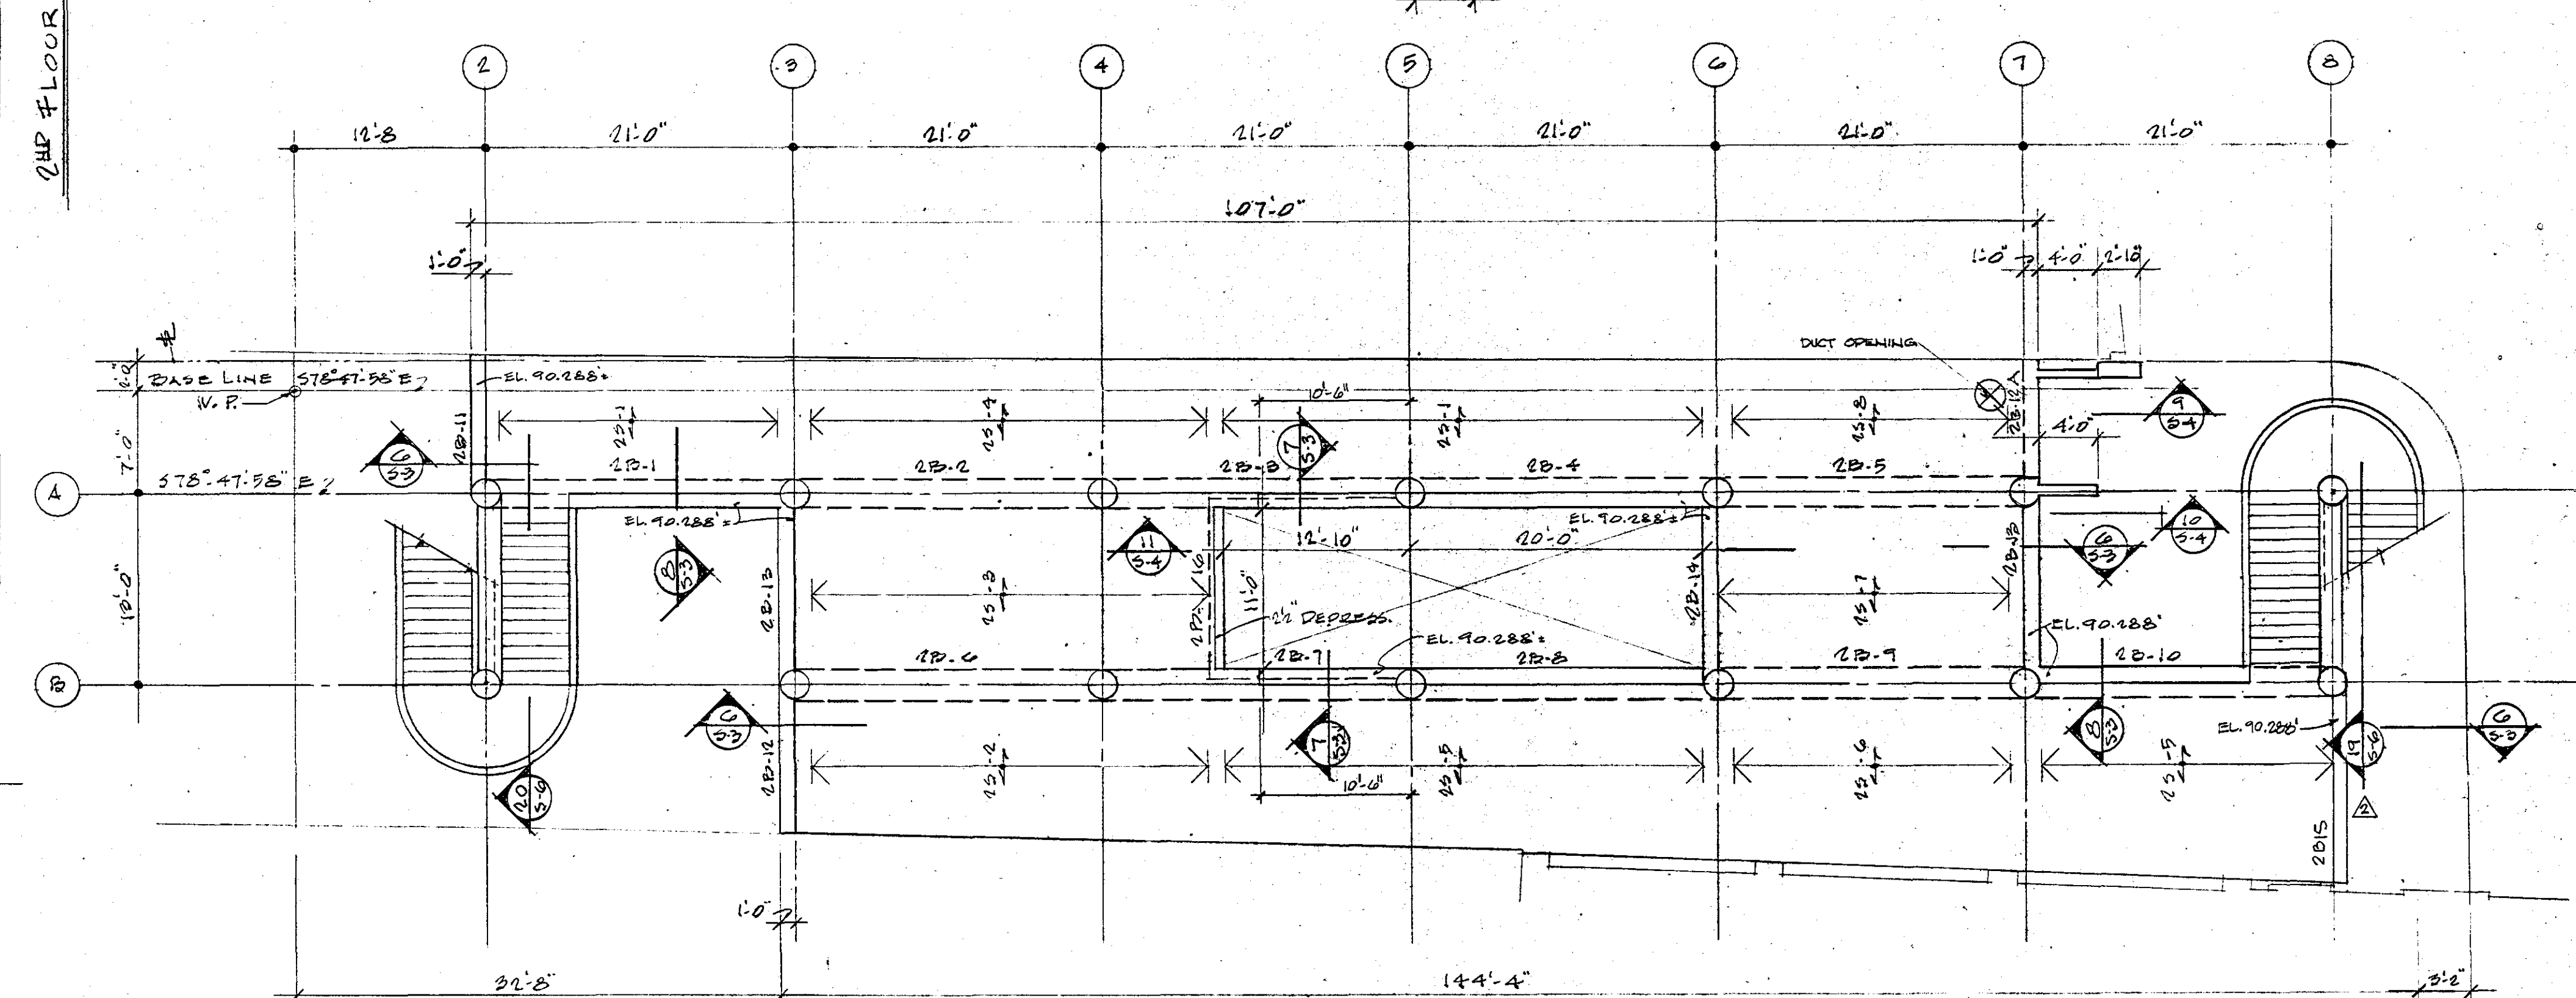

SECOND FLOOR FRAMING PLAN - (USE 89.7472)

[illegible]

Use and Interpretation of This Drawing

1. Except as may be otherwise shown or stated, Work not completely delineated herein is accordance with the applicable Legend shall be constructed of the same materials, and subject to the same requirements, as Work that is shown, and shall conform to similar dimensions on this or other Drawings furnished for this Project by the Architect.

2. AFTER SIGNATURE OF THE CONSTRUCTION CONTRACT applicable to Work indicated hereon, except as may be otherwise shown or noted, each issue of this Drawing is intended as a "Written Interpretation of the Contract Documents," or as an "Order for Change in the Work," or both to supersede previous issues of this Drawing. In instances where the Contractor has been notified in writing by the Architect of a Contract Document unless a claim is made by written notice to the Architect within the period established by the Construction Contract, which is 20 days after the date upon which the Contractor received the original of the Contract Documents, AIA document A-201, June 1983, (Reference: General Conditions of the Contract, AIA document A-201, June 1983).

Revisiting after Partial or Full Release

...the ...

Project Number	Drawing Number
----------------	----------------

