



FOOTING SCHEDULE				
MARK	FOOTING SIZE	REINFORCING	EA. WAY	
WIDTH	LENGTH	DEPTH		
A	4'-0"	4'-0"	1'-0"	7-#9-HOOK/E
B	5'-0"	5'-0"	1'-4"	7-#6
C	5'-4"	5'-4"	1'-4"	8-#6
D	5'-8"	5'-8"	1'-6"	7-#6
E	4'-0"	4'-0"	1'-0"	6-#4
F	2'-4"	6'-0"	1'-0"	4-#4 LW 8-#4 S.W.

NOTES: 1. REFER TO PIER SCHEDULE FOR POWELS TO FIT.

PIER SCHEDULE				
COLUMN NUMBER	PIER SIZE	REINFORCING	POWELS TO FOOTING	
VERTICAL	HORIZONTAL			
A-1, B-1, A-2, A-3 & B-7	16'-0" (ASSUMED)	10-#5	8-#12	8-#3
A-2, A-7 & A-8	24'-4"	12-#7	8-#12	12-#7
A-3, A-4, A-5 & A-6	24'-2"	12-#8	8-#12	12-#8
B-2	24'-2"	10-#9	8-#12	10-#4
B-3 & B-4	24'-2"	12-#9	8-#12	12-#9
B-5, B-6 & B-7	24'-2"	12-#11	8-#12	12-#11
B-8	24'-2"	10-#10	8-#12	10-#10

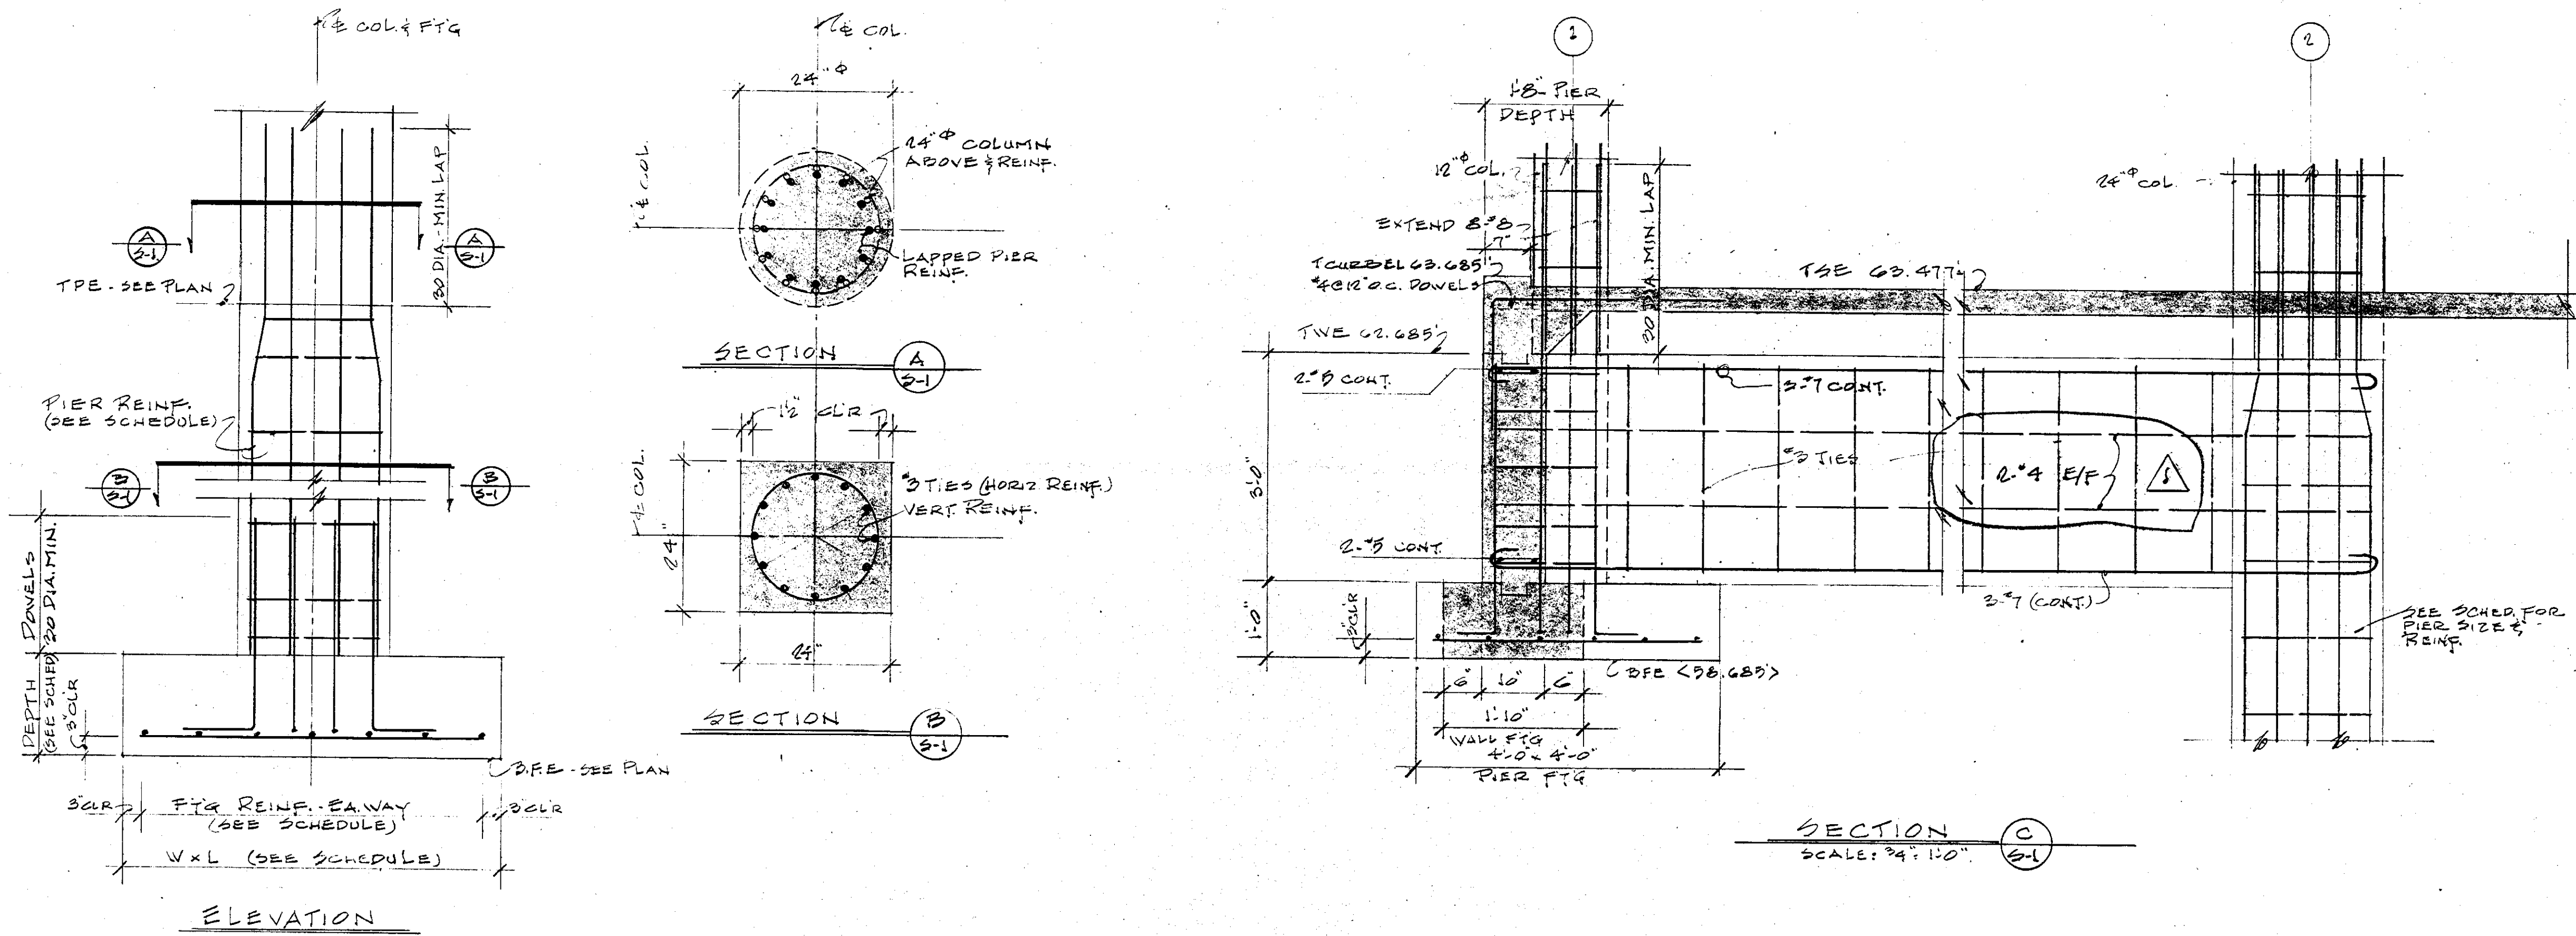


TYPICAL PIER & FOOTING DETAIL
SCALE: 3/4" = 1'-0"

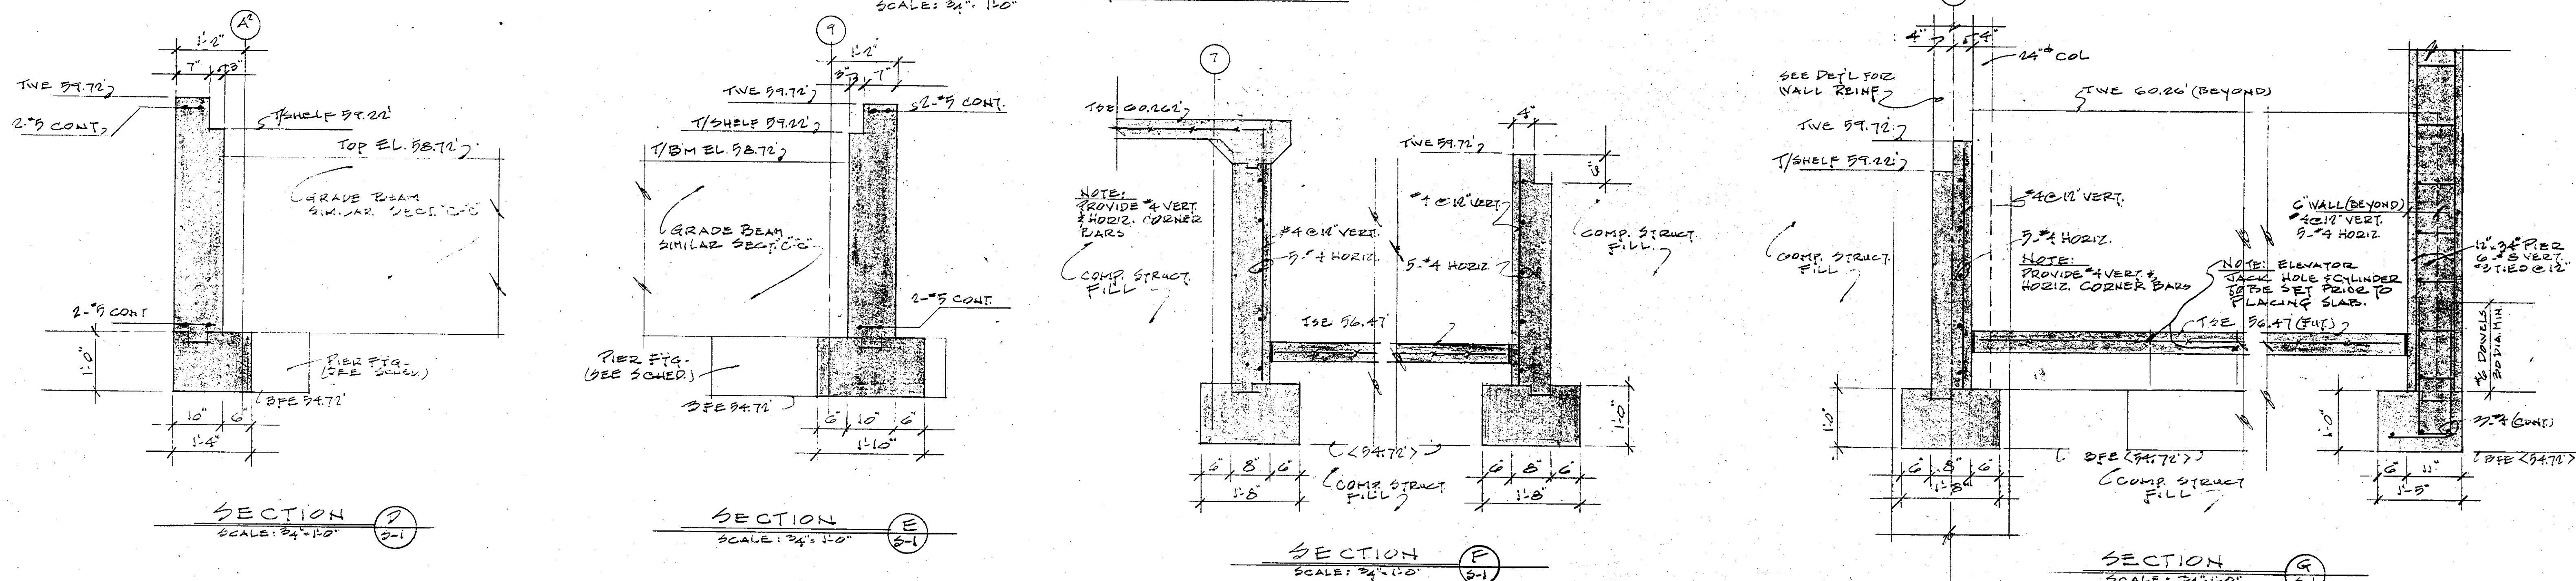

FOUNDATION PLAN
SCALE: 3/4" = 1'-0"

GENERAL NOTES:

- EXCAVATION TO BE INDICATED ON PLAN DEFINE THE ASSUMED BUILDING ELEVATIONS FOR ESTIMATING PURPOSES ONLY. SEE SPEC FOR COMPLETE INFORMATION.
- GRADE 3 STRUCTURAL FILL AS DESCRIBED AND INDICATED IN PLANS AND DETAILS ON THE DRAWINGS.
- FOOTINGS SHALL BE BUILT AT ELEVATIONS INDICATED ON PLAN, BEARING ON EITHER ORIGINAL SOIL OR COMPACTED IN PLACE, OR COMPACTED STRUCTURAL FILL DEPENDING ON ACTUAL DEPTH TO WHICH EXCAVATION IS CARRIED.
- COMPACTED STRUCT. FILL TO ELEVATIONS INDICATED ON PLAN TO PROVIDE UNDER ANOTHER CONTRACT.
- NOTES ON PLAN INDICATED THIS (X) WILL BE COMPLETED UNDER ANOTHER CONTRACT.
- THIS CONTRACTOR SHALL PROVIDE COMPACTED STRUCT. FILL FROM TOP OF FILL ELEVATIONS INDICATED TO TOP OF FLOOR SLAB (5" MIN.) AS PER SECTION 0211 OF THE SPECIFICATIONS.

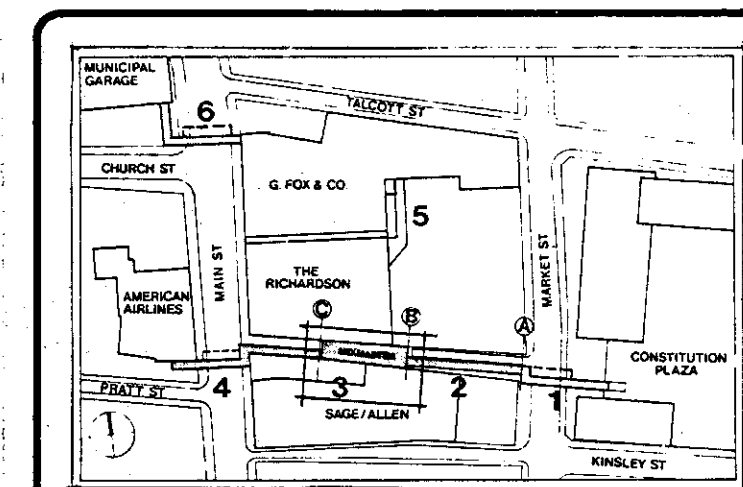

Key Plan
Numbers Indicate Walk System Segments

Issue Dates Prior to Full Release				
Date of Issue	Is this item to be printed in full release?	Issued to	Use restrictions	
8/18/19	Y	W/A	EXHIBITS	
7/2/19	Y	W/A	EXHIBITS	

Use and Interpretation of This Drawing

1. Except as may be otherwise shown or noted, work not completely delineated herein is to be constructed in accordance with the applicable standard specifications for the project, and shall be subject to the same requirements as work that is shown and detailed on the drawings.

2. AFTER ACCEPTANCE OF THE CONSTRUCTION CONTRACT, the work shown on these drawings is to be constructed in accordance with the contract documents, and the drawings are to be used as a guide for the construction of the project.

3. THE CONTRACTOR SHALL BE RESPONSIBLE FOR THE PROTECTION OF ALL UTILITIES AND STRUCTURES EXISTING ON THE SITE, AND FOR THE PROTECTION OF THE WORKMANSHIP OF OTHER CONTRACTORS.



Mark	Date	Nature of revision	Quantity so marked
A	9/12/17	REV. REINFORCING 4" DIM.	

Construction Manager
Green Construction Services Corporation
Box 14510 Bury Square Station
Hartford, Ct. 06114 203/278-1540

Mechanical Engineers
Katon, Allen & Associates, Inc.
510 Cottage Grove Road
Bloomfield, Ct. 06002 203/243-1701

Landscape Architect
Johnson & Deo
Brownstone Court
Avon, Ct. 06001 203/678-0669

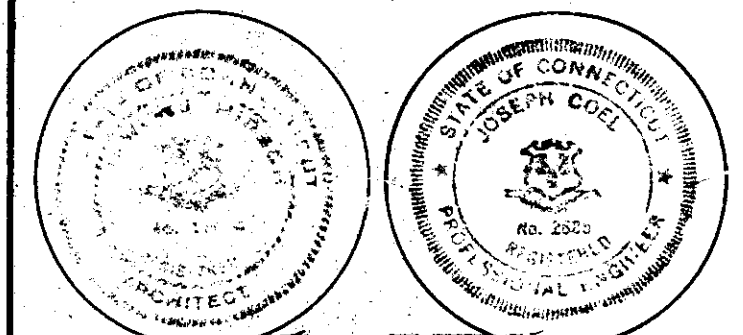

PLANS PREPARED BY
ARCHITECTS
IRWIN JOSEPH HIRTLICH & ASSOCIATES, INC.
291 FARMINGTON AVE., FARMINGTON, CT. 06032
203/677-0273

FOUNDATION PLAN, DETAILS & SCHEDULES

Hartford Walk System - Mixmaster
Hartford, Connecticut

Project Number 11H-210-II	Drawing Number S-1
Scale AS NOTED	