


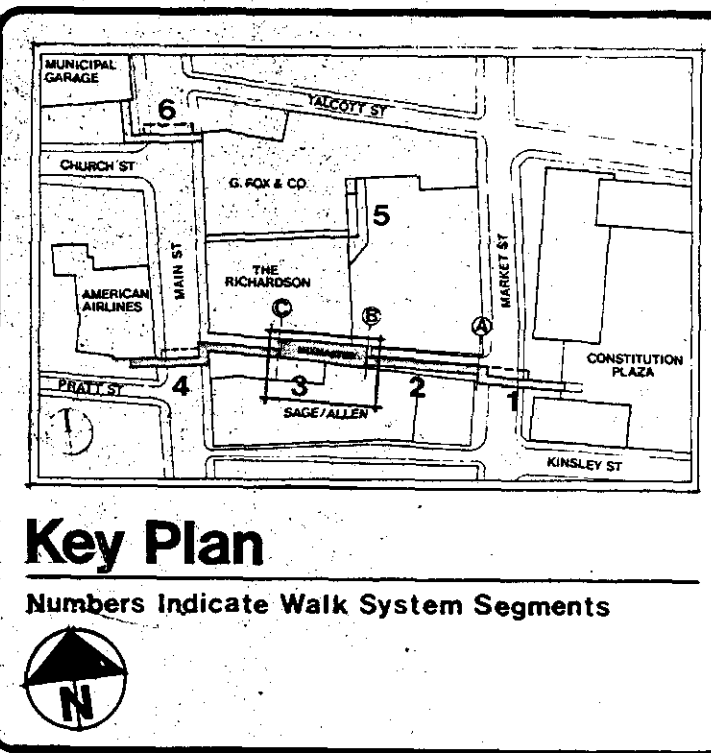

Key Plan

Numbers Indicate Walk System Segments

Issue Dates Prior to Full Release

Date of Issue	Issued to	Use restrictions
01/18/79	4/A	BIDDER'S

Use and Interpretation of This Drawing

1. Except as may be otherwise shown or noted, this set of drawings is to be used in accordance with the applicable codes and regulations of the State of Connecticut and the City of Hartford, and shall be interpreted as such.




Revisions after Partial or Full Release

Mark	Date	Nature of Revision	Quantity
1	9/25/79	MDC REVIEW	

Construction Manager
Cranin Construction Services Corporation
Box 14510 Barre, Square Station
Hartford, Ct. 06114 203/278-1540

Mechanical Engineers
Kotko, Allen & Associates, Inc.
510 Cottage Grove Road
Bloomfield, Ct. 06002 203/243-1701


Landscaping Architect
Johnson & Deo
Aves. Ct. 06001 203/678-0669

PLANS PREPARED BY
ARCHITECTS
JAMES JOSEPH HIRSCH & ASSOCIATES, INC.
291 FARMINGTON AVE. / FARMINGTON, CT. 06032
203/677-0273


SITE UTILITIES PLAN.

Hartford Walk System - Mixmaster


Project Number 11H-210-II	Drawing Number SU-1
------------------------------	------------------------

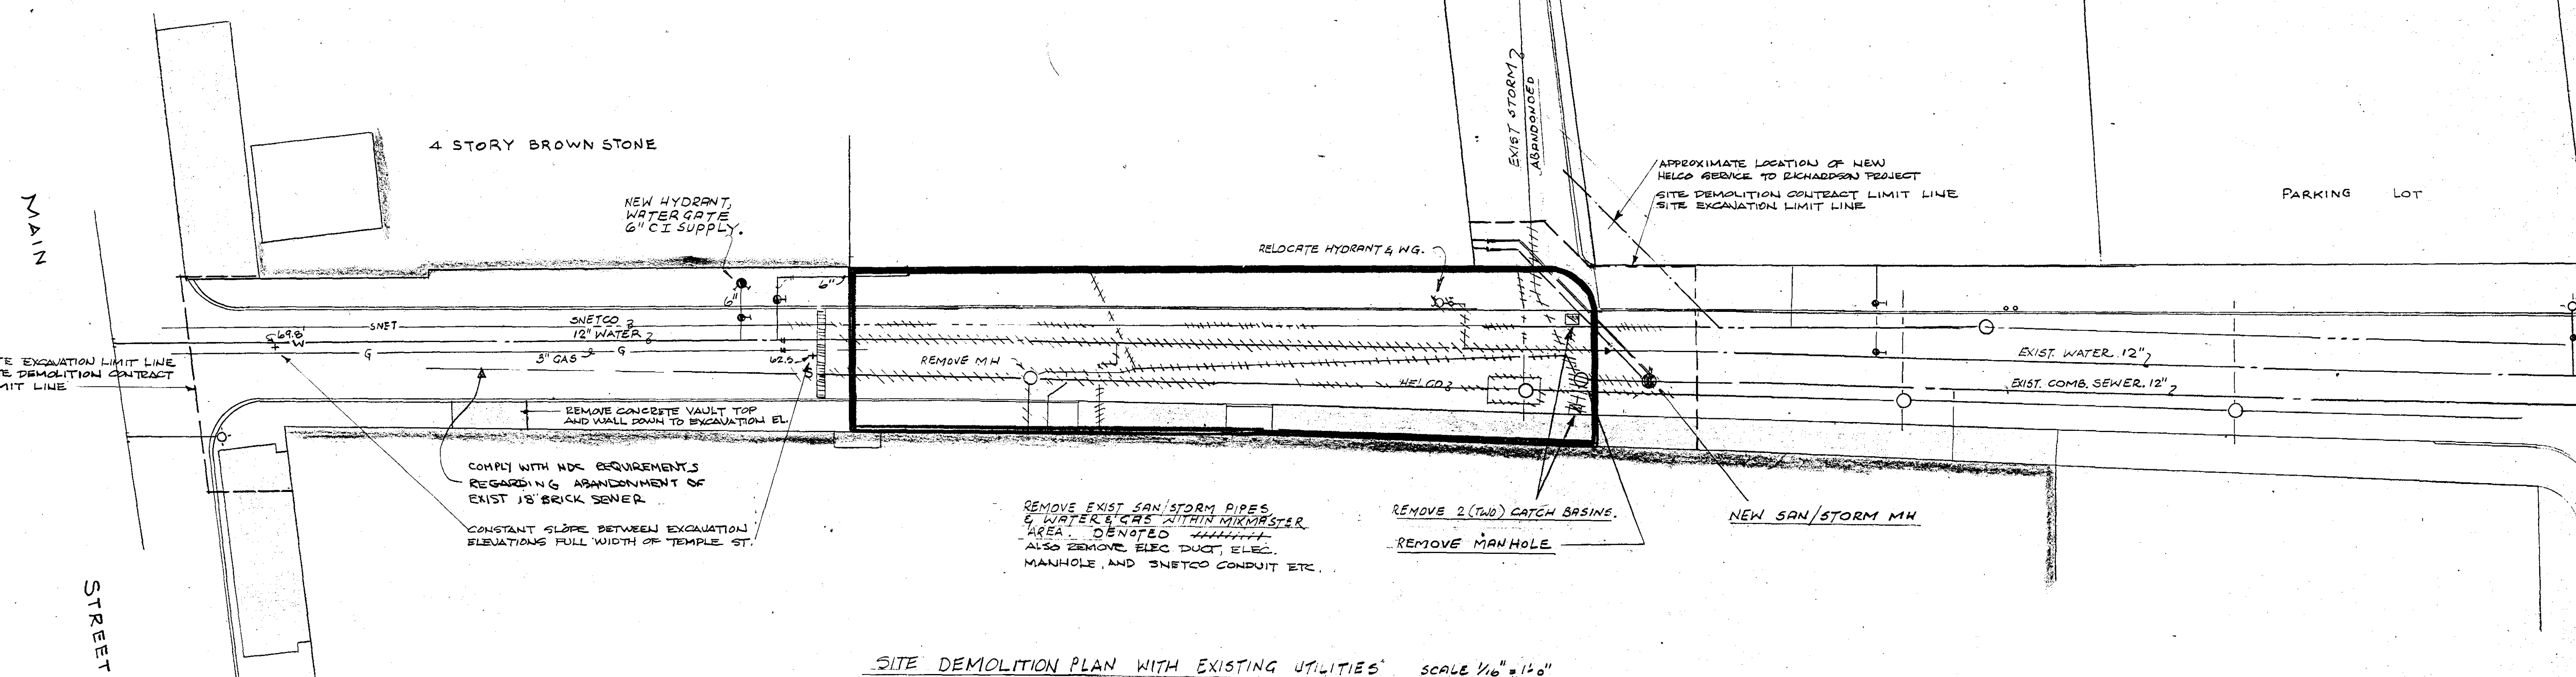



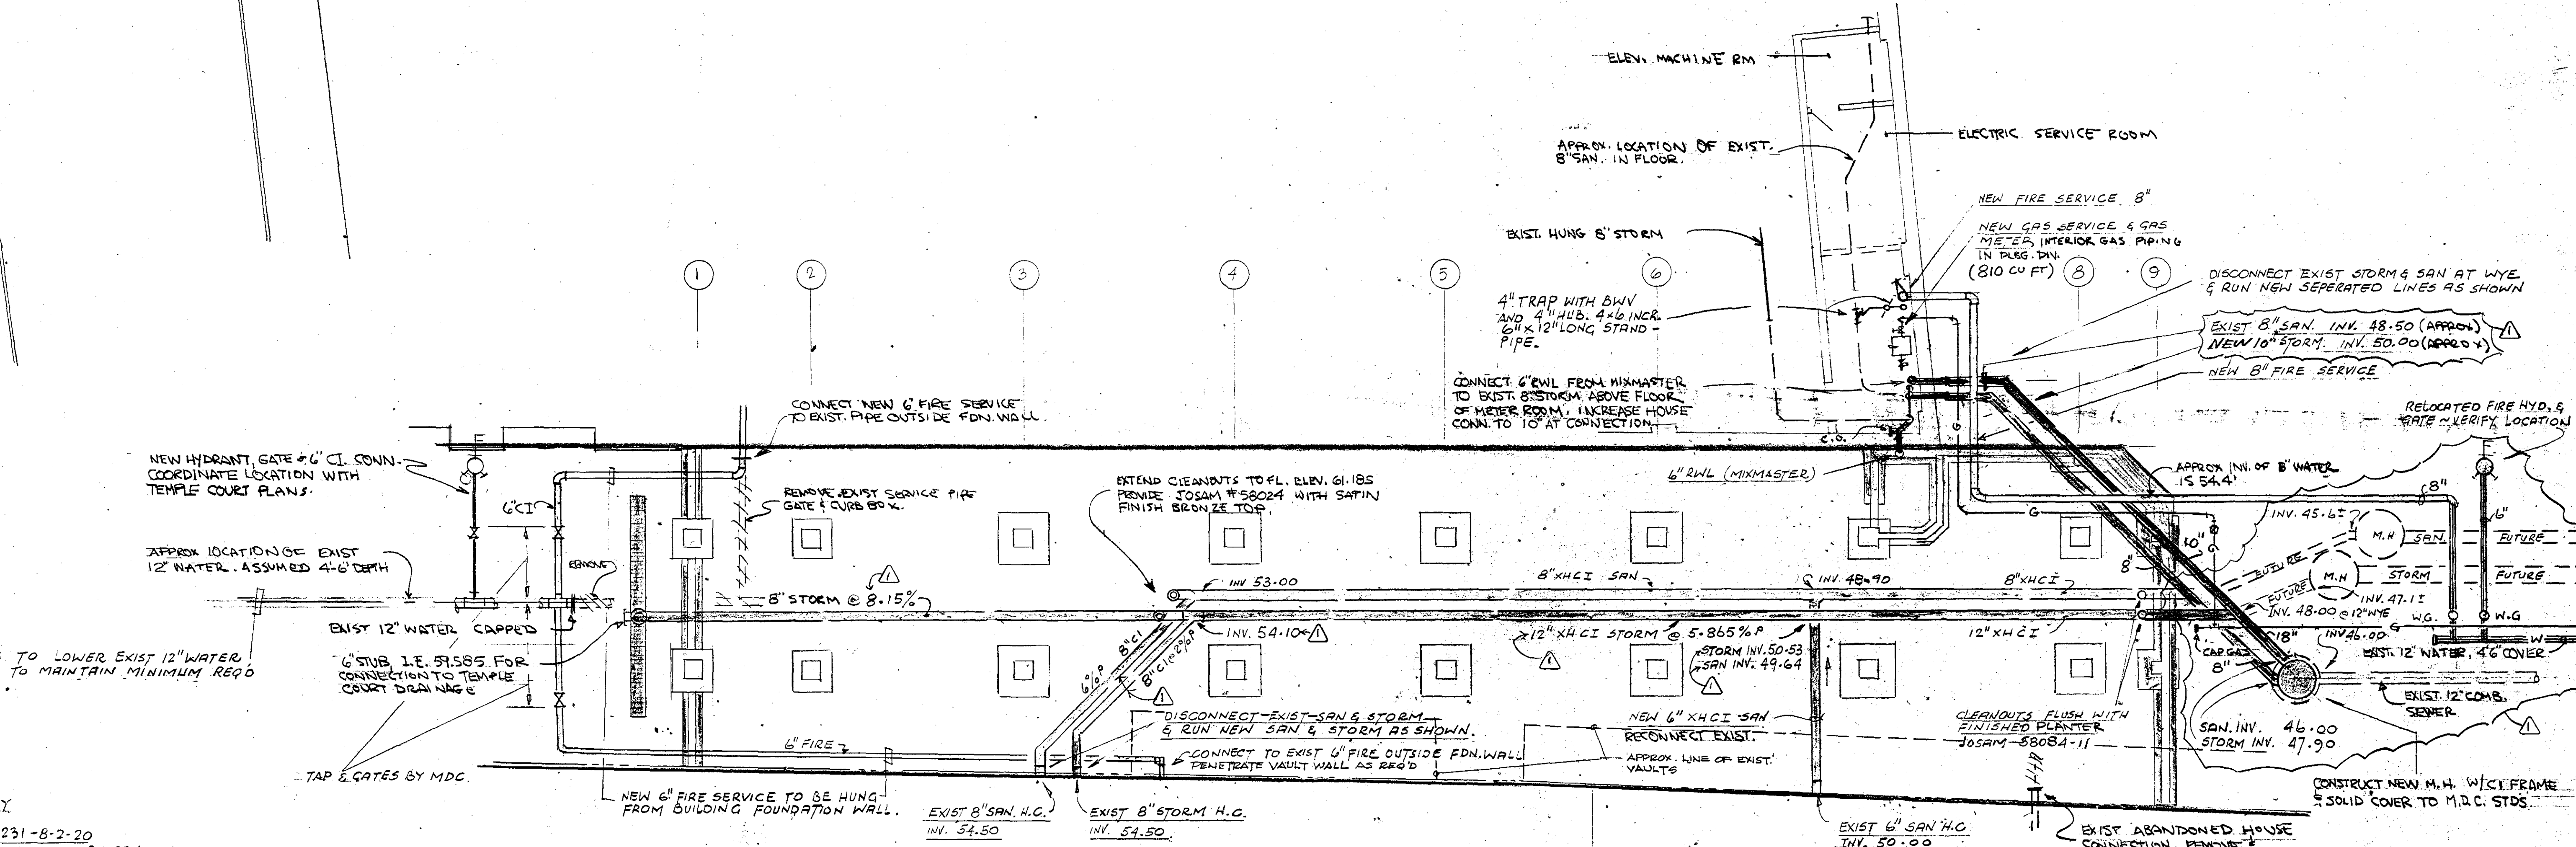

SITE UTILITIES PLAN - SCALE 1/8" = 1'-0"

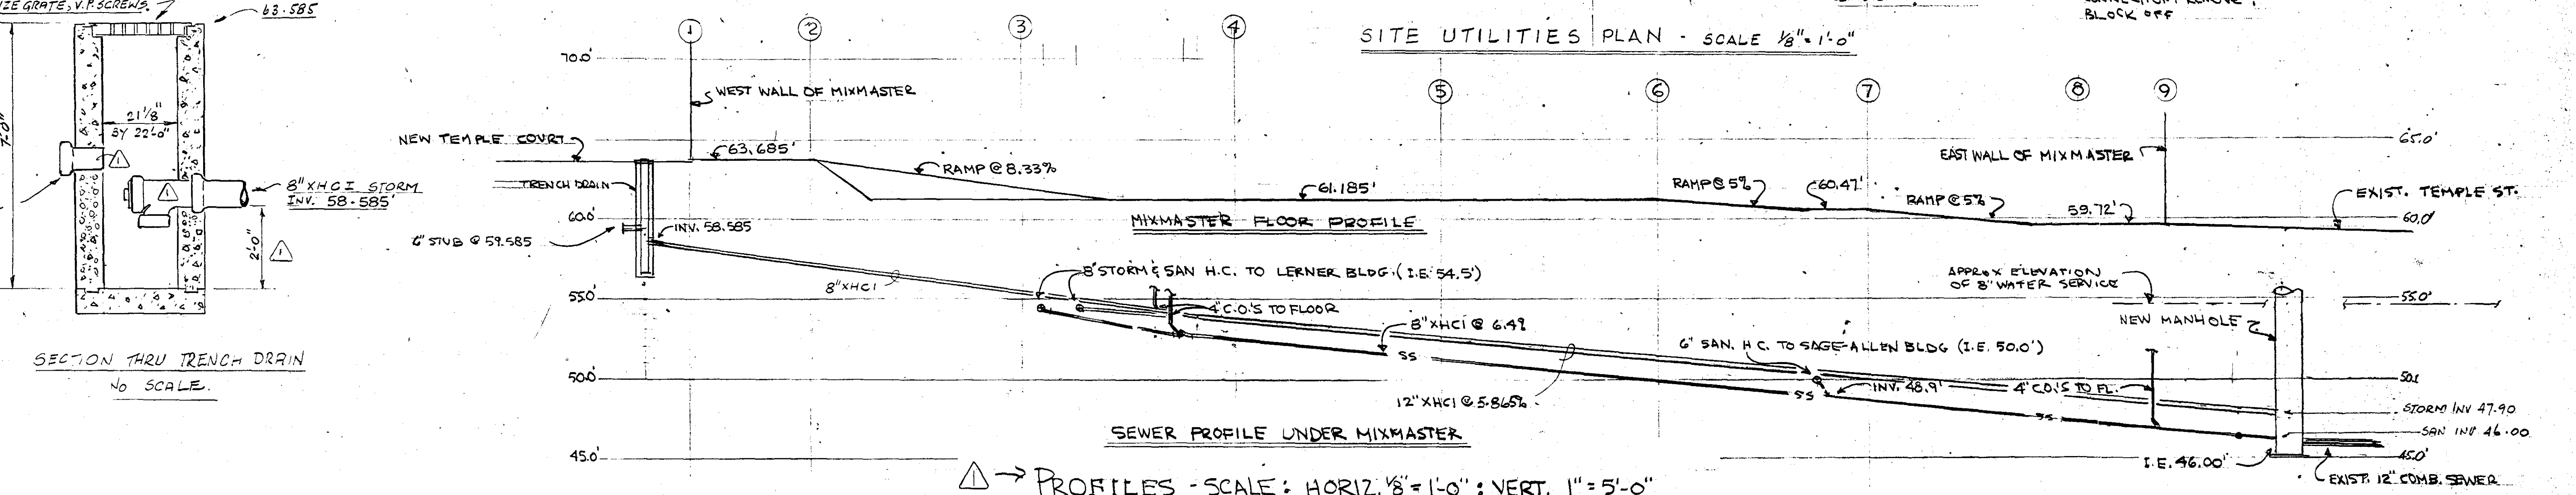

PROFILES - SCALE: HORIZ. 1/8" = 1'-0" : VERT. 1" = 5'-0"

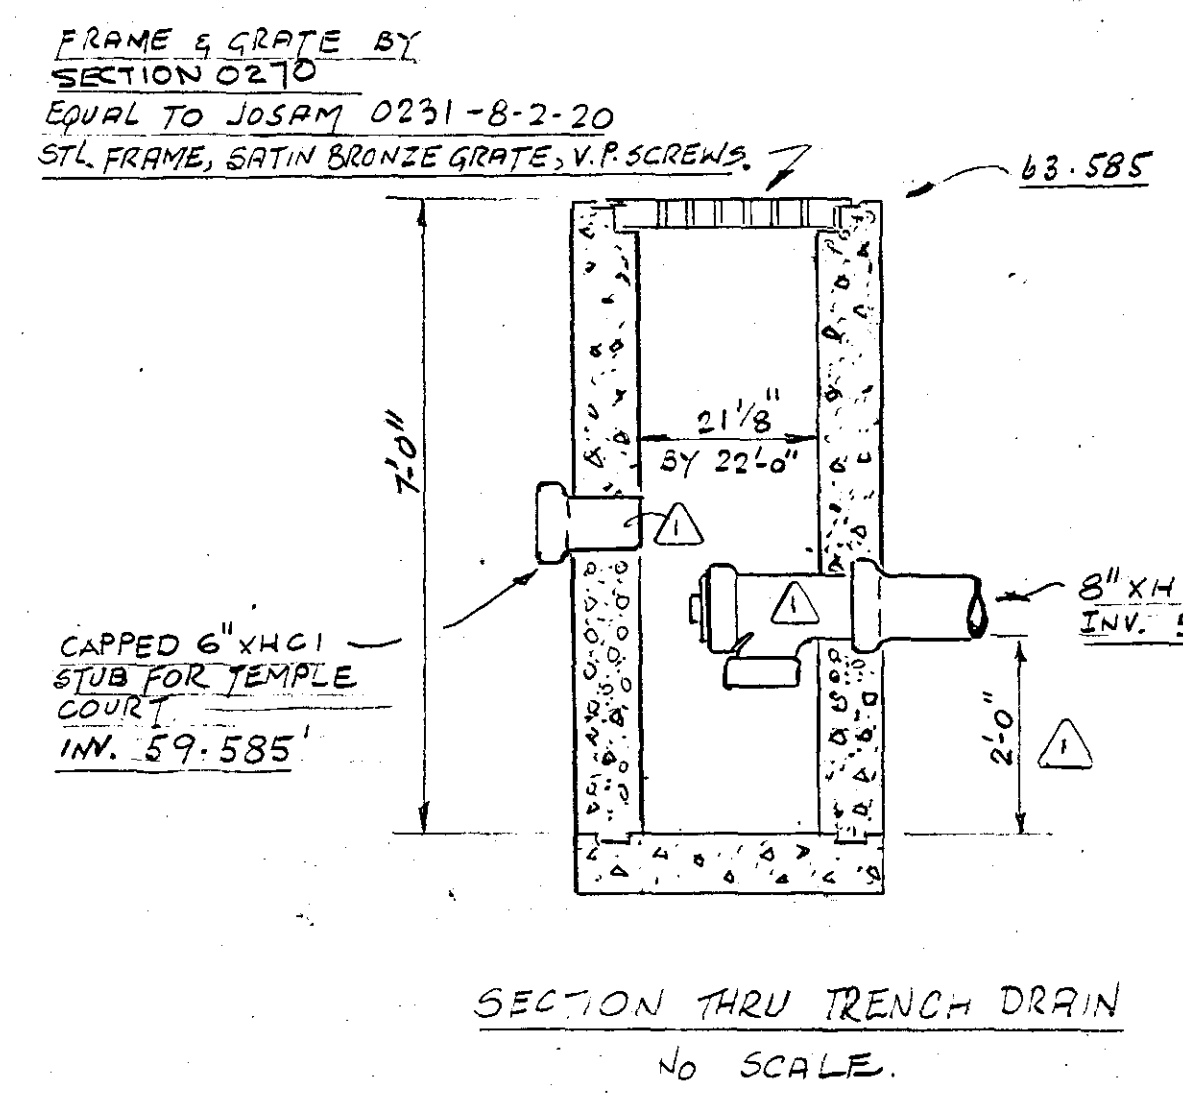

SECTION THRU TRENCH DRAIN NO SCALE