


— SIDE ELEVATION OF BRIDGE —

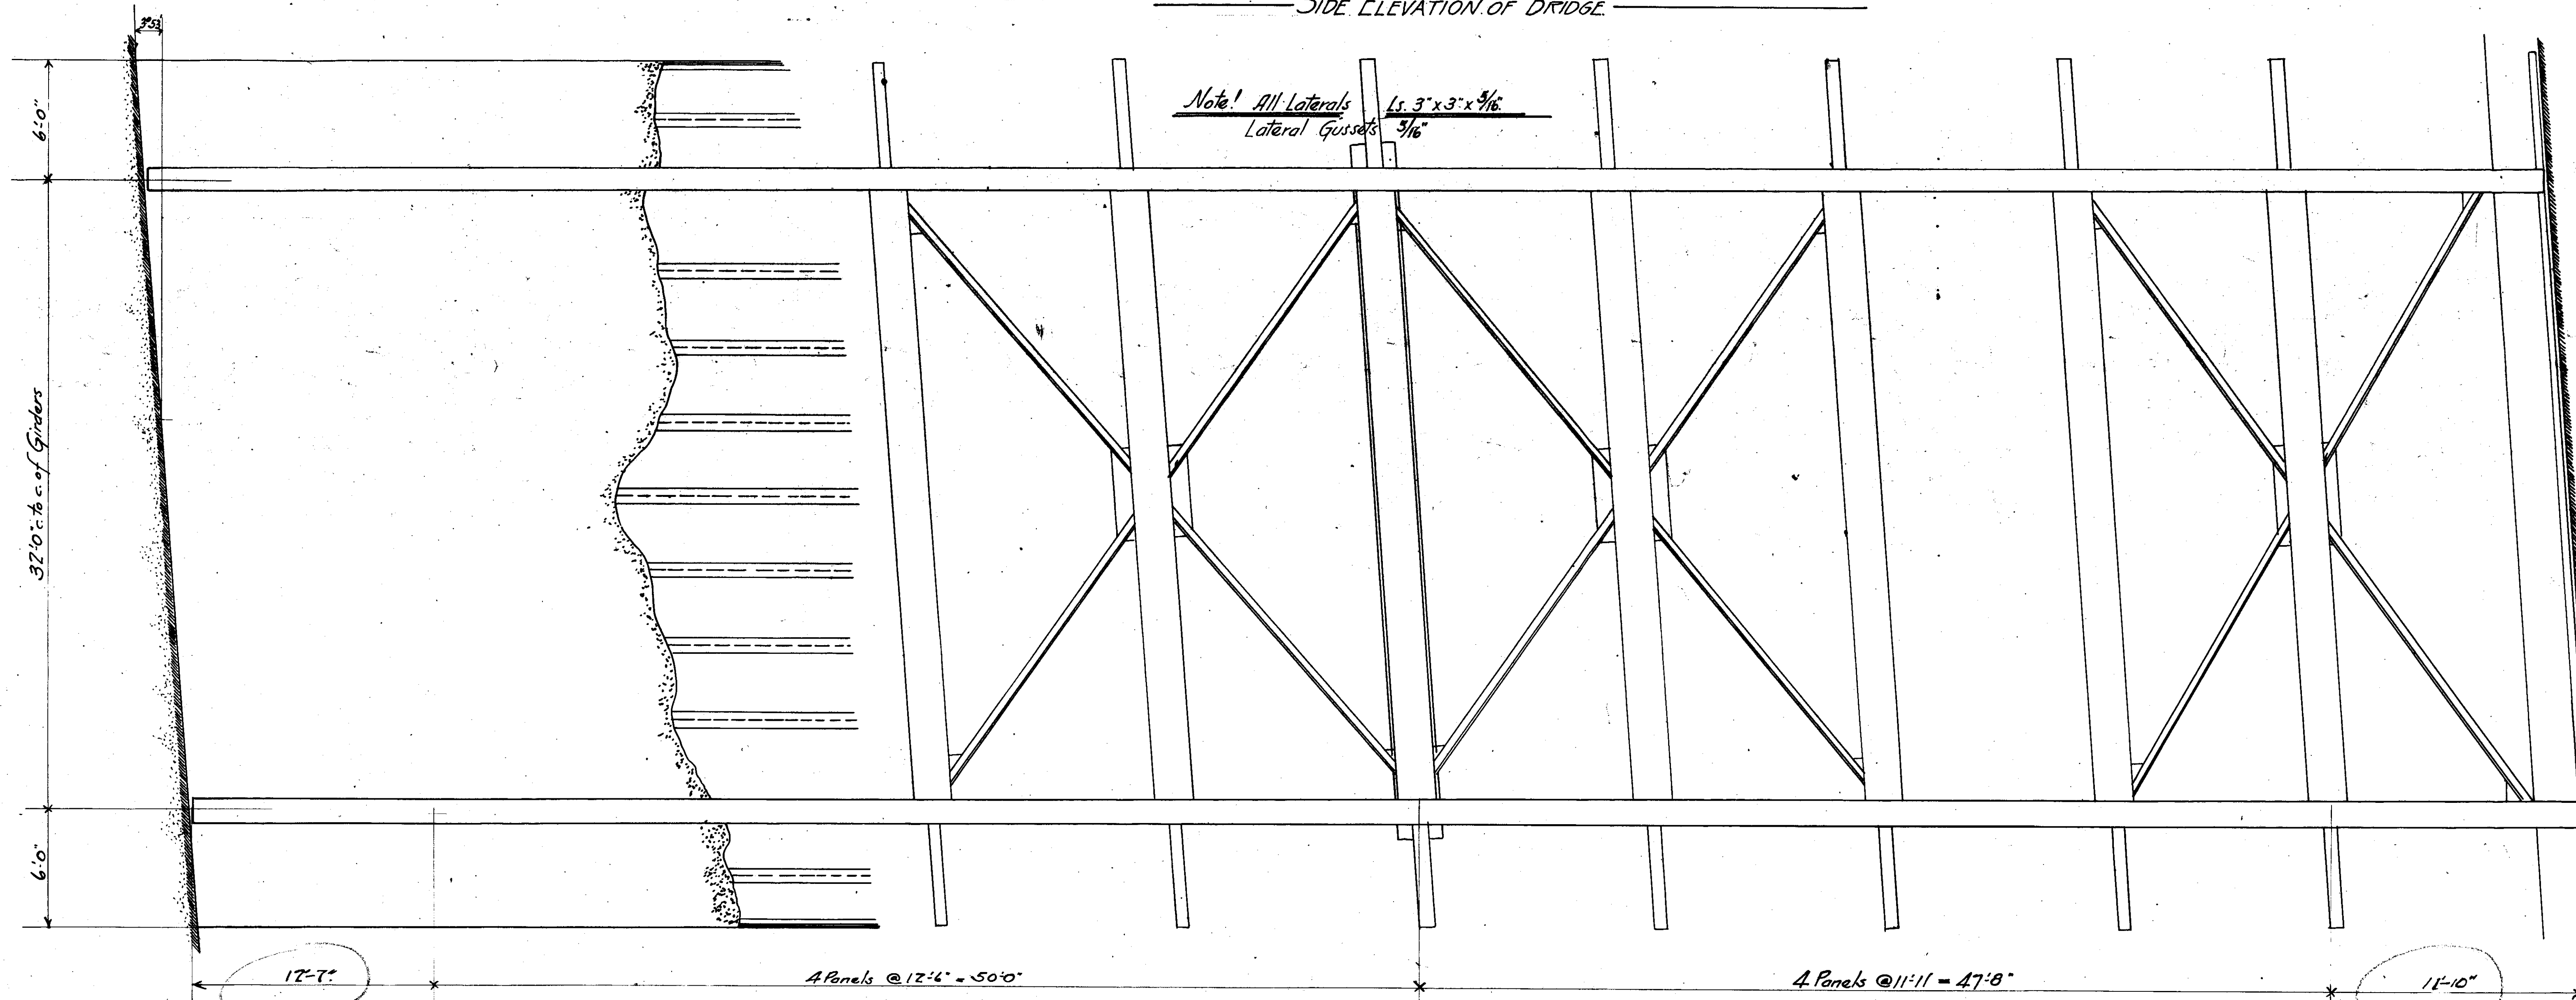

— PLAN —

DESIGN OF PLATE GIRDER BRIDGE OVER N.Y.N.H.&H. AND N.E. P.R. TRACKS

AT

BROAD STREET, HARTFORD, CONN.

THE BERLIN IRON BRIDGE CO., ENGINEERS.
— EAST BERLIN, CONN. —

SCALE 1/4"=1'

See 164-11

See 164-11

Using panel lengths on 164-11
makes over all length of girder
check actual bridge - 12-5-32
W.S.H.