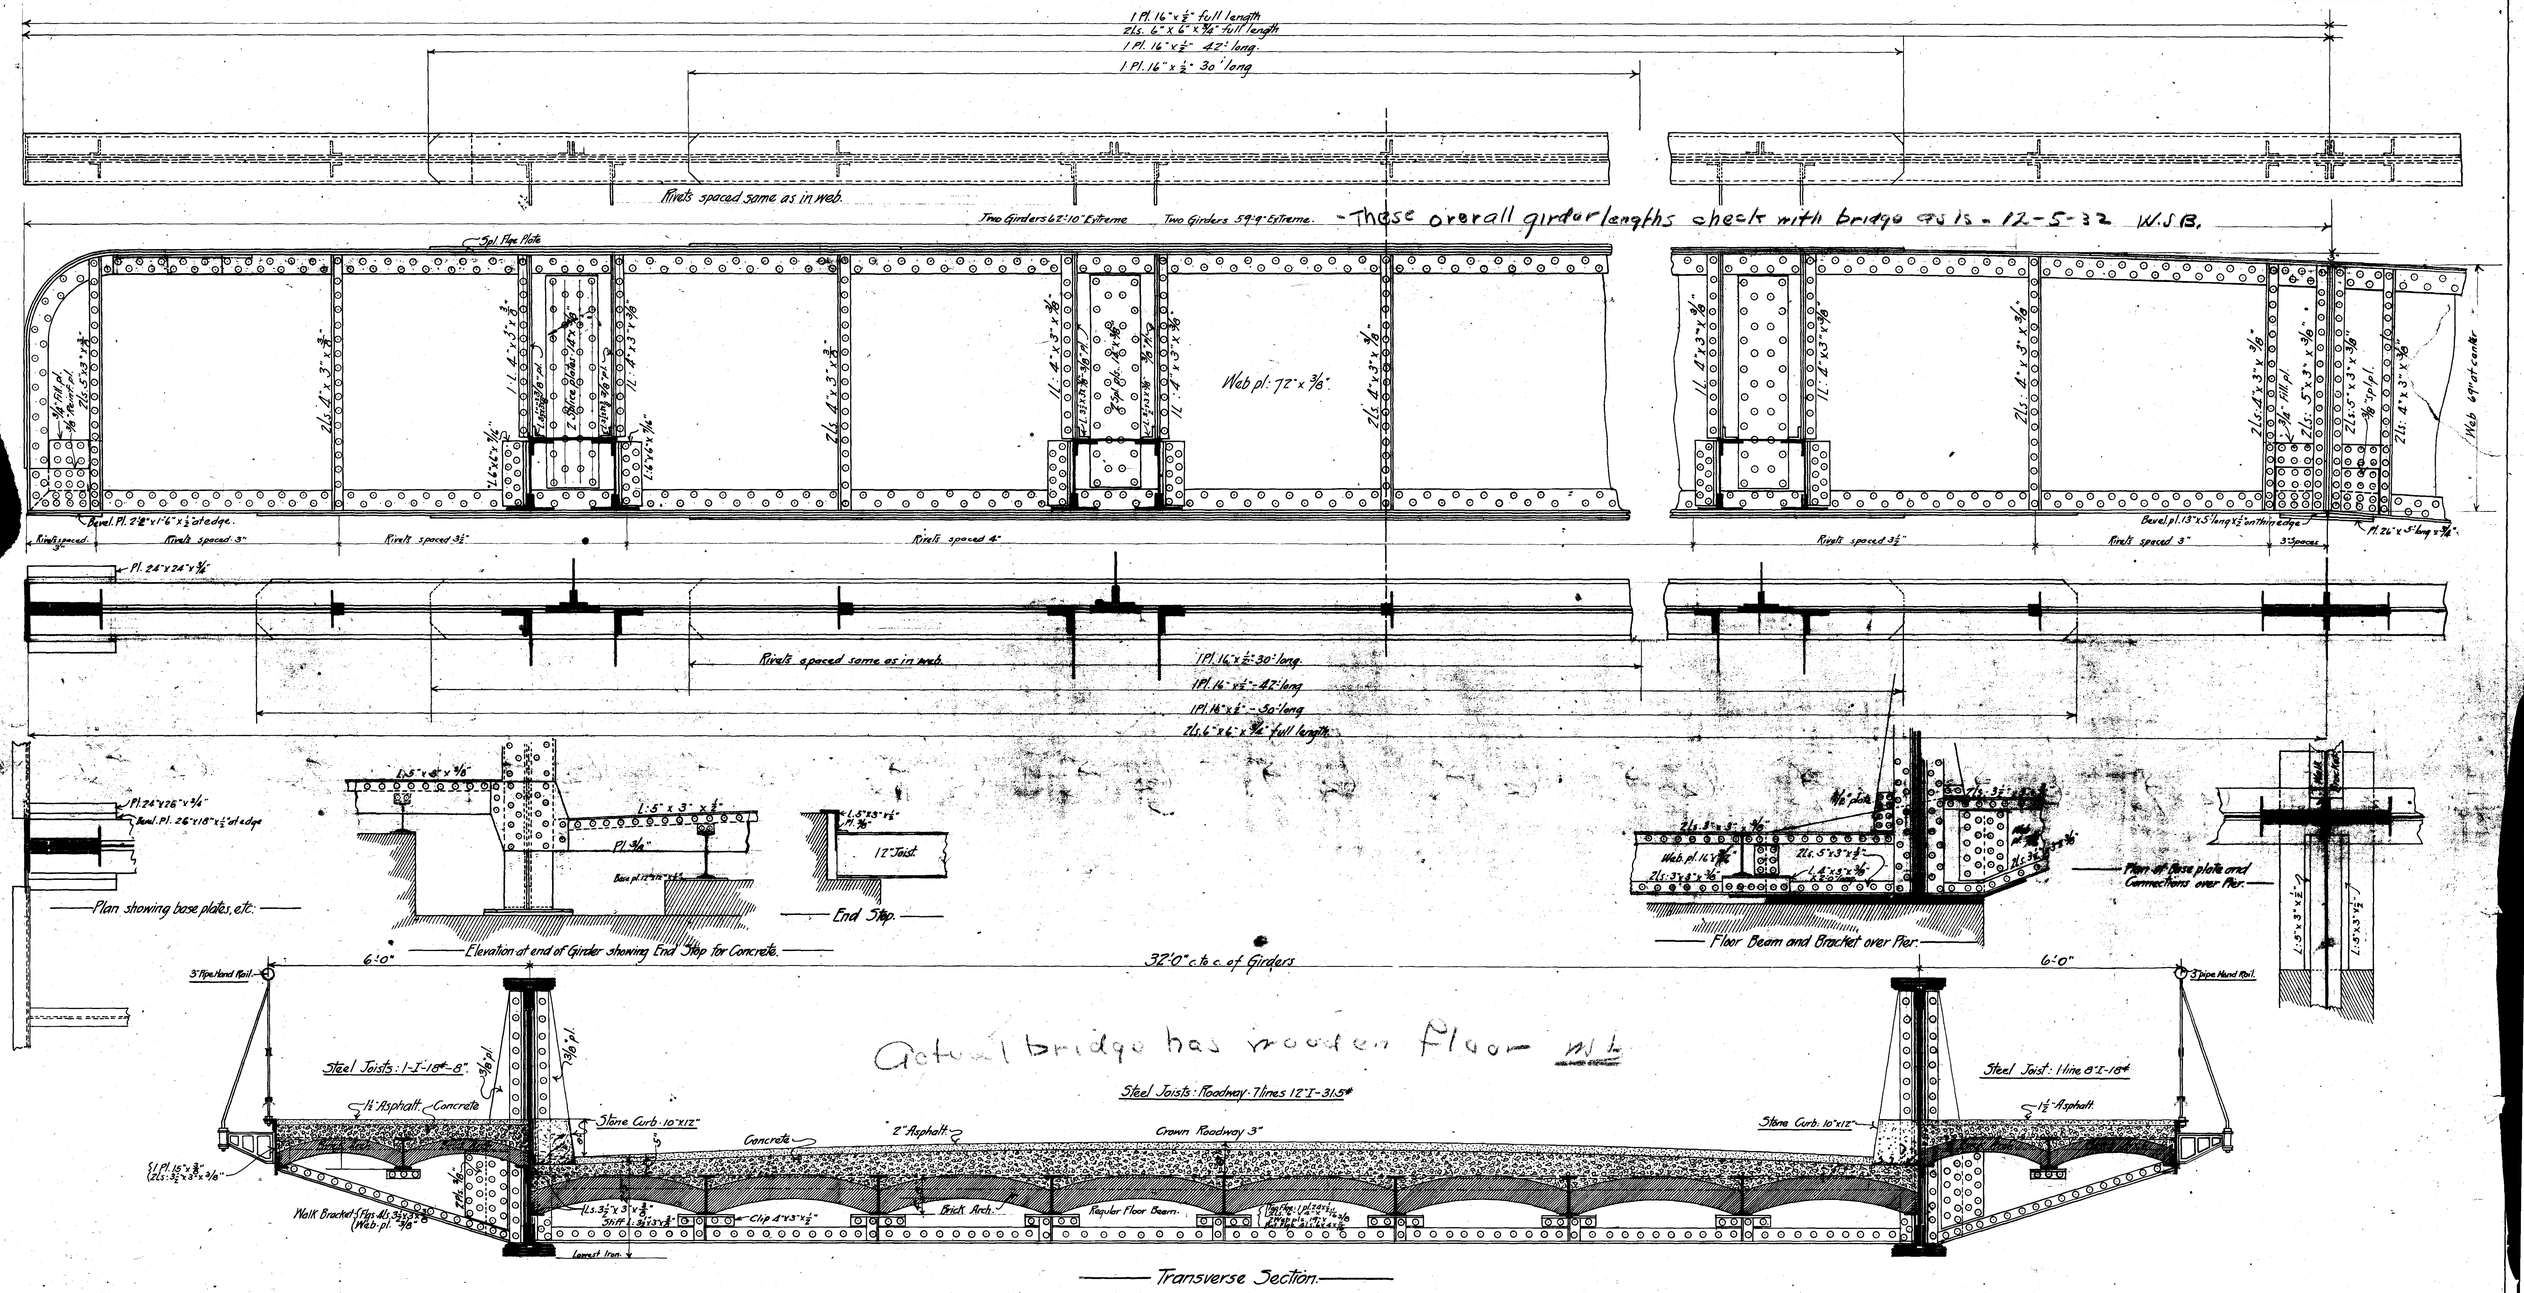

DESIGN OF PLATE GIRDER BRIDGE
OVER
N.Y. N.H. & H. AND N.E. R.R. TRACKS,
AT
BROAD STREET, HARTFORD, CONN.

THE BERLIN IRON BRIDGE CO. ENGINEERS,
EAST BERLIN, CONN

SCALE 3/16" = 1'

F 28125/8