


Plan of New Hamilton St. Bridge
Span 75' Width 50'

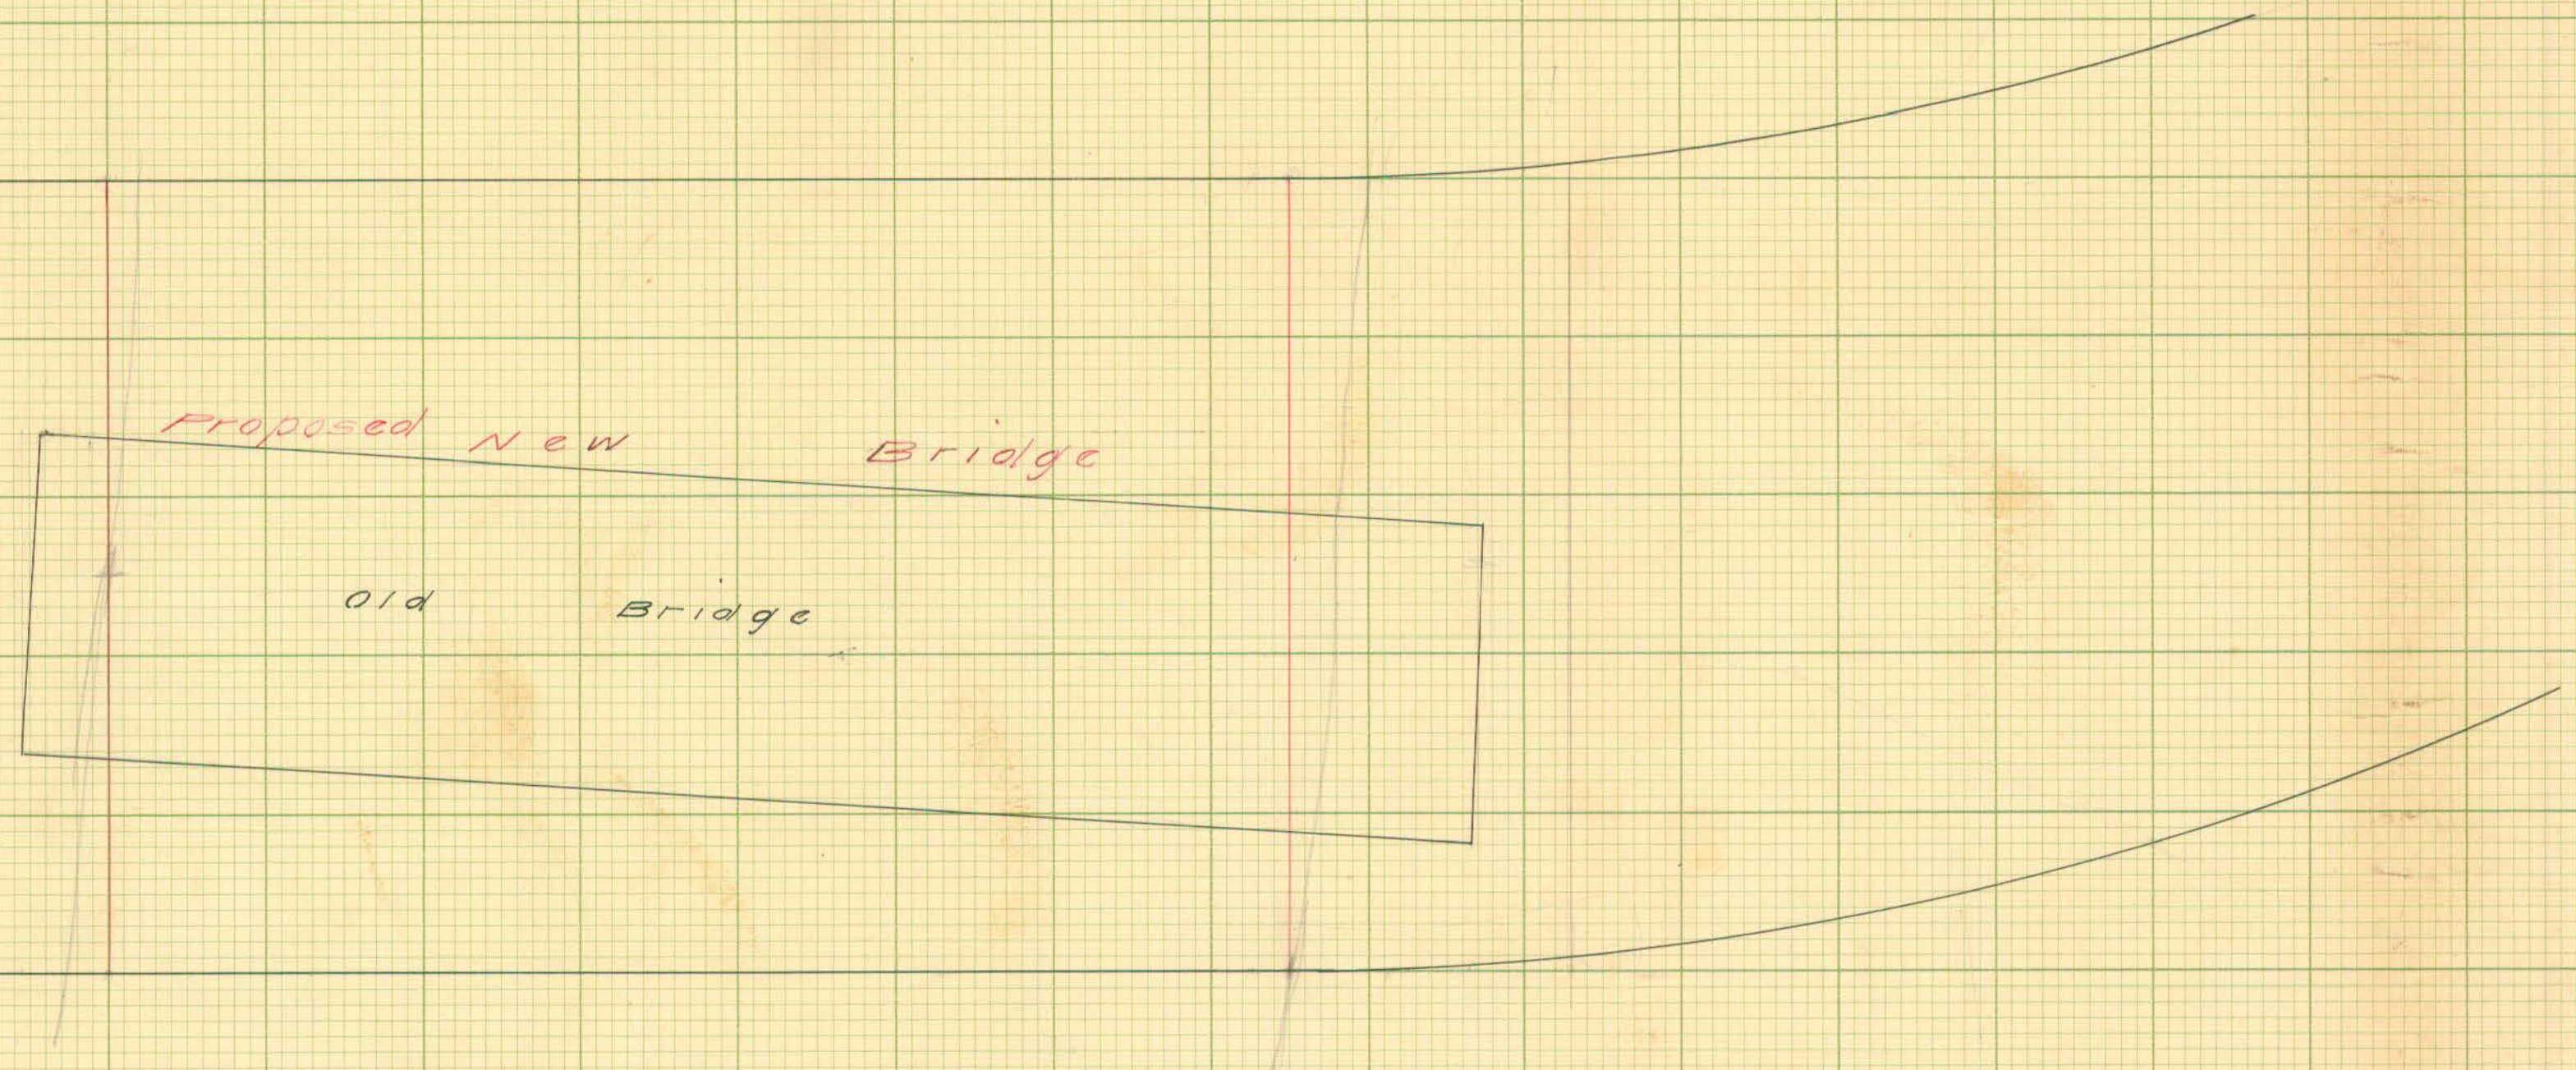

Profile



CITY SURVEYOR'S OFFICE
HARTFORD, CONN.
STREET & MISCELLANEOUS DEPT.
Date _____ Notes _____ Day Book No. _____
City Surveyor _____