

Out of Service Dec 10 1934

G E O R G E

Street, Building, and Veranda Lines of July 19, 1915

Vol. 6-138

Street and Building Lines of May 10, 1897. Vol. 4-251.








S T R E E T

("Clarkins Ball Grounds")

James H. Clarkin

189739
The Hartford Base Ball Club, Inc.

Out of Service Dec 10-1934

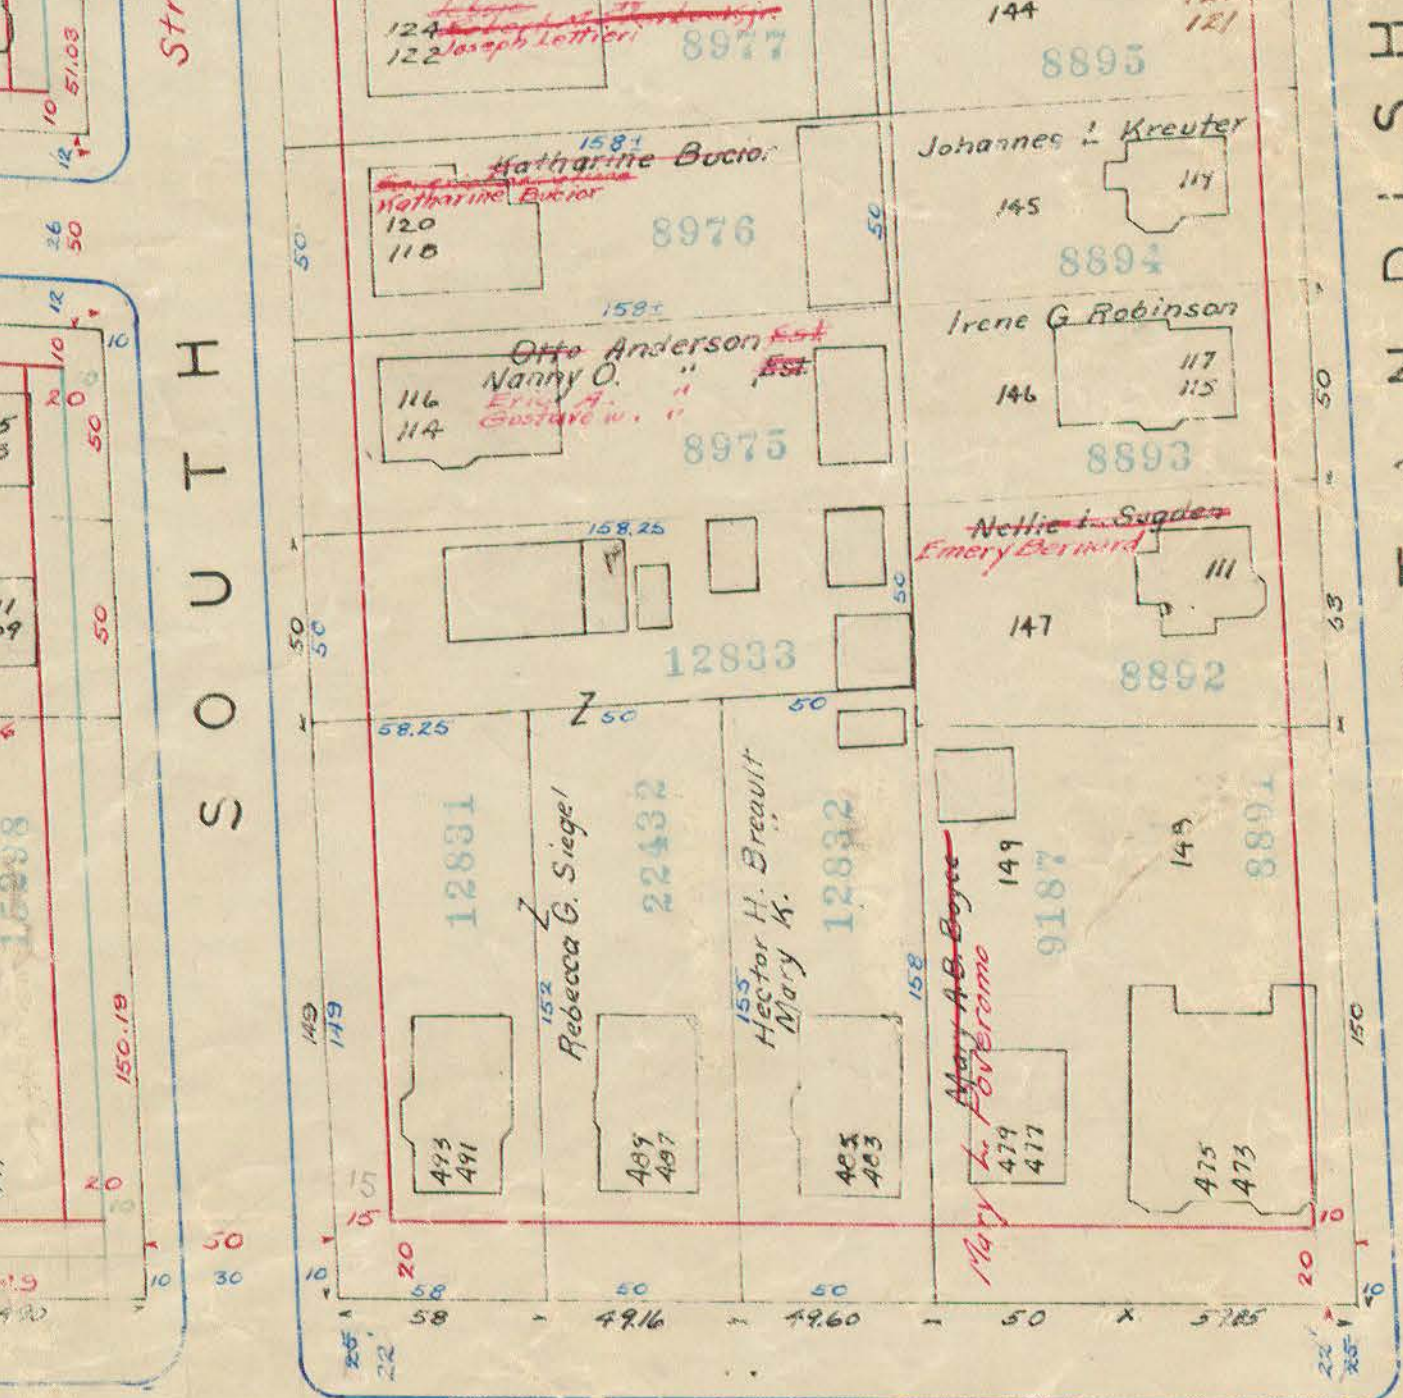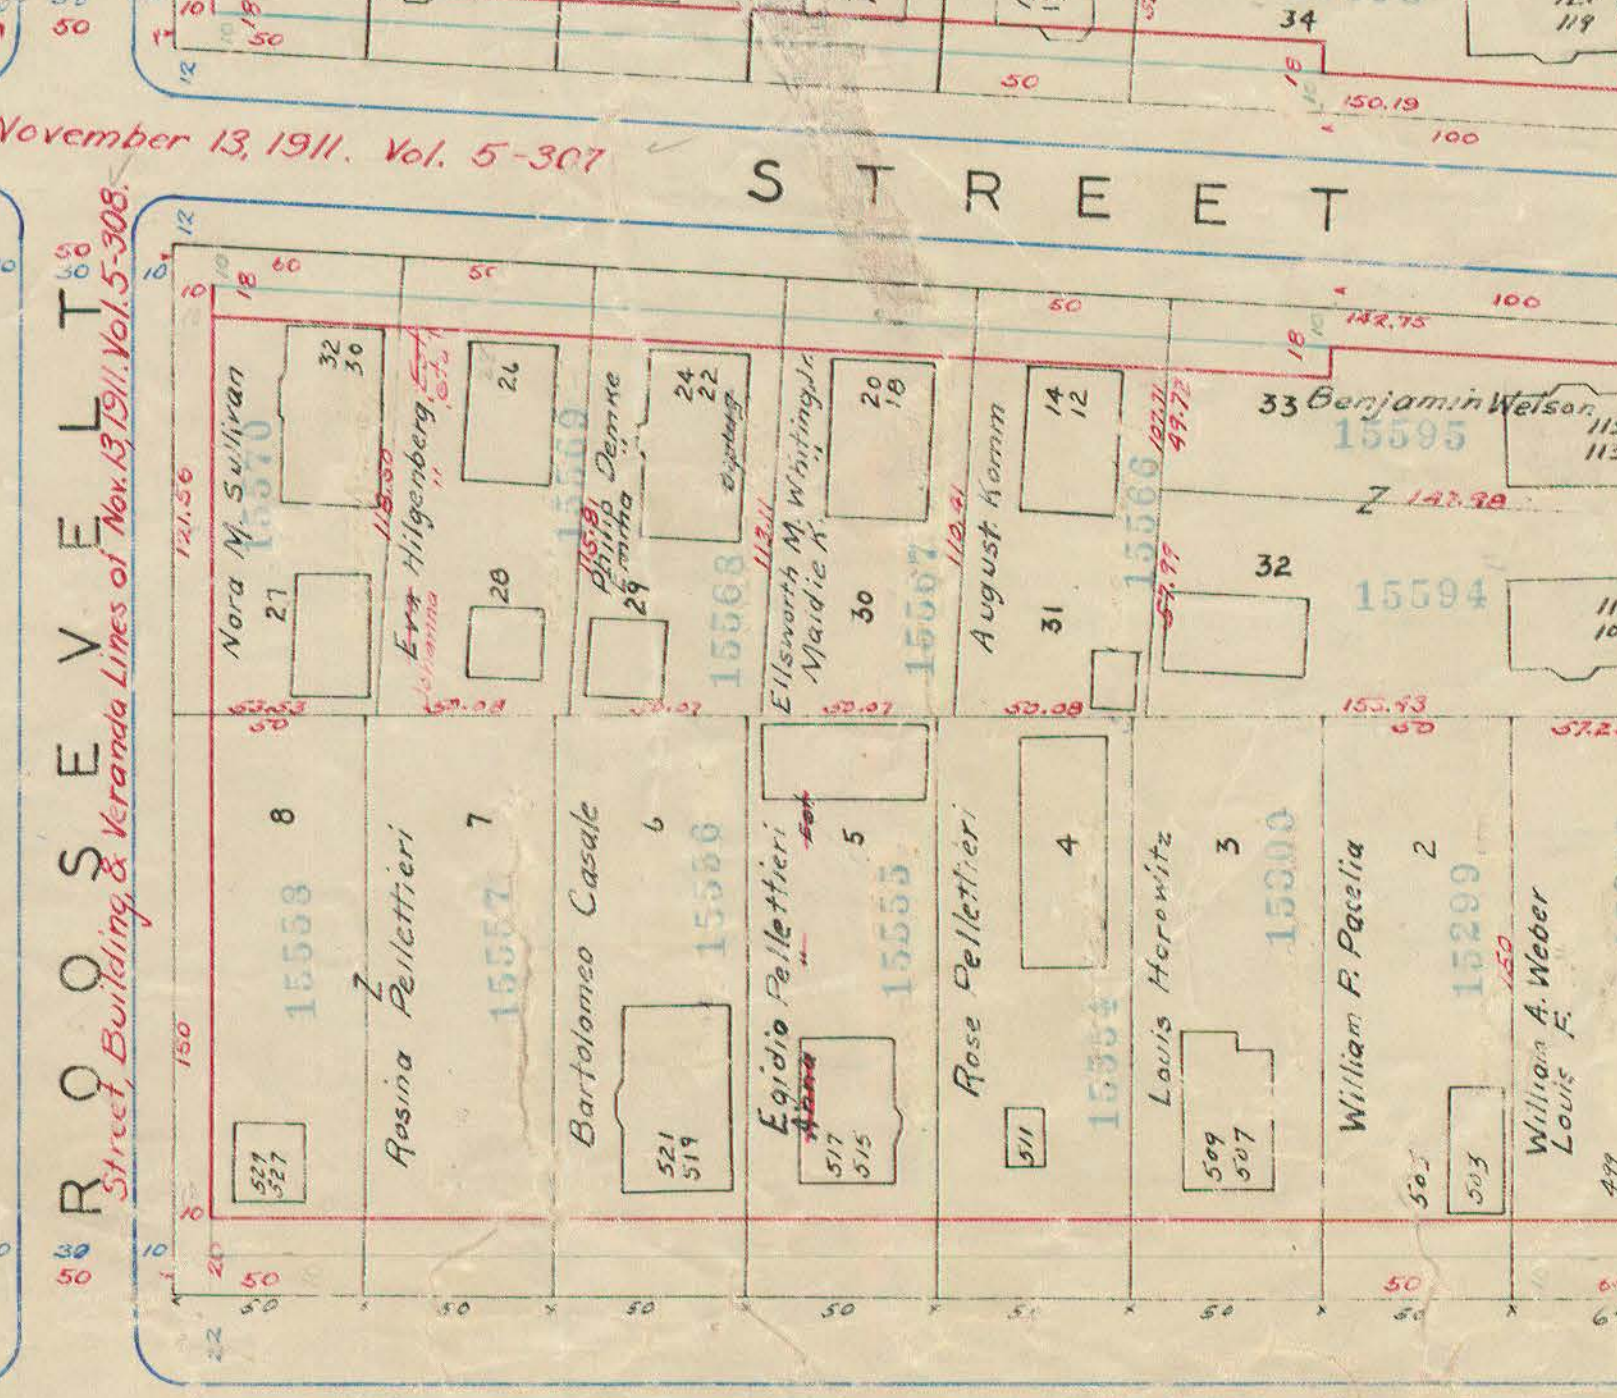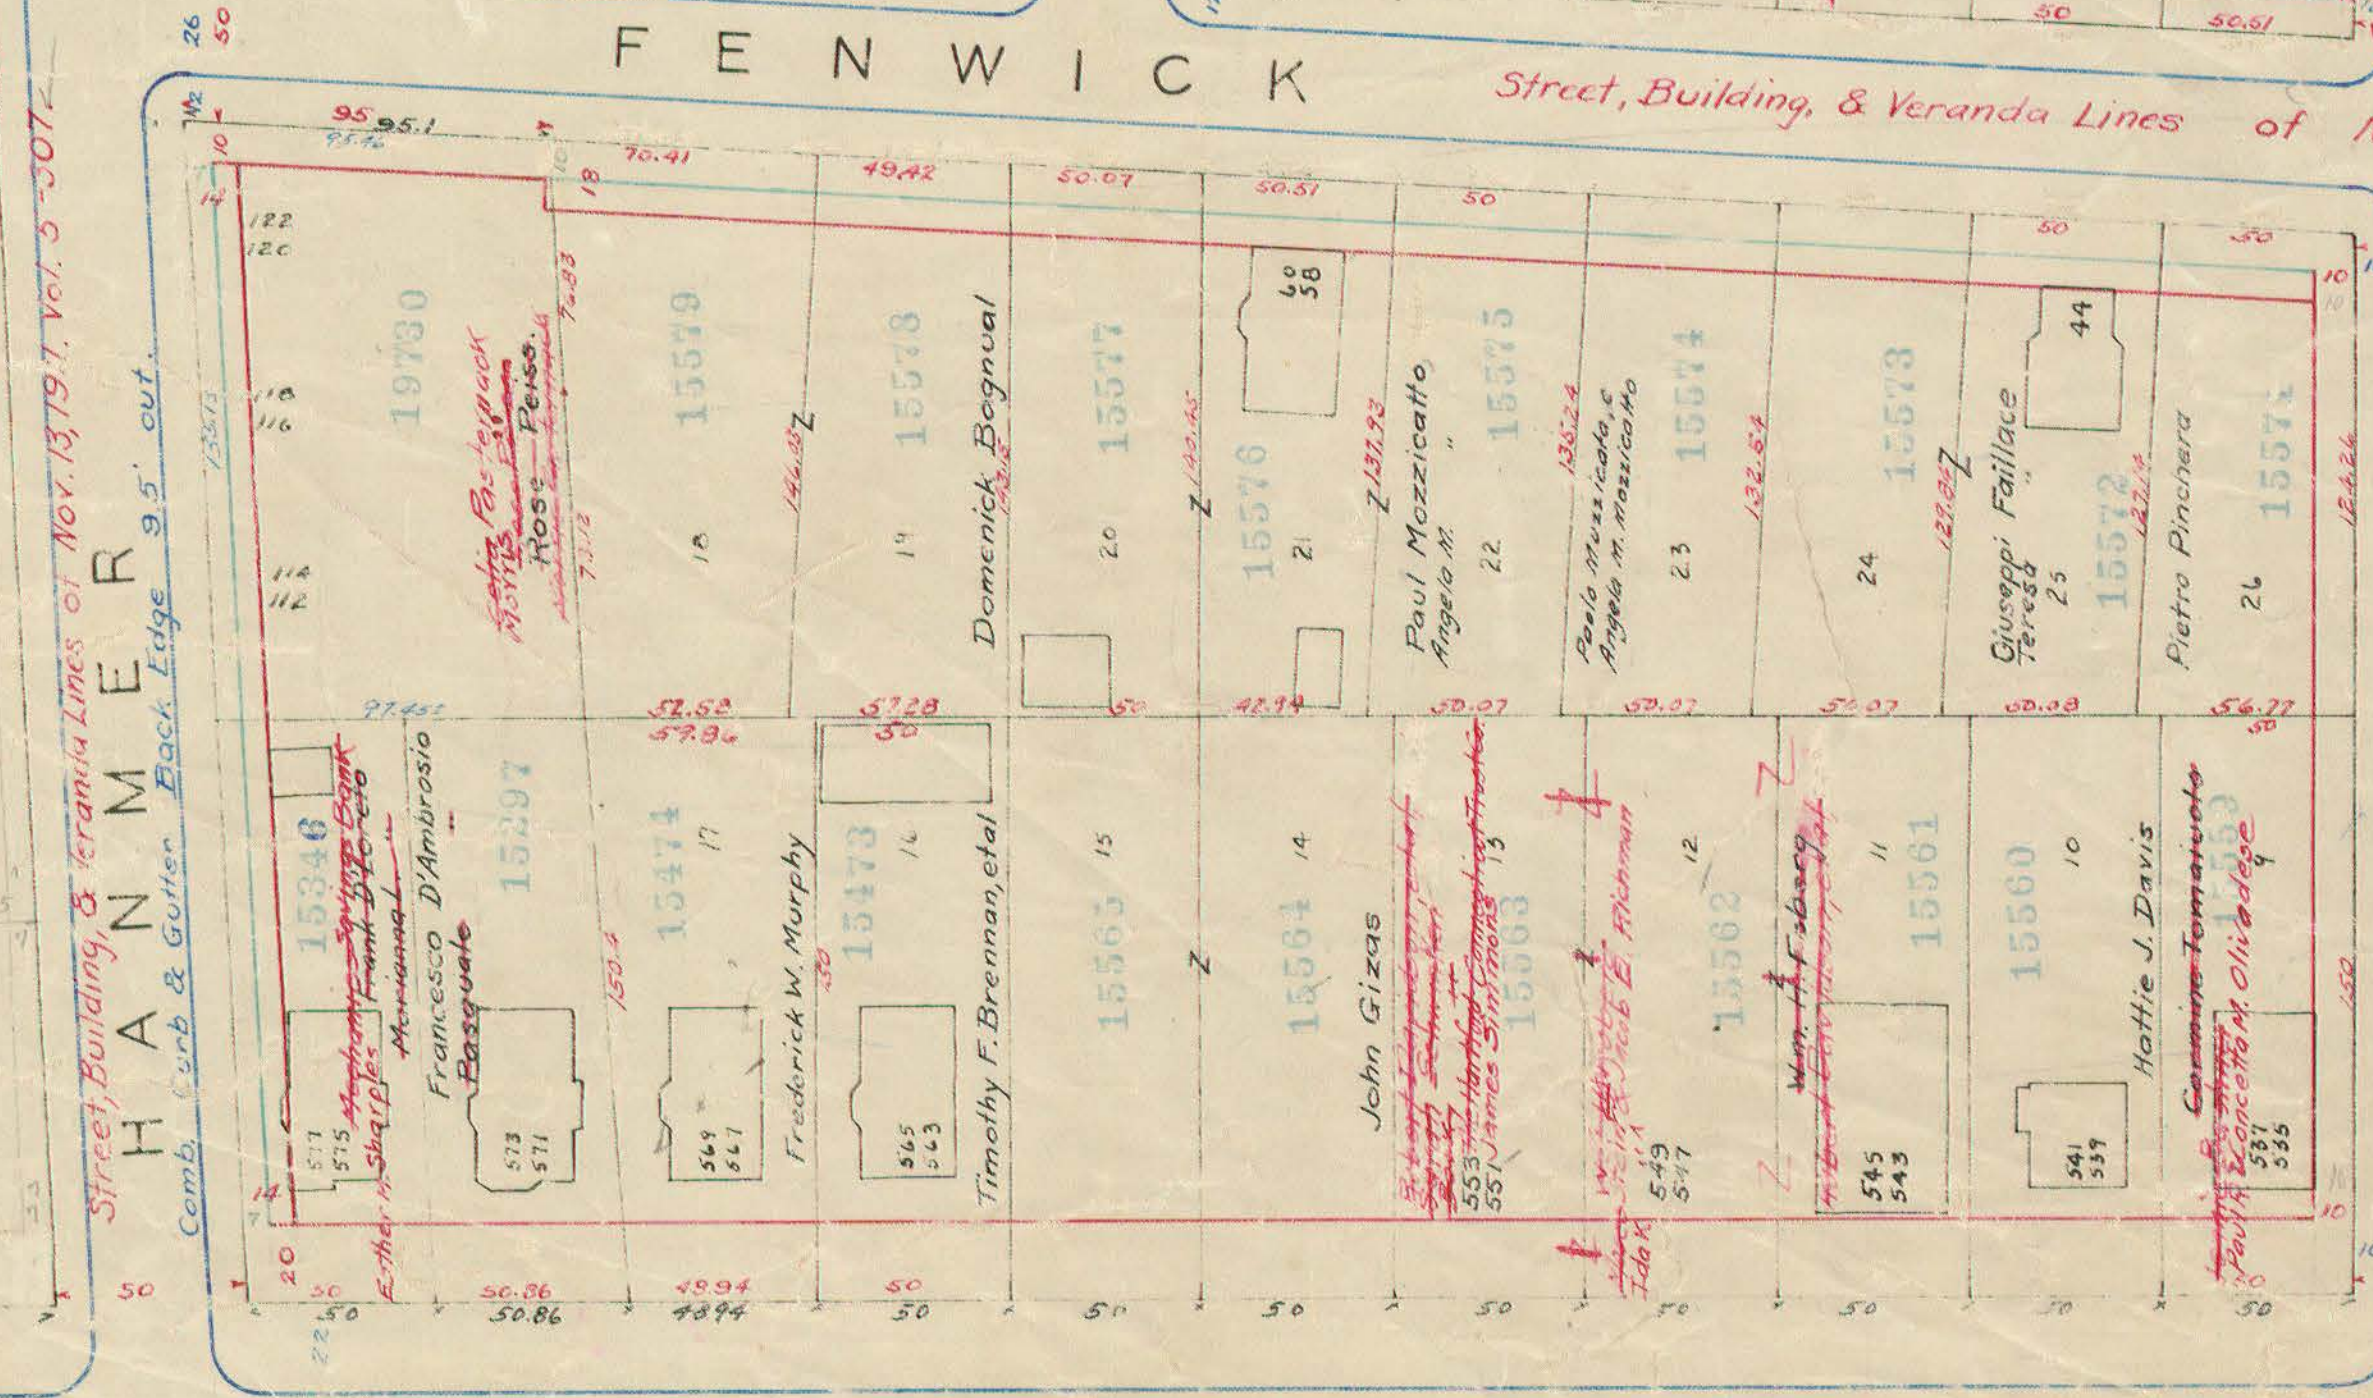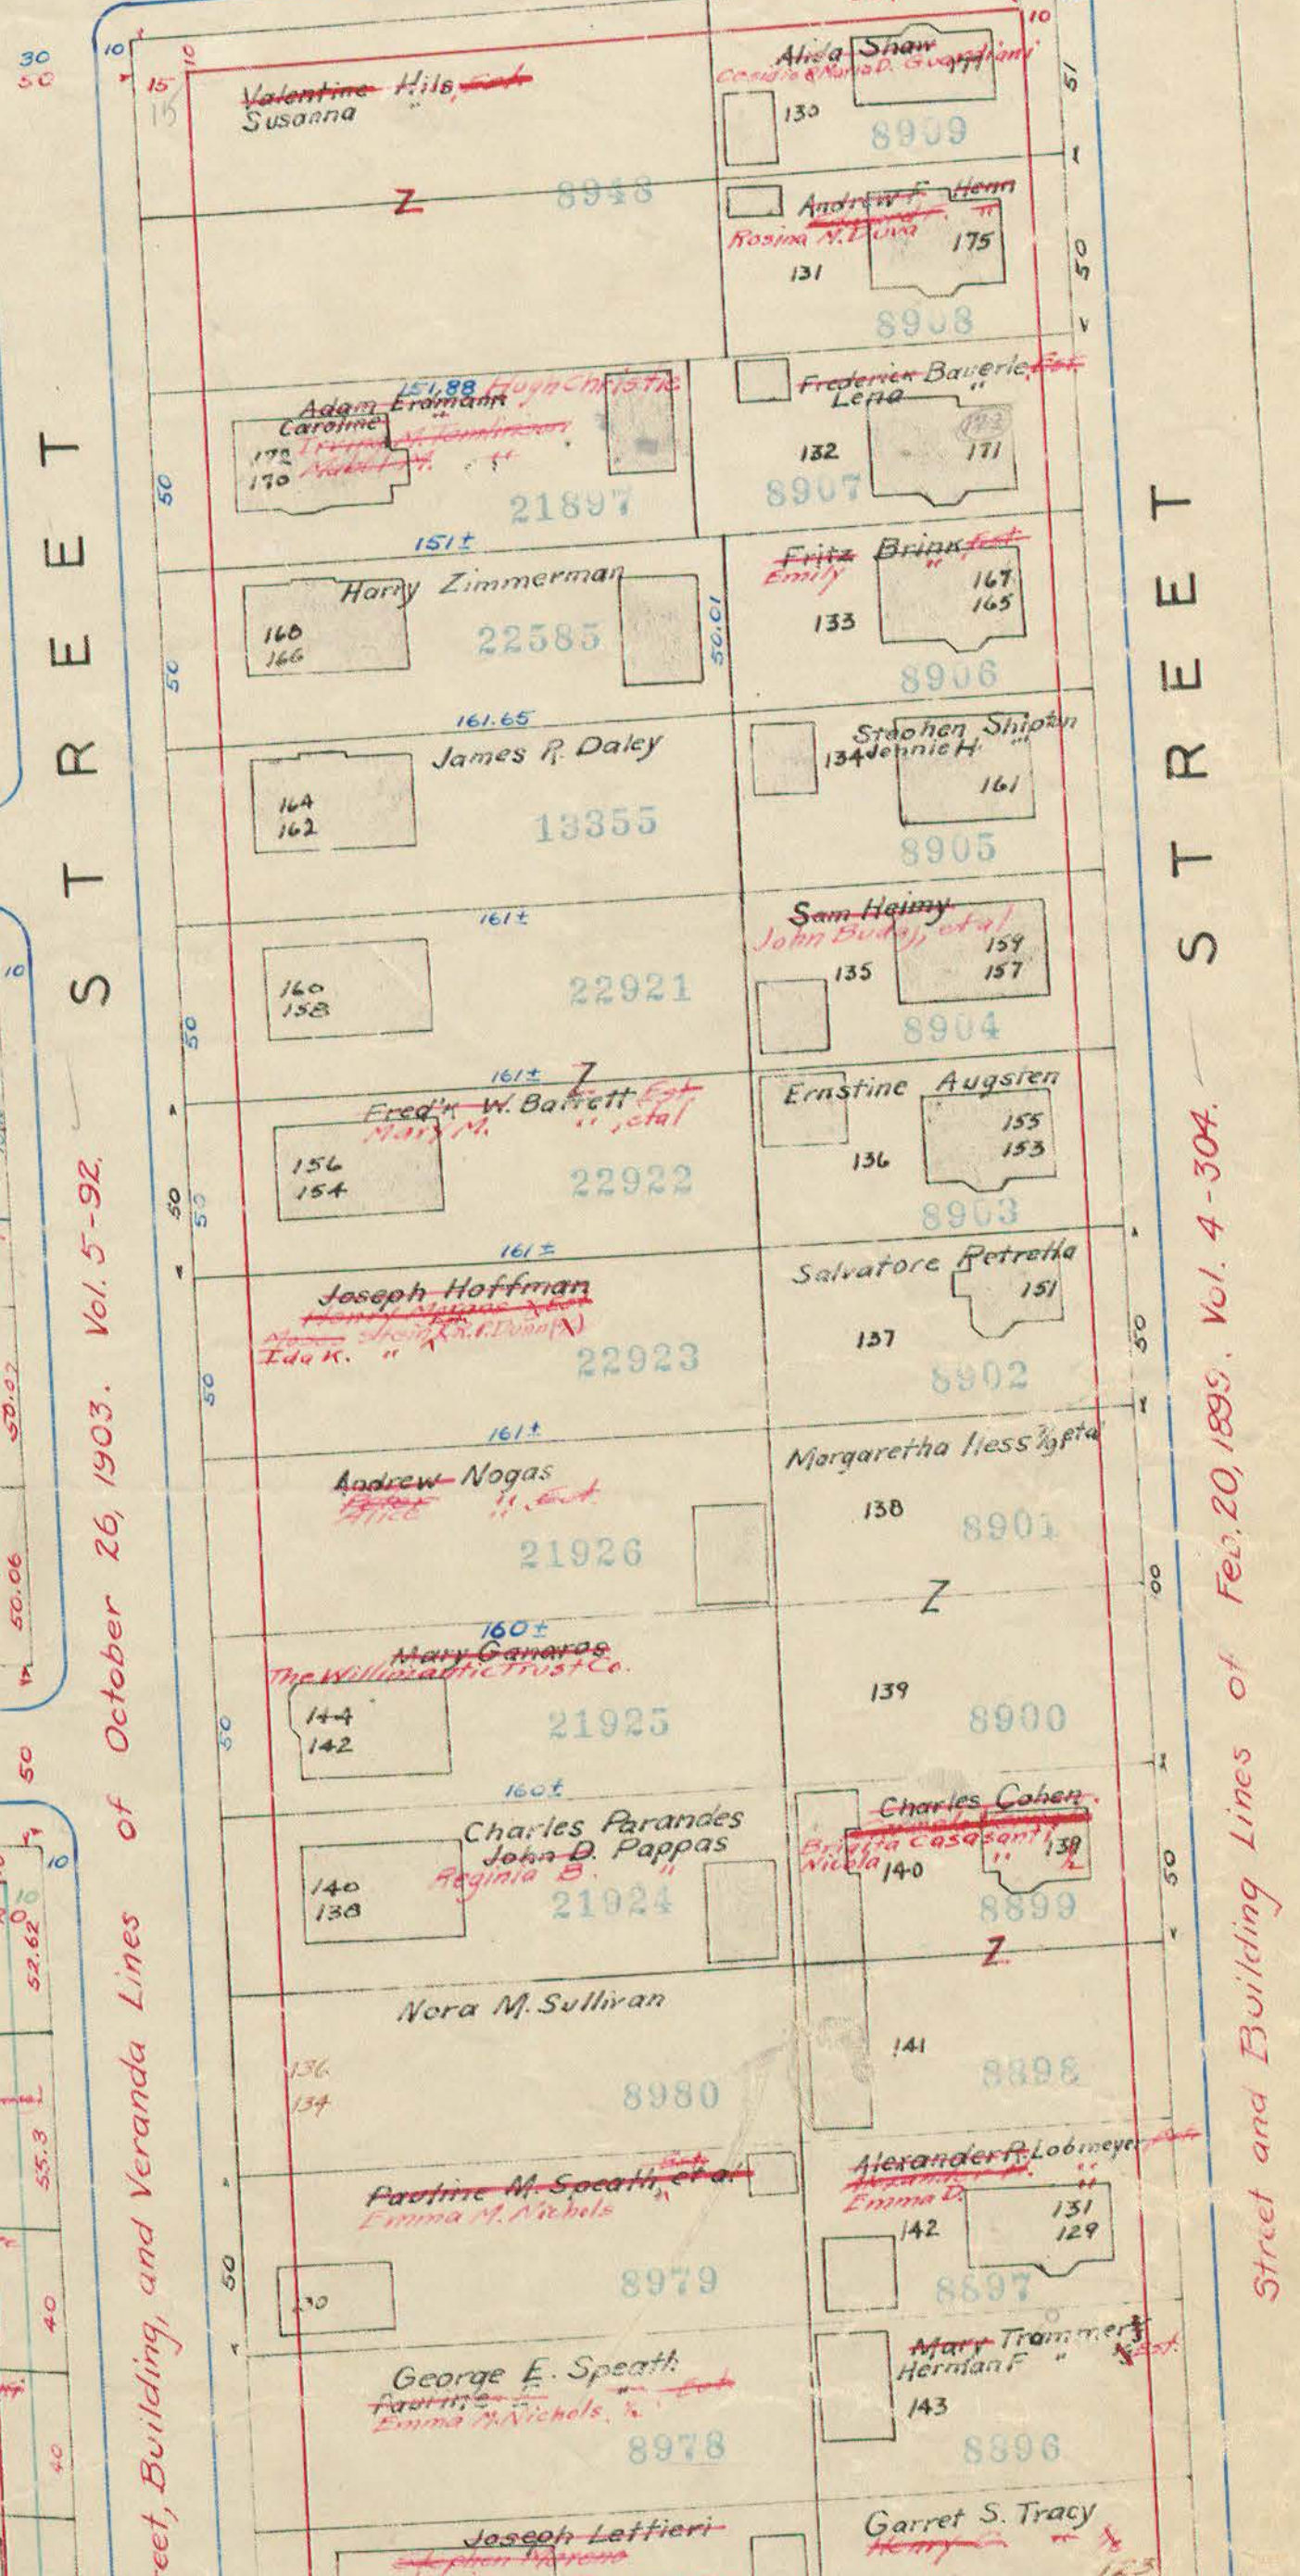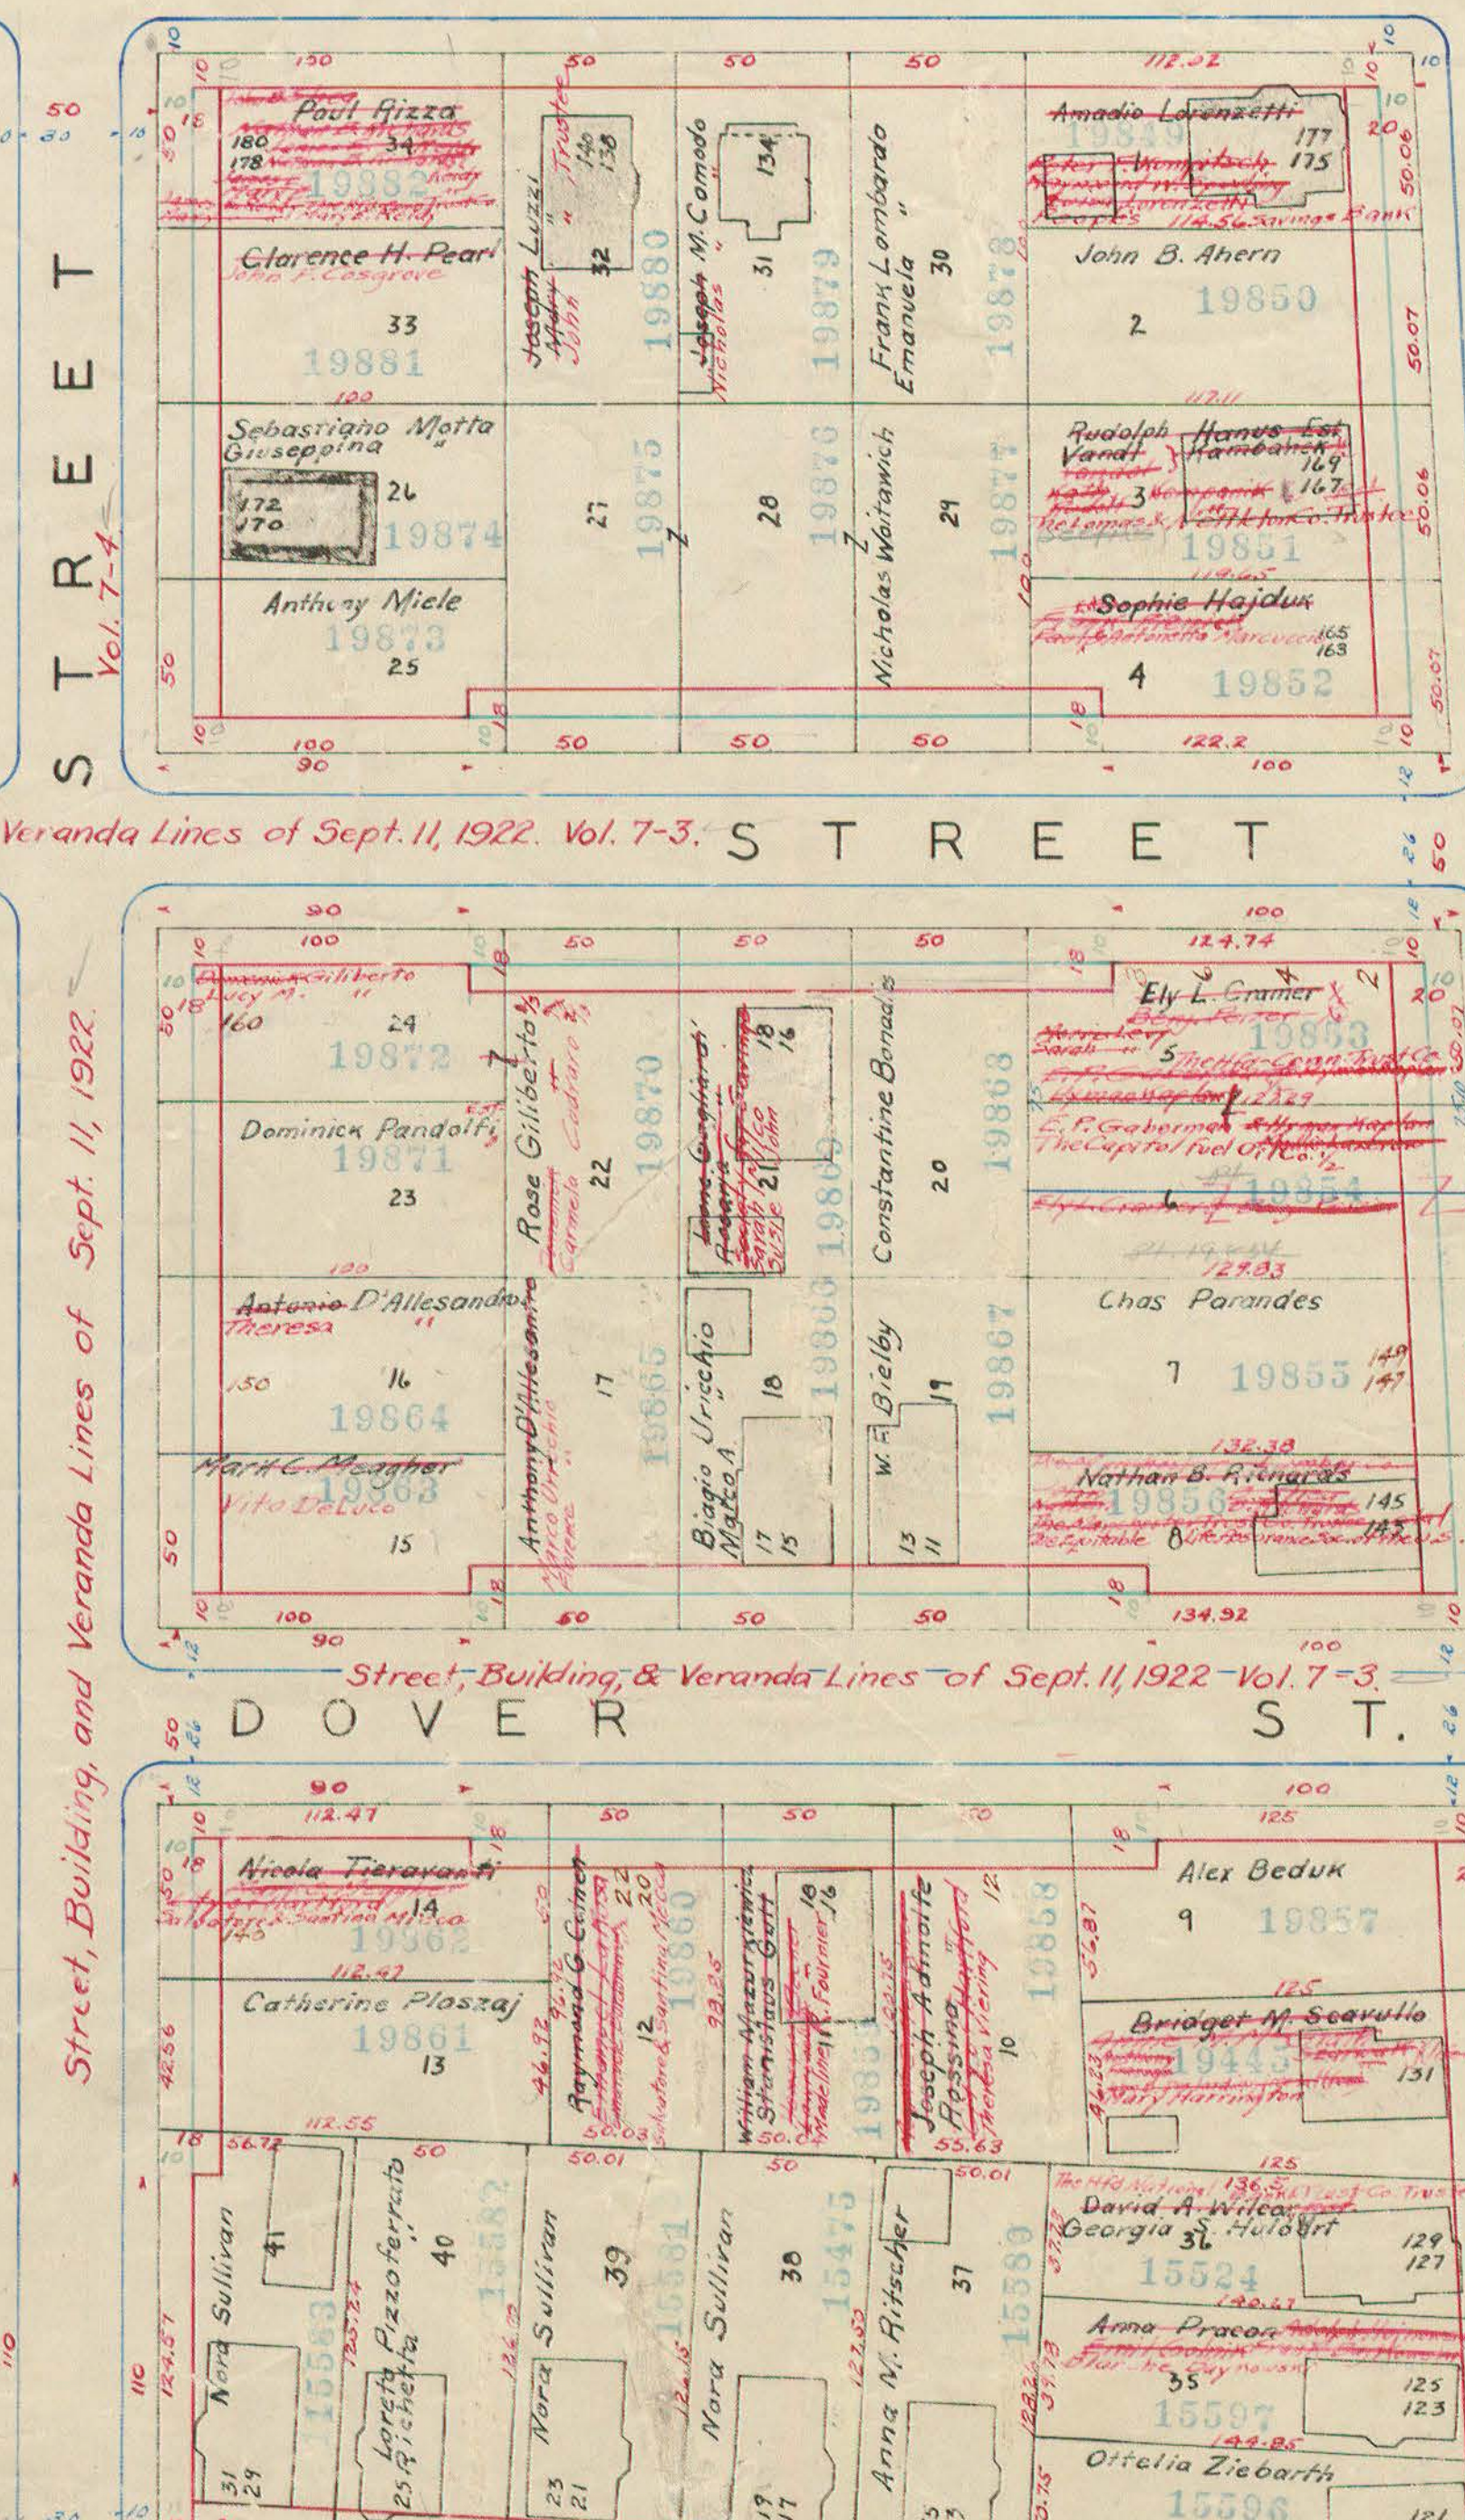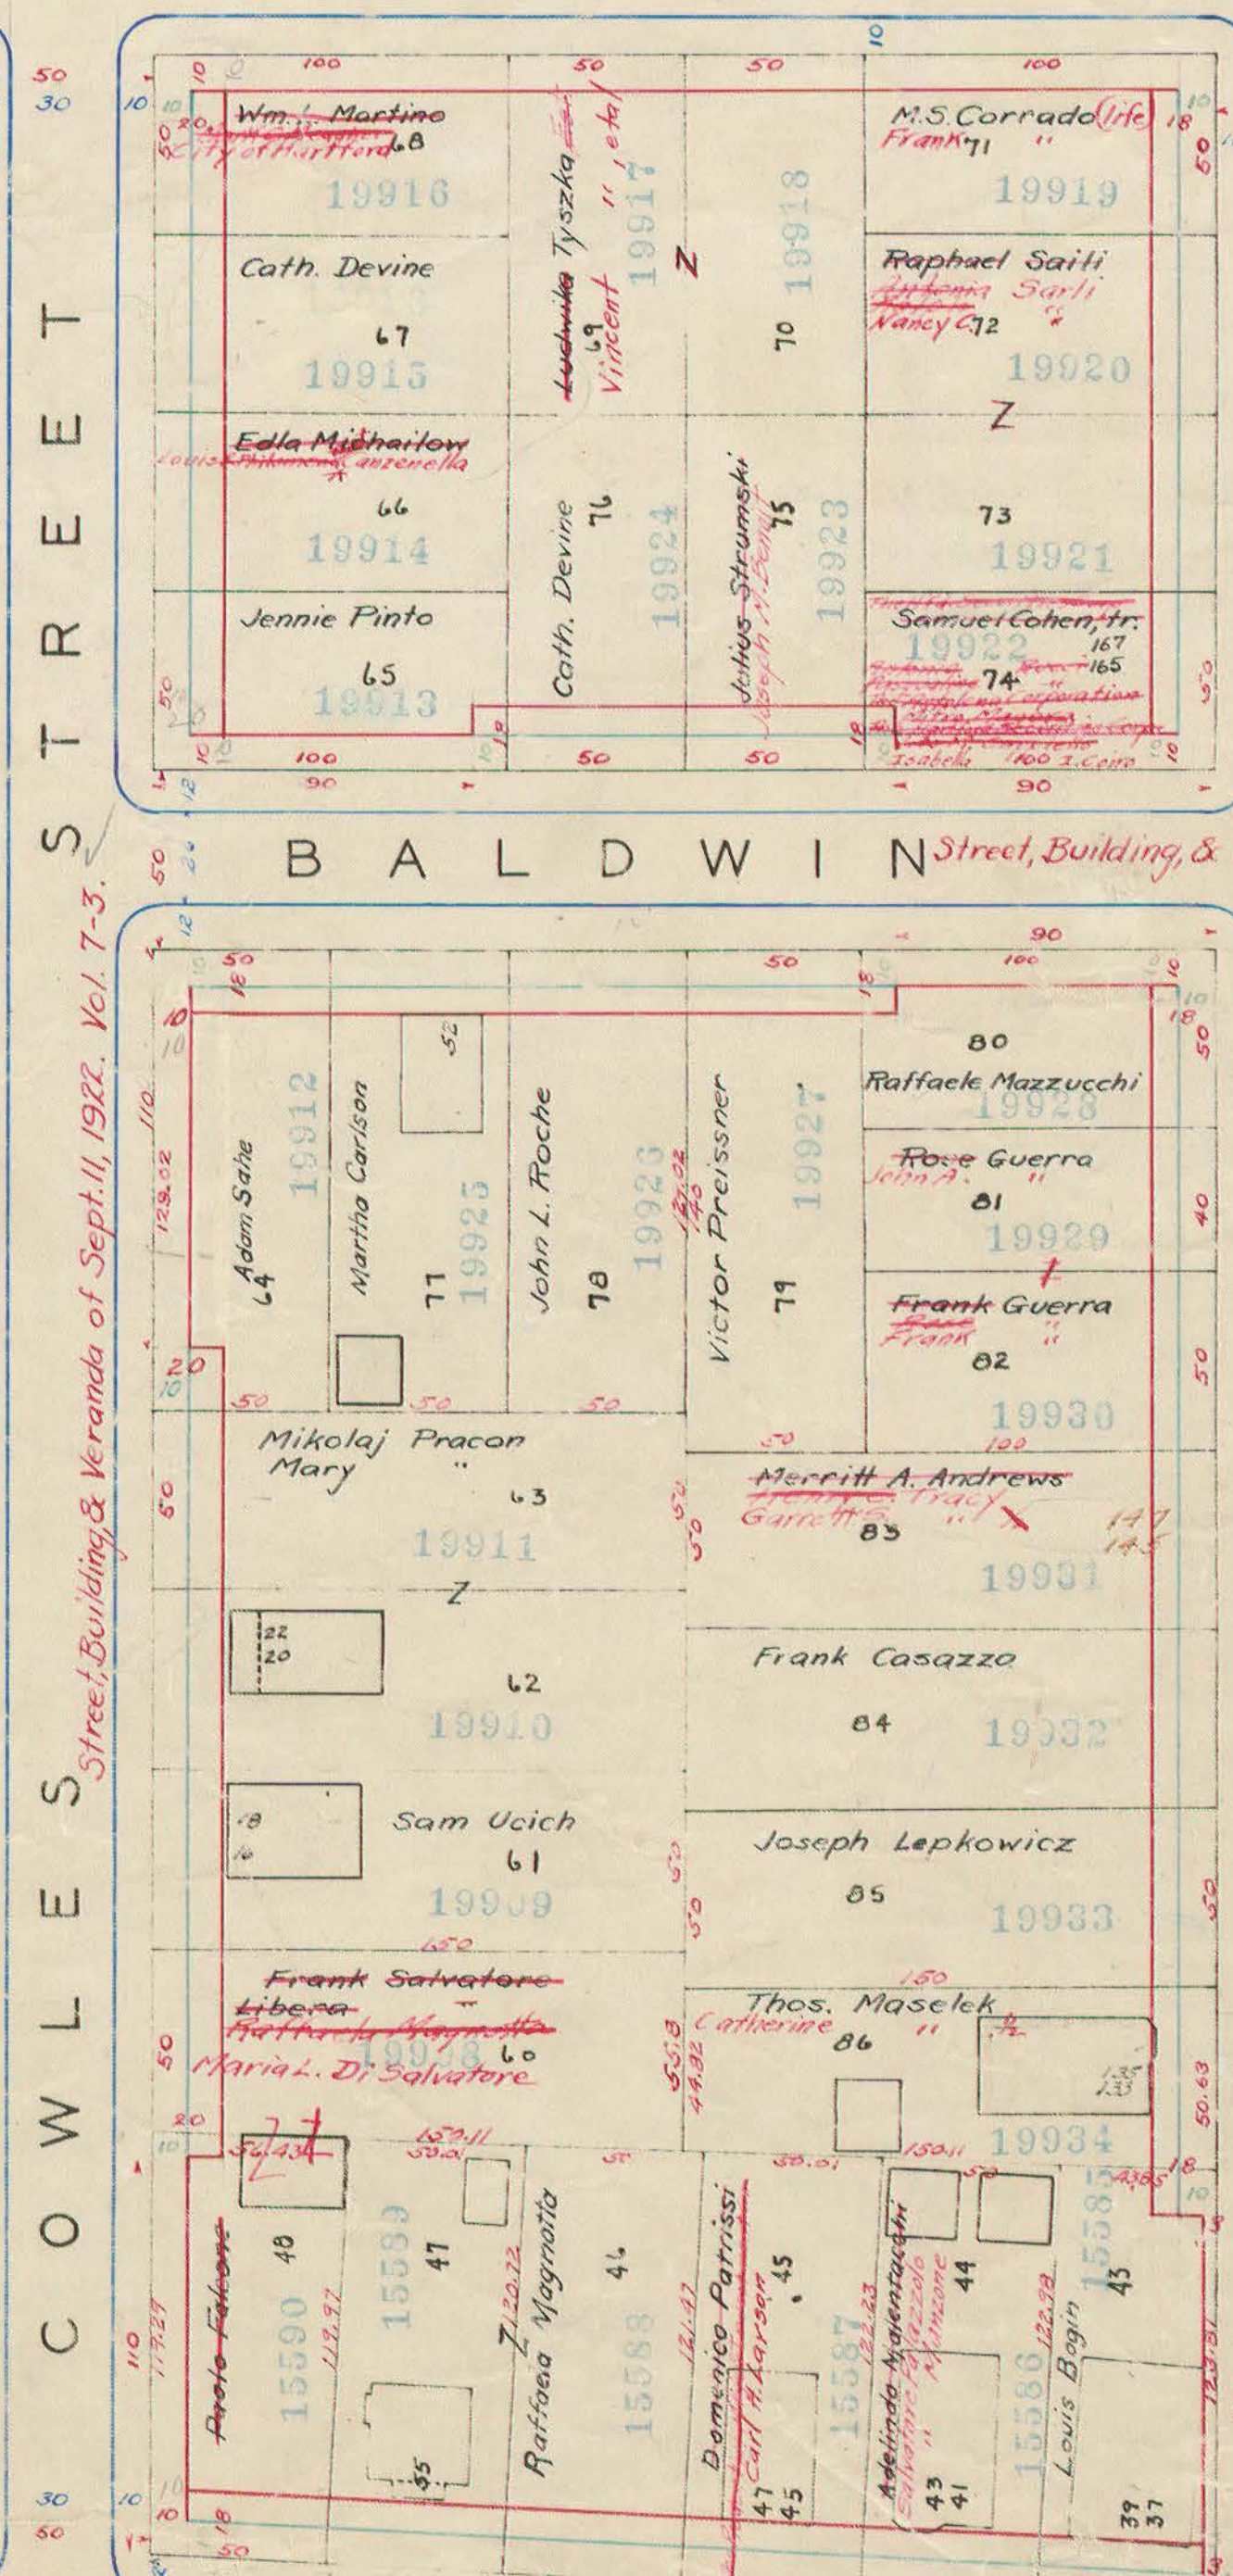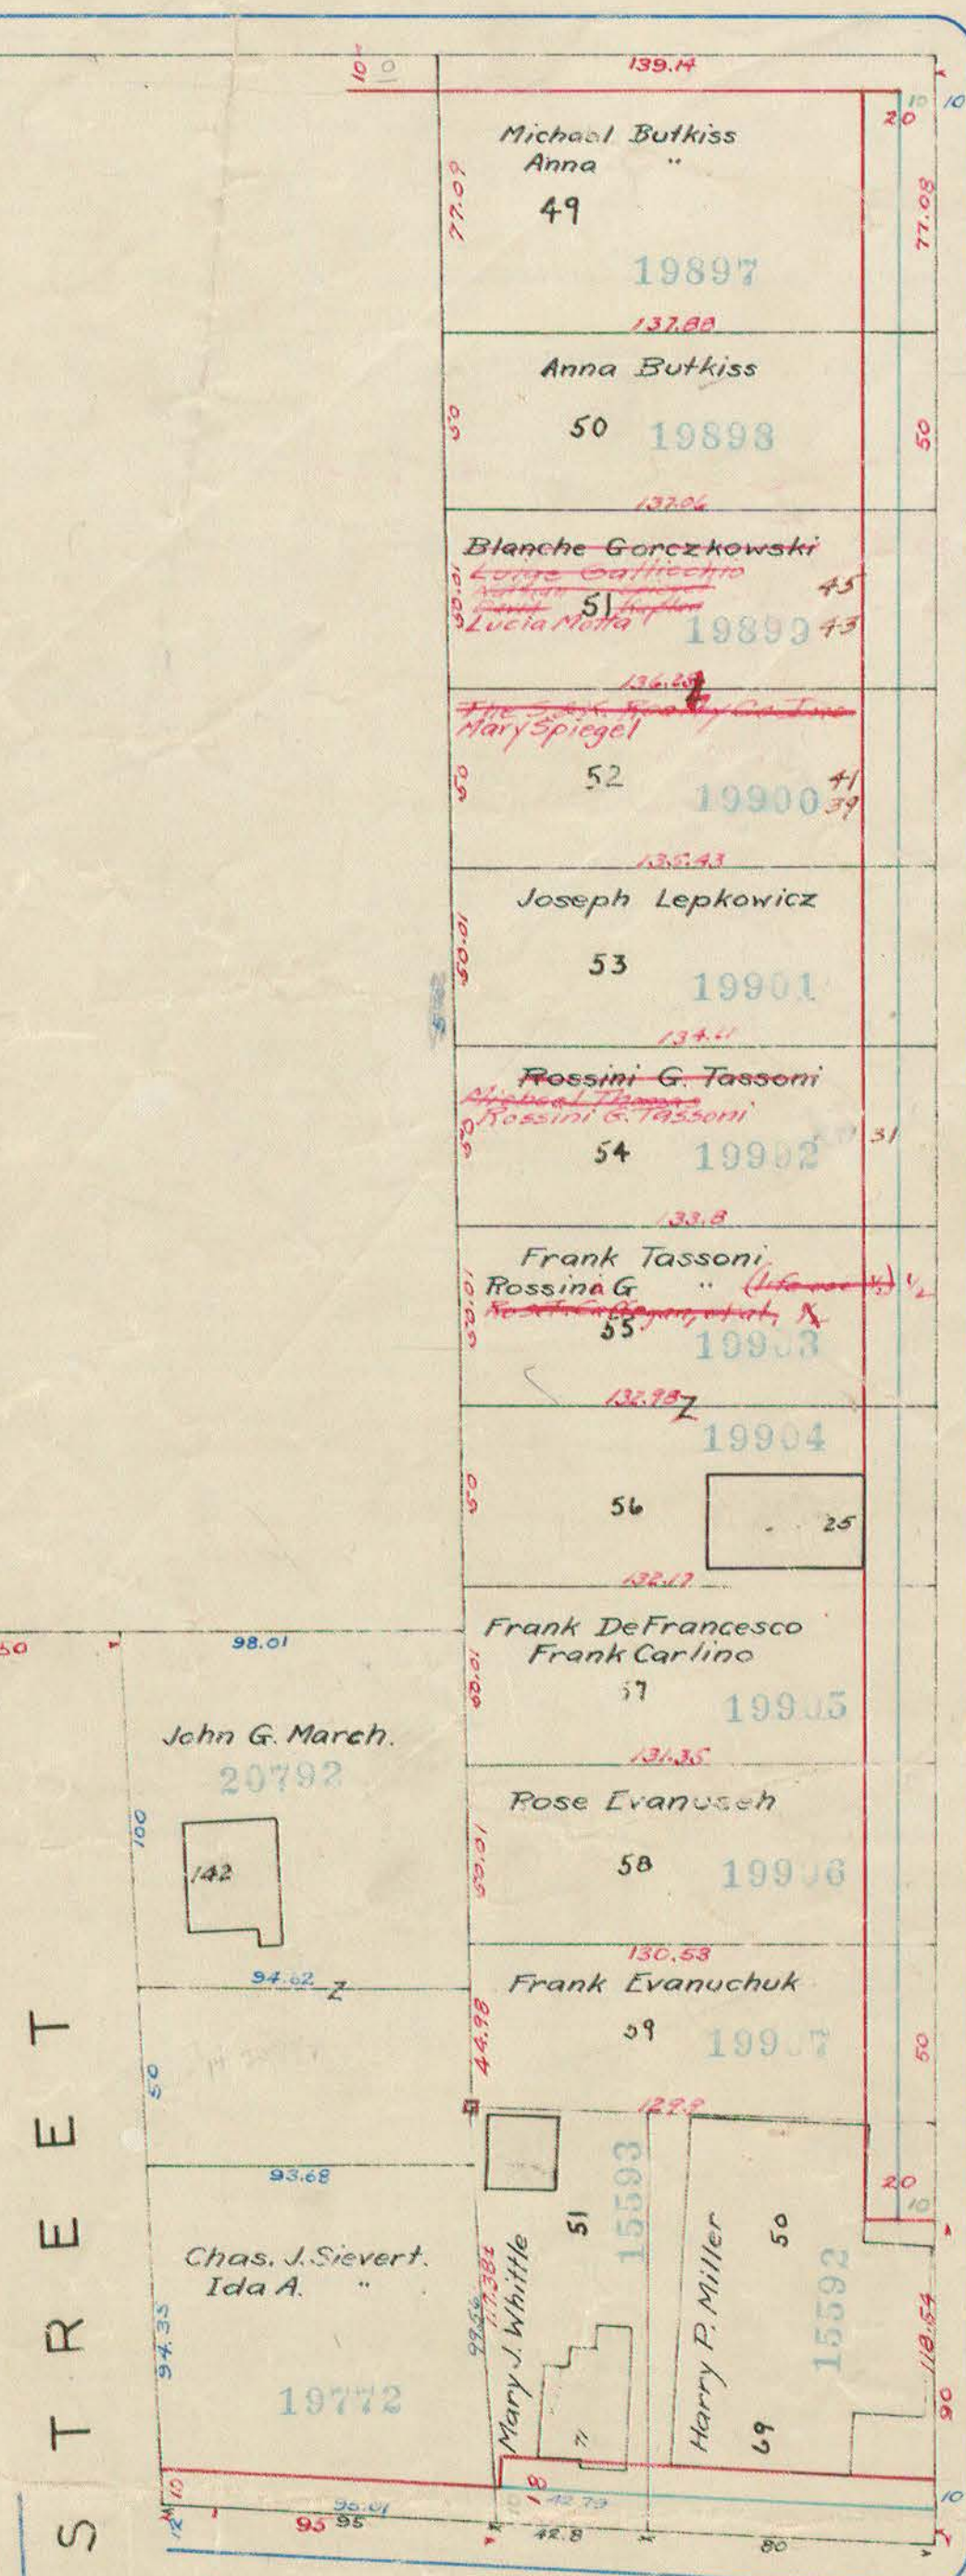

F R A N K L I N

Street and Building Lines of December 12, 1911. Vol. 3-26

A V E N U E