
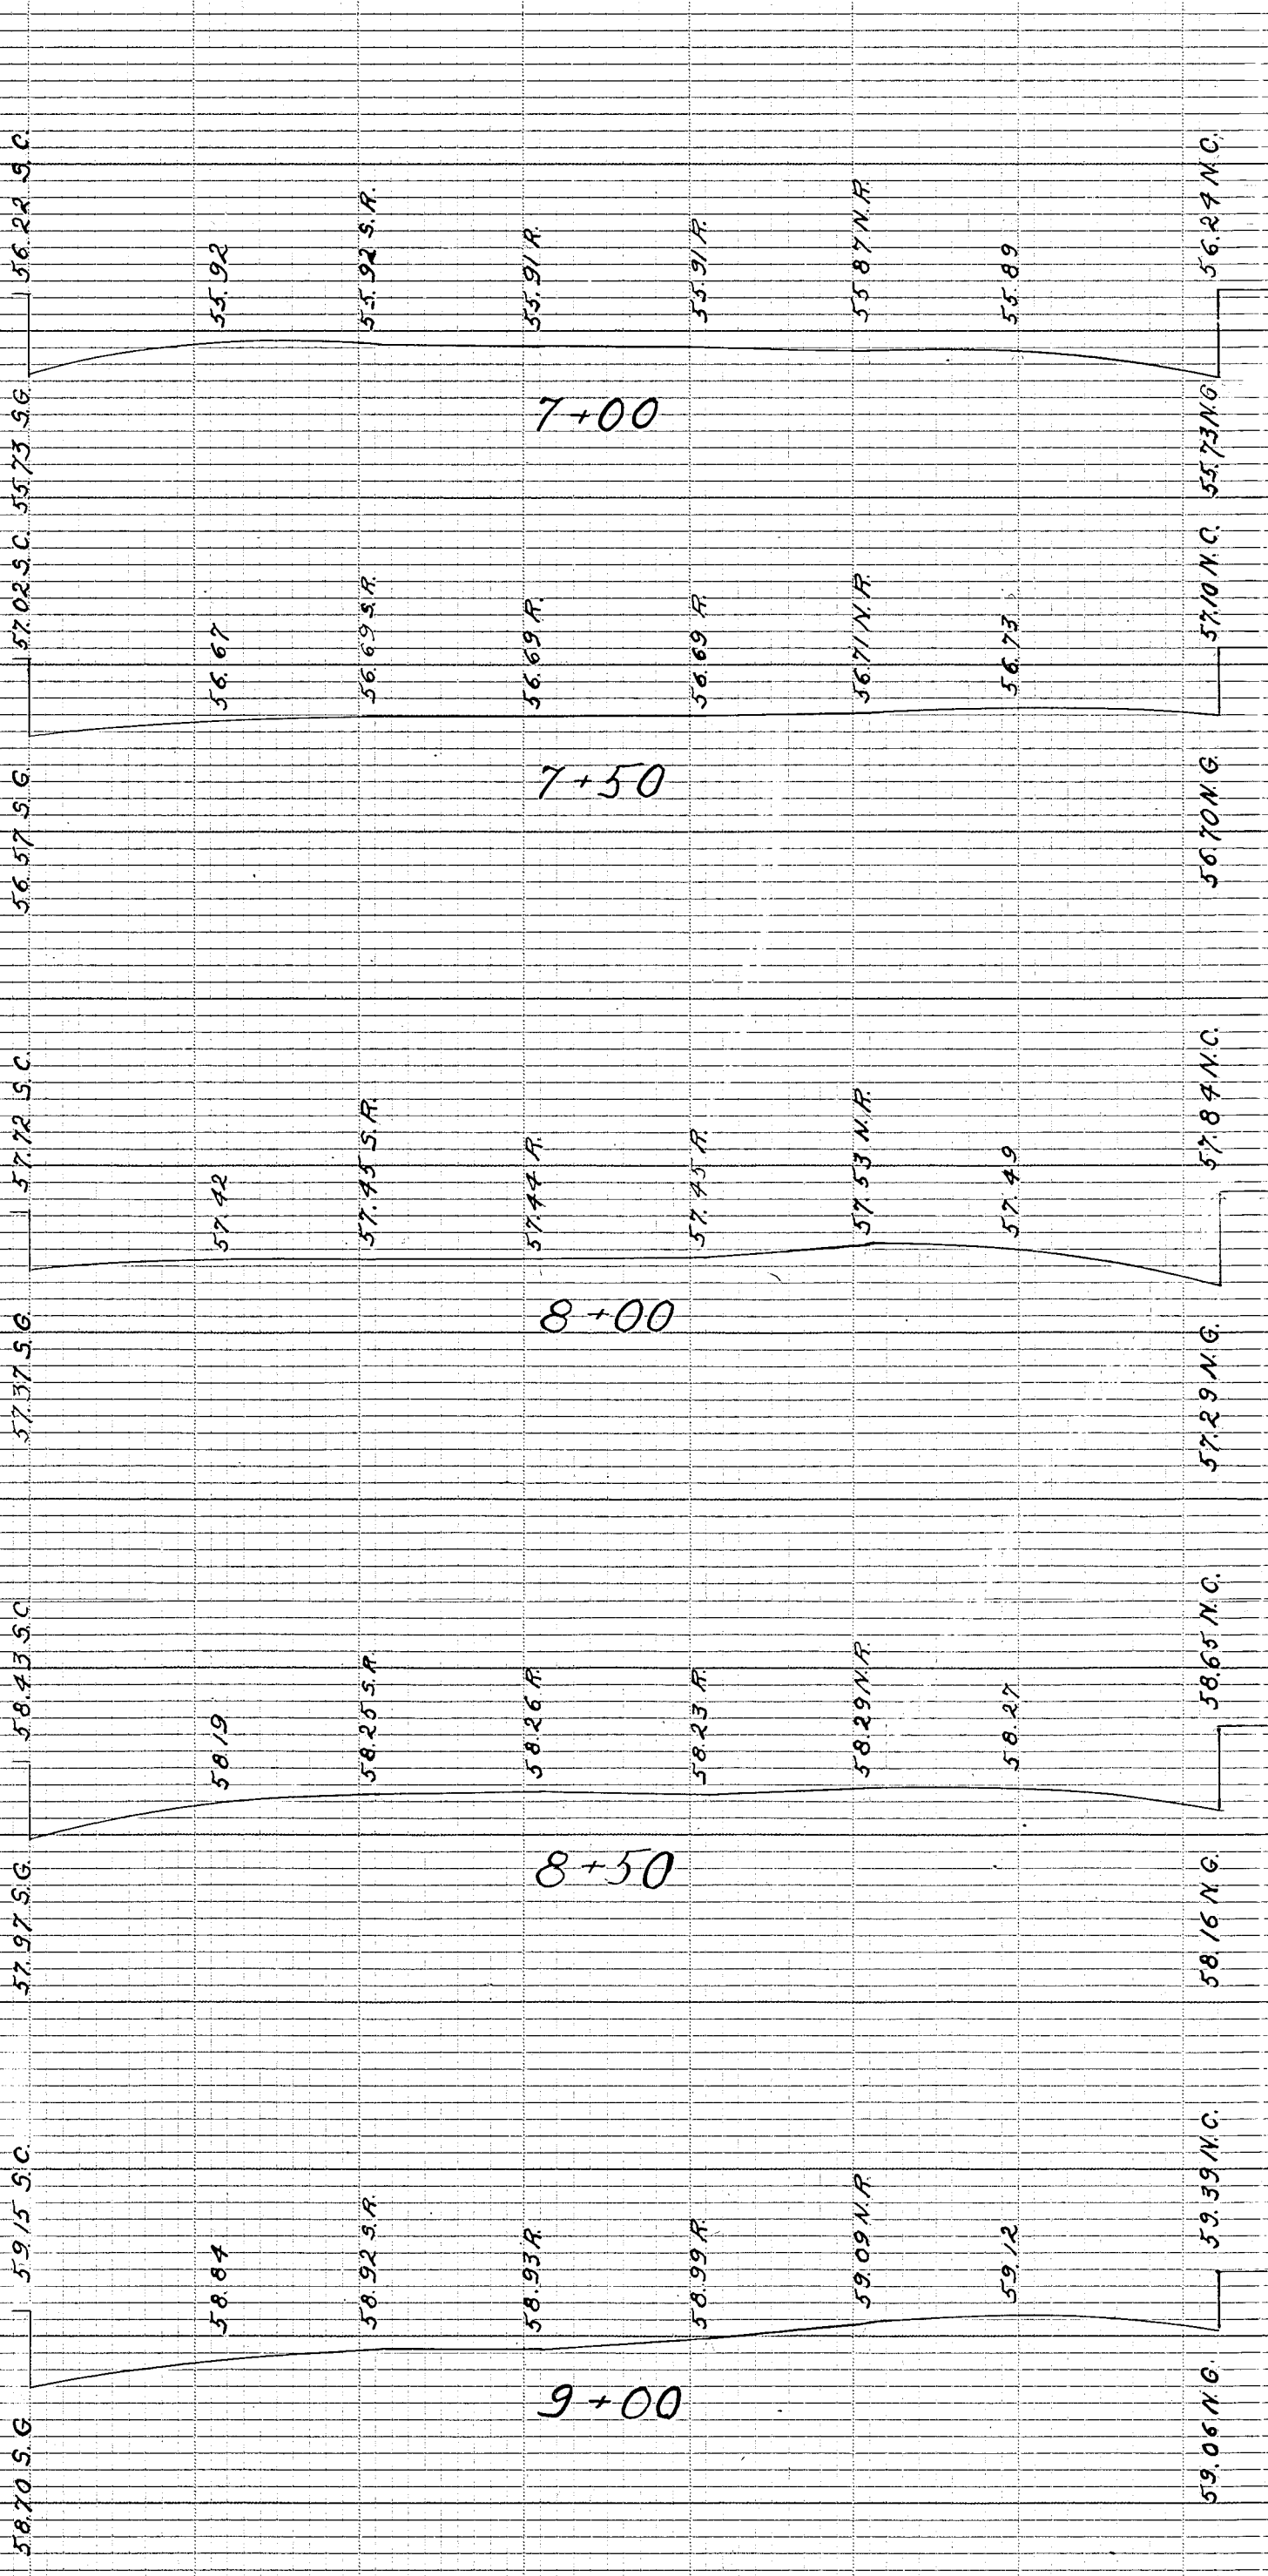
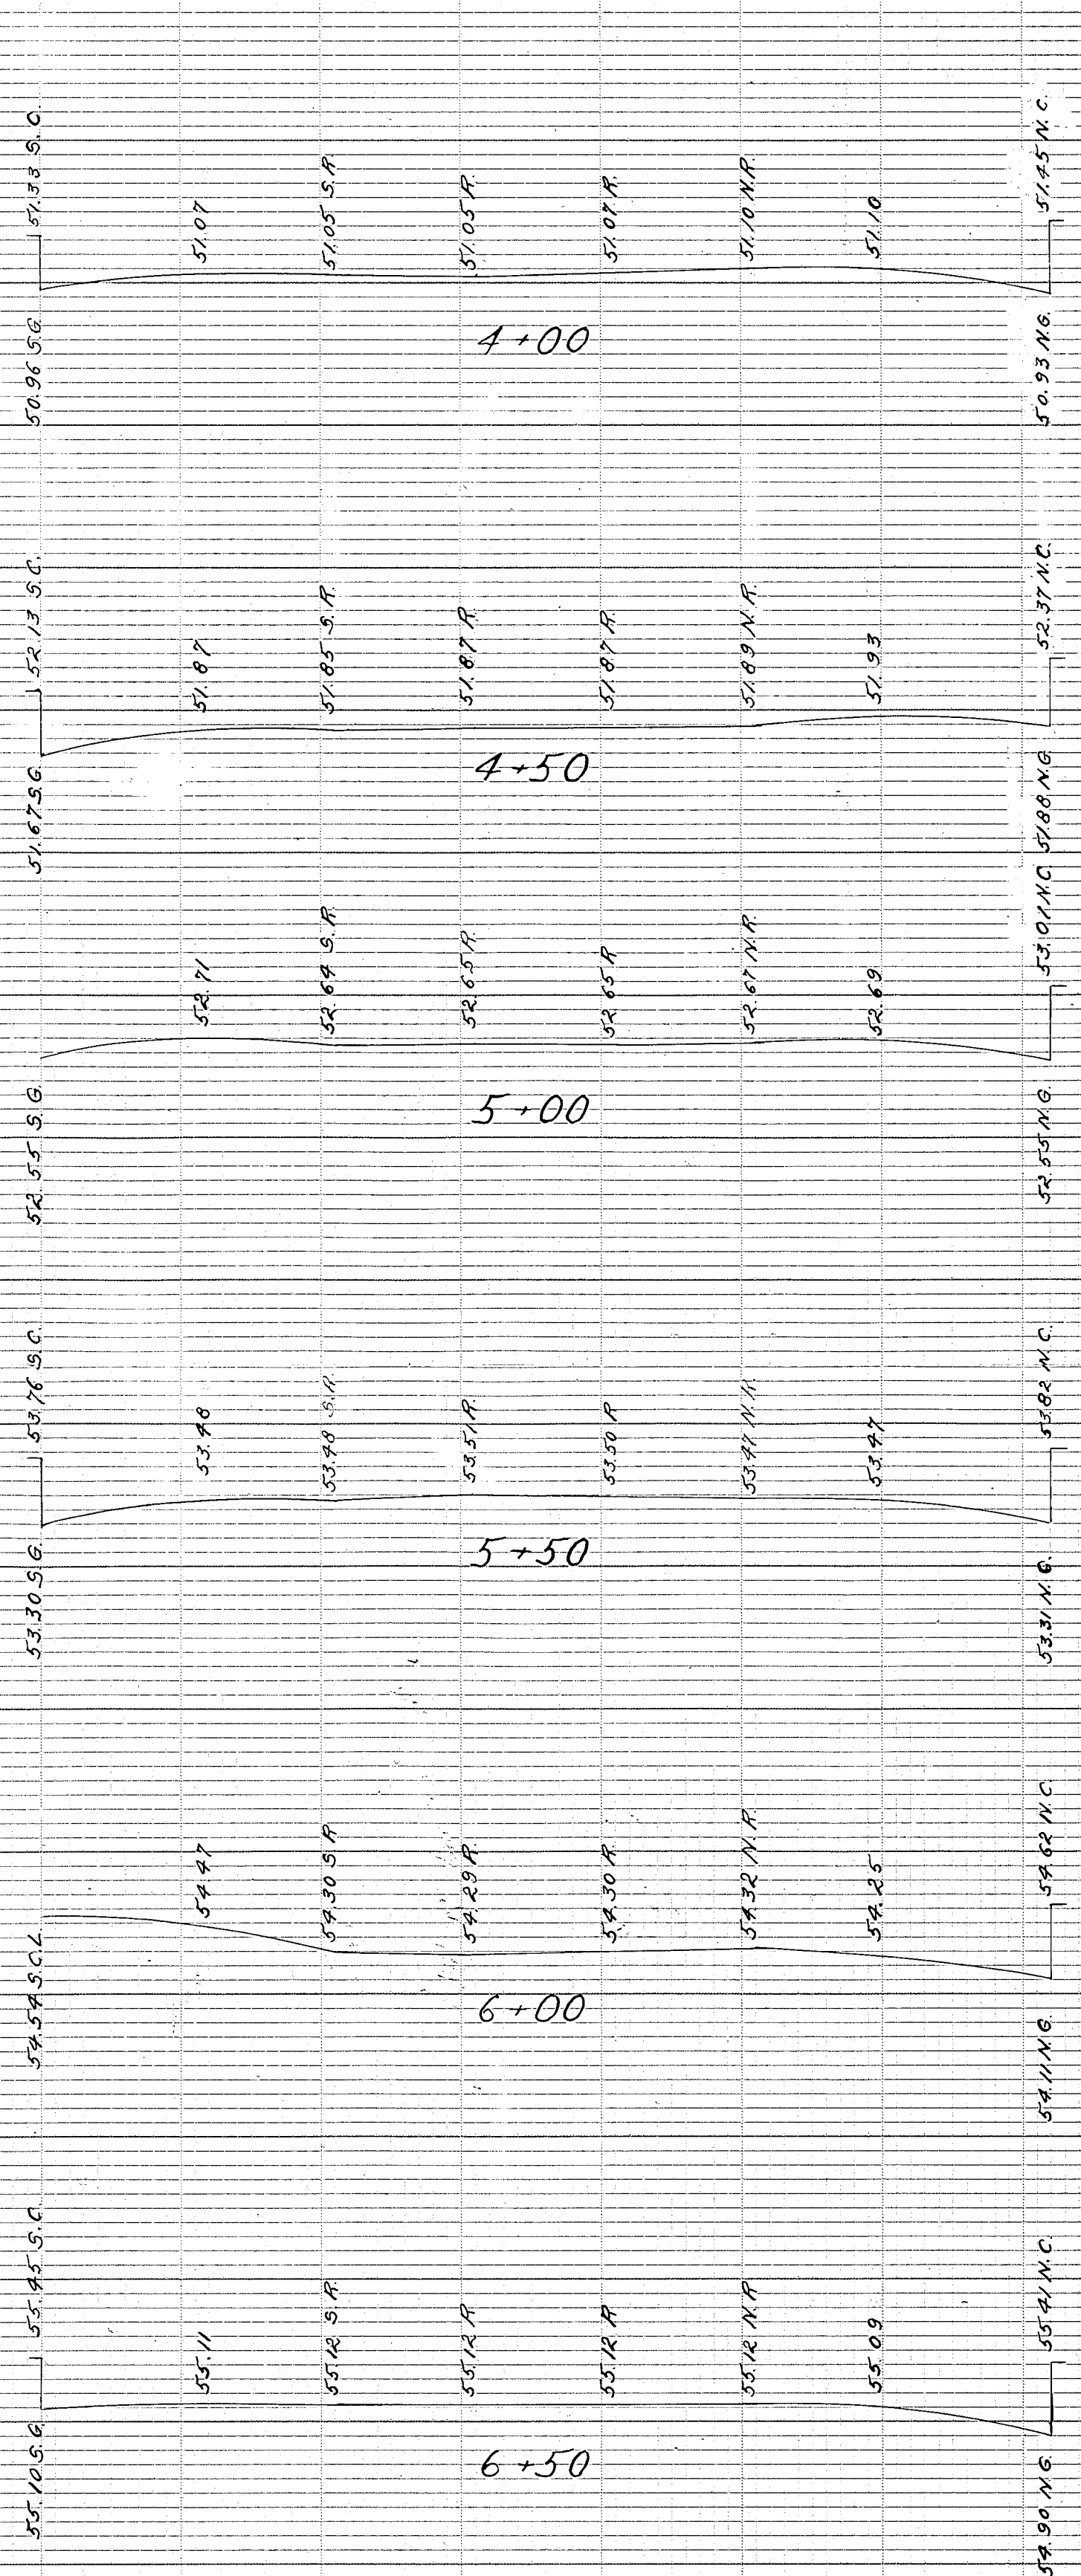


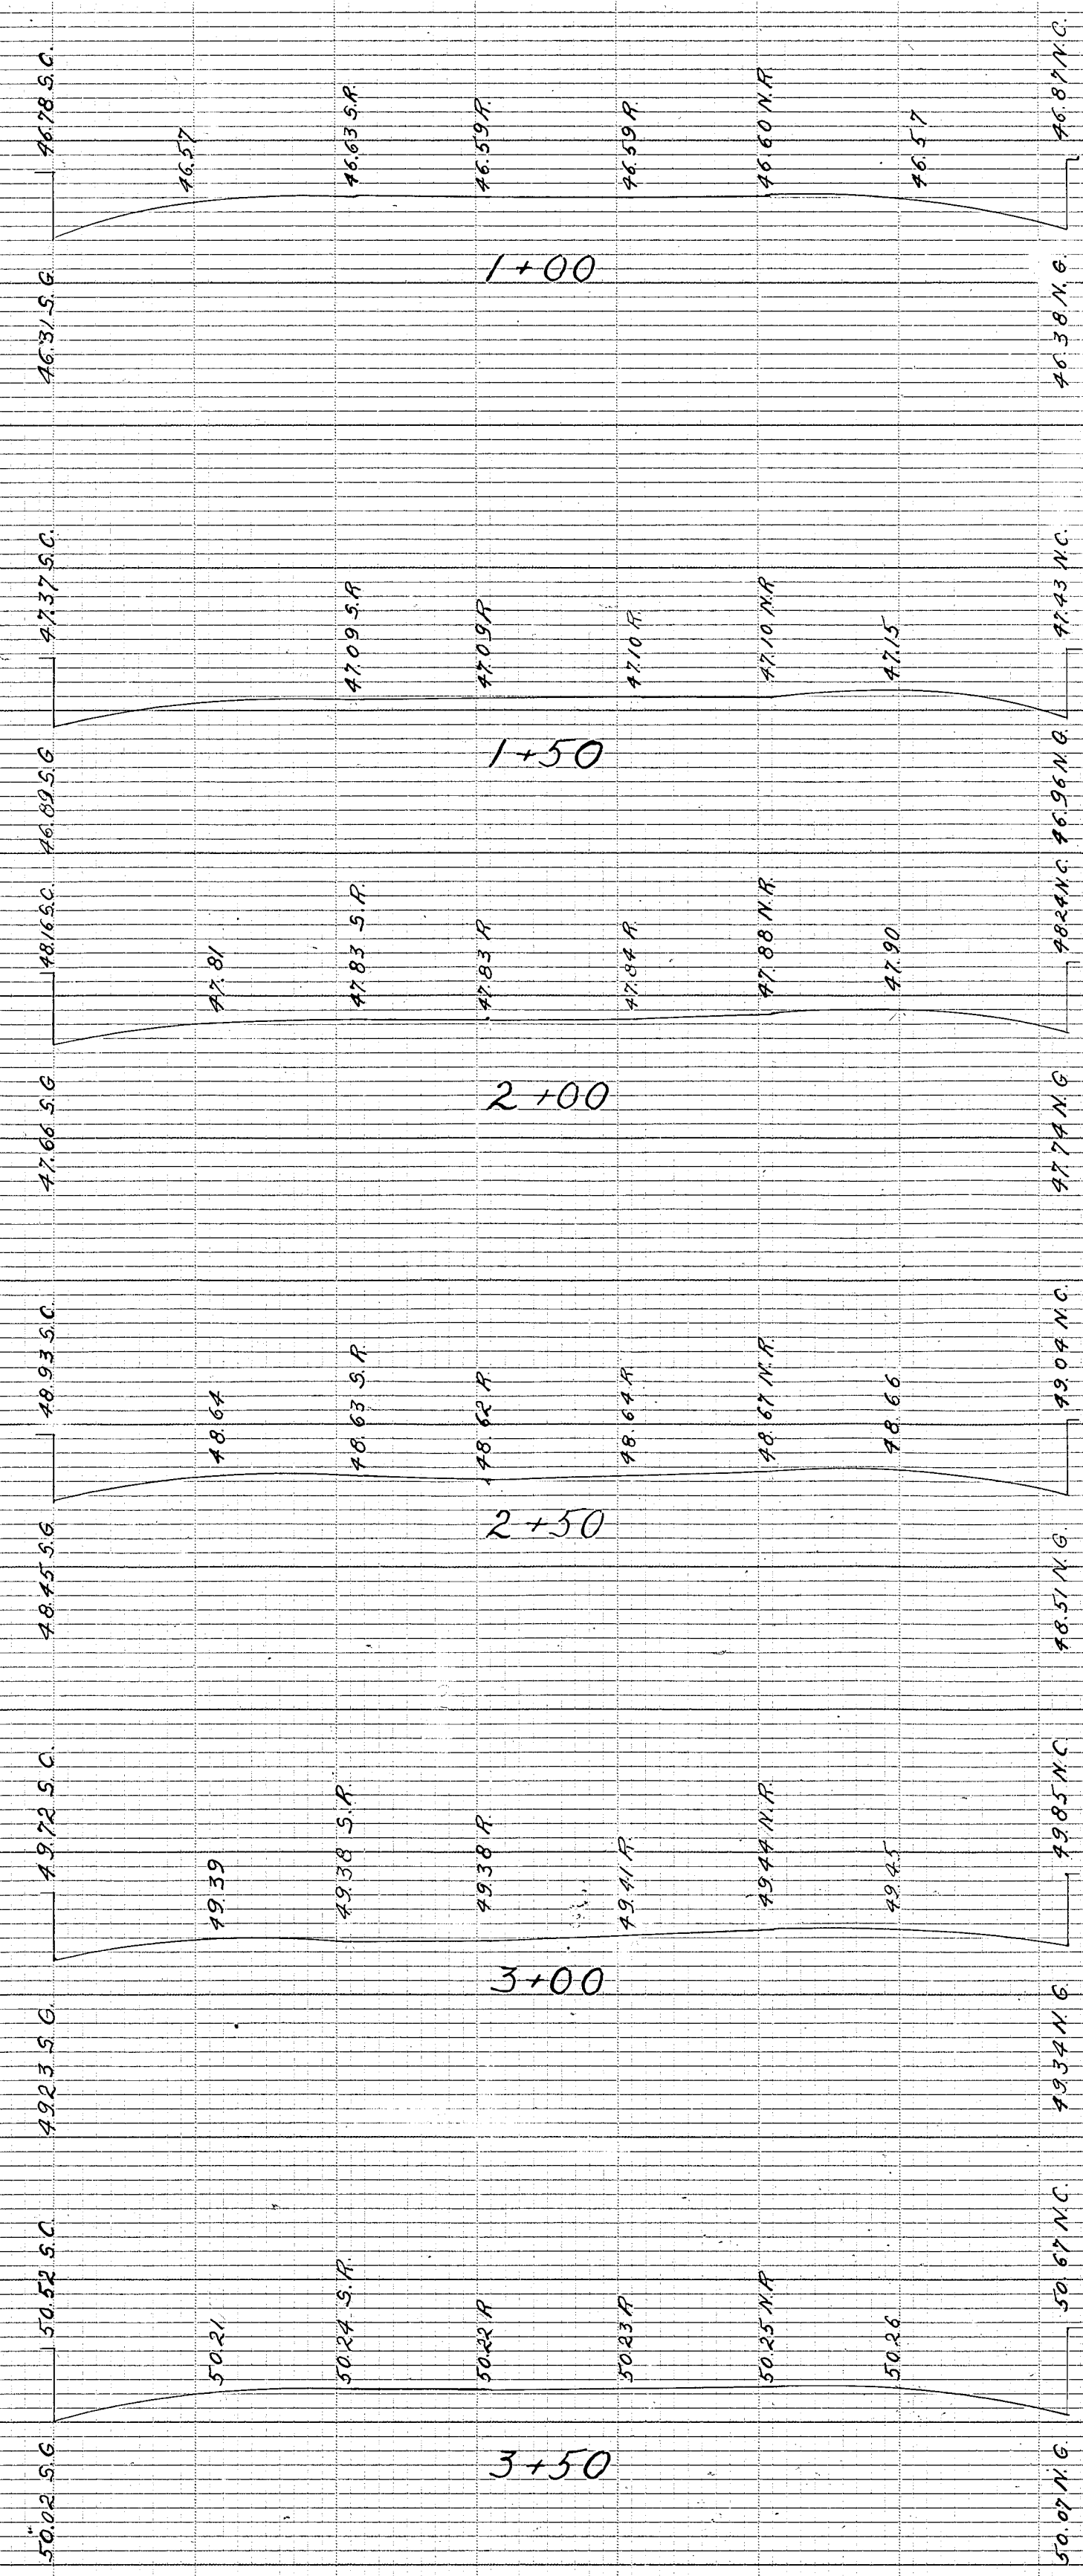

Capitol Avenue Cross Sections.  
 Park River to Laurel Street.  
 Scale { Hor. 1" = 5'  
 Ver. 1" = 1'  
 Note - Sections taken after completion of New Work.  
 See profile for stationing.