


F R A N K L I N Street and Building Lines of December 22, 1897 Vol. 3-26

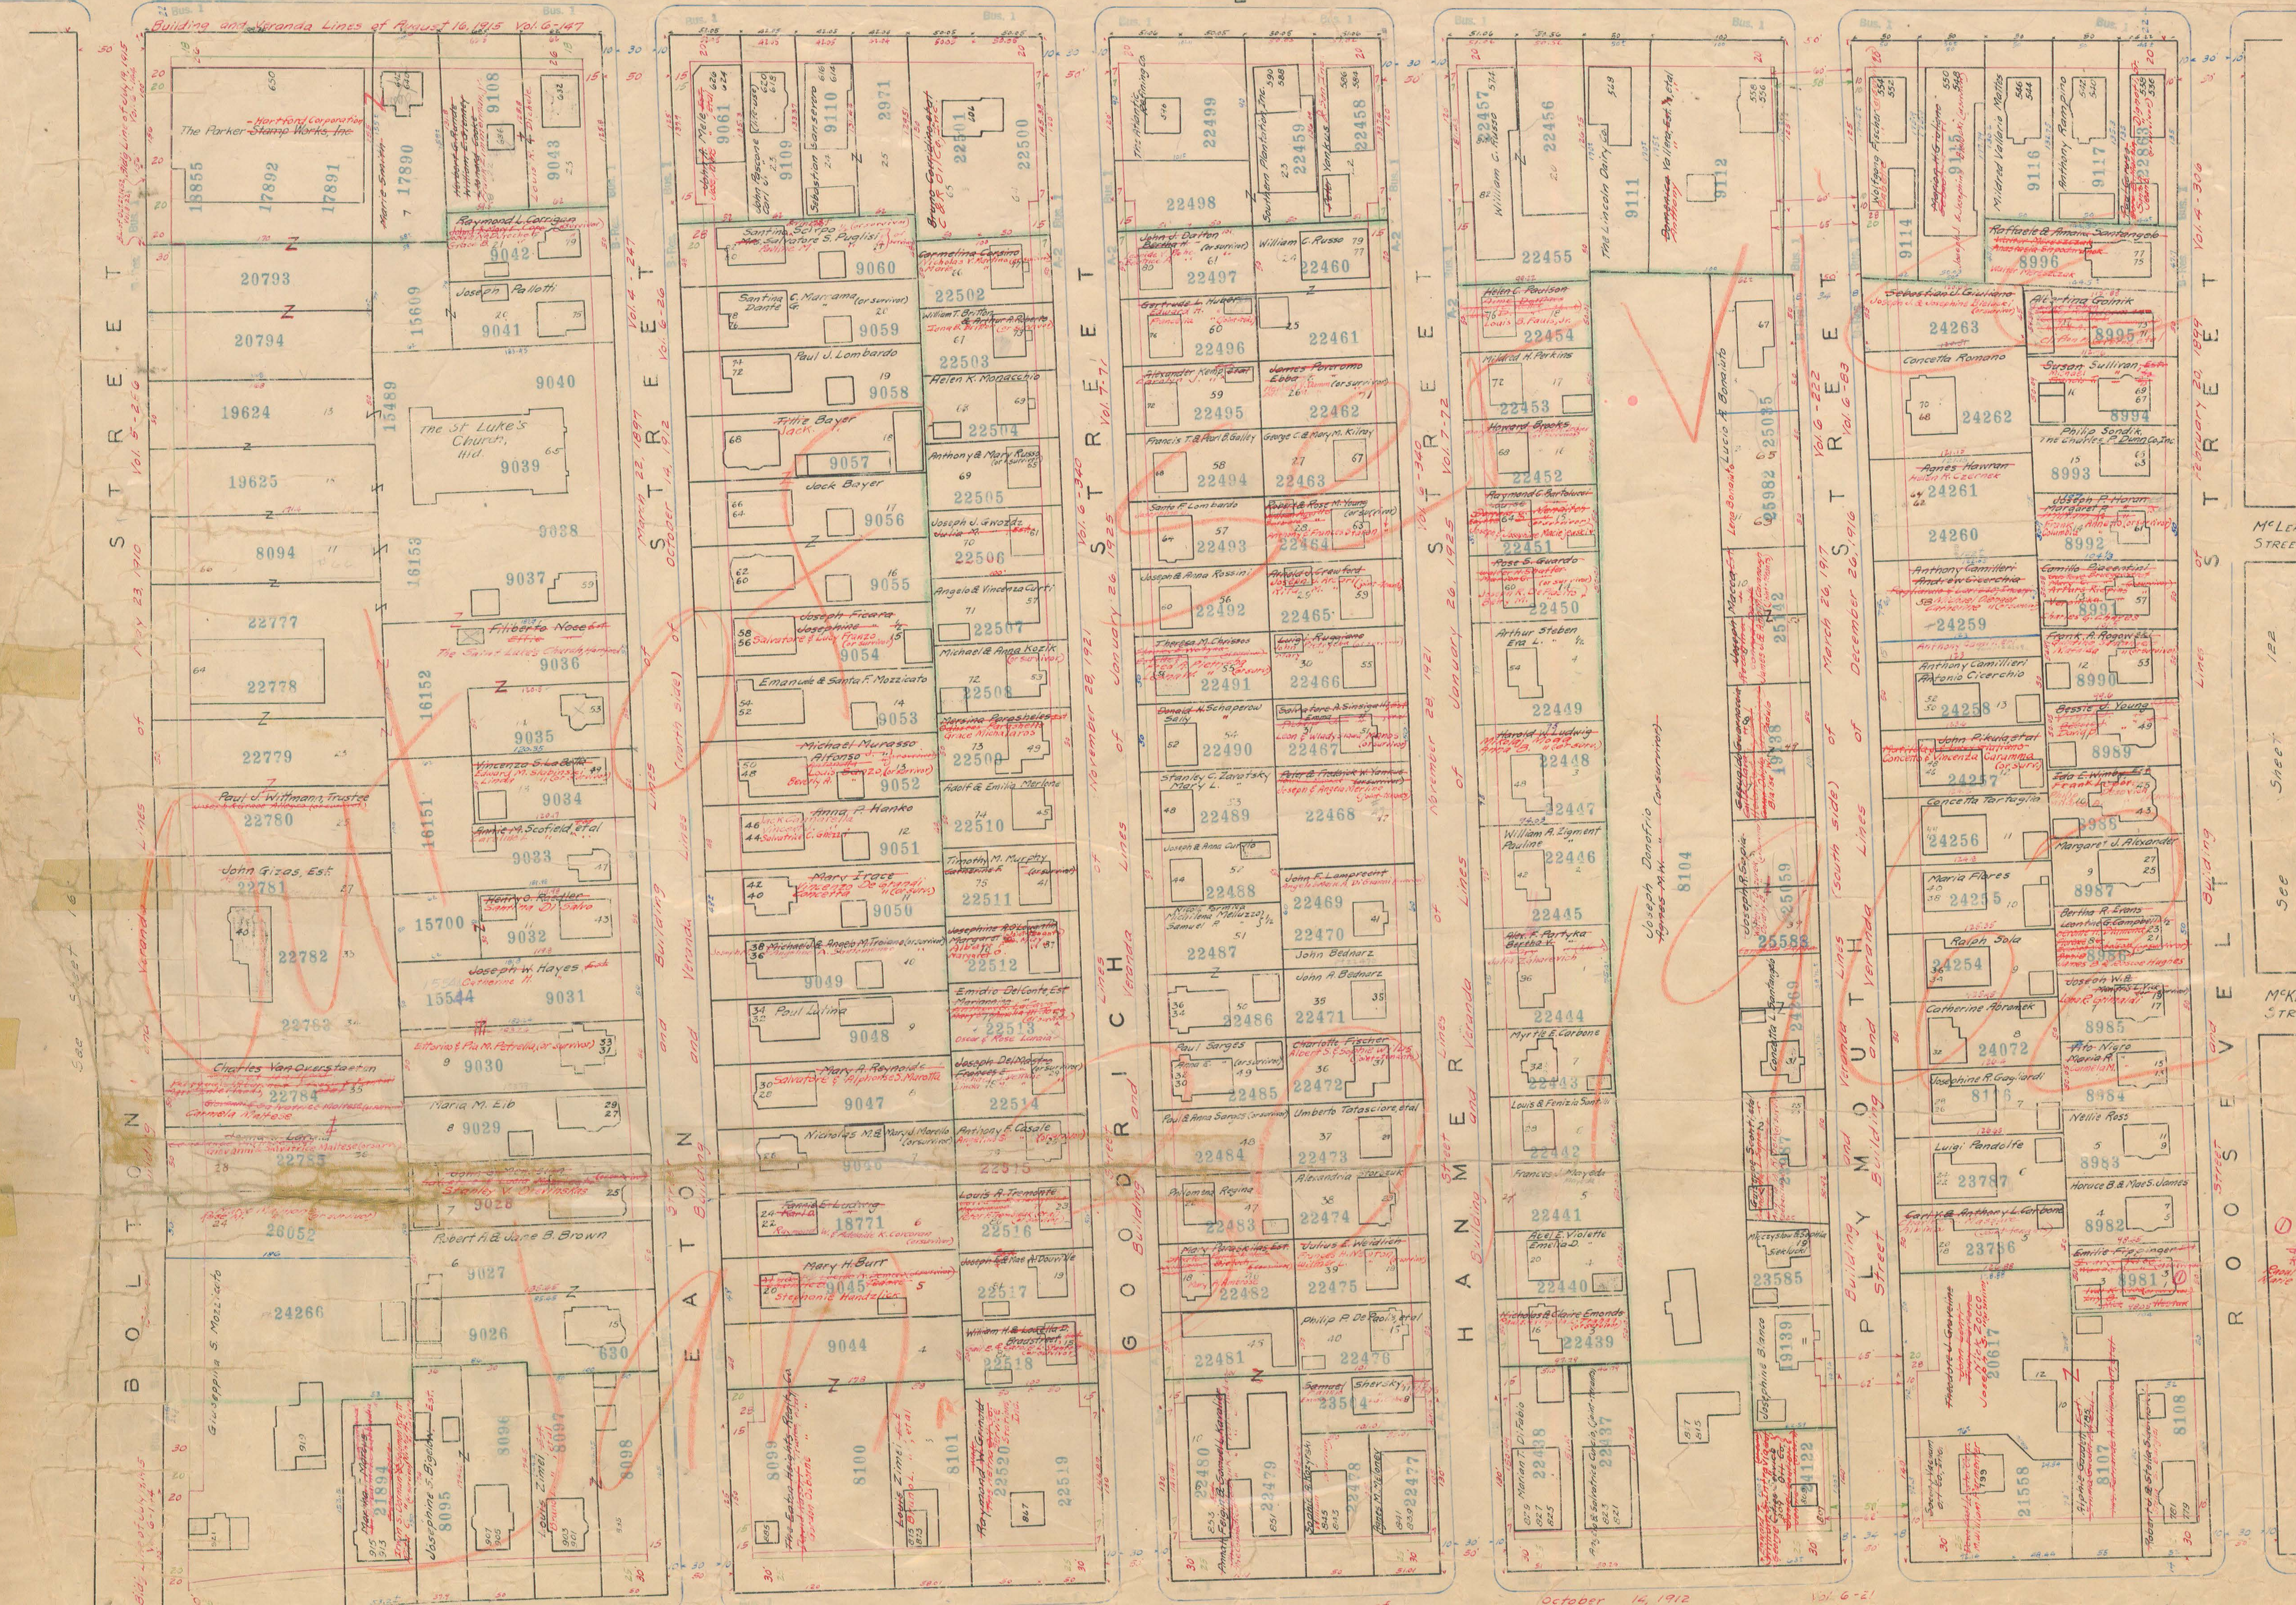

W E T H E R S F I E L D Street and Building Lines of April 11, 1893 Vol. 3-33