



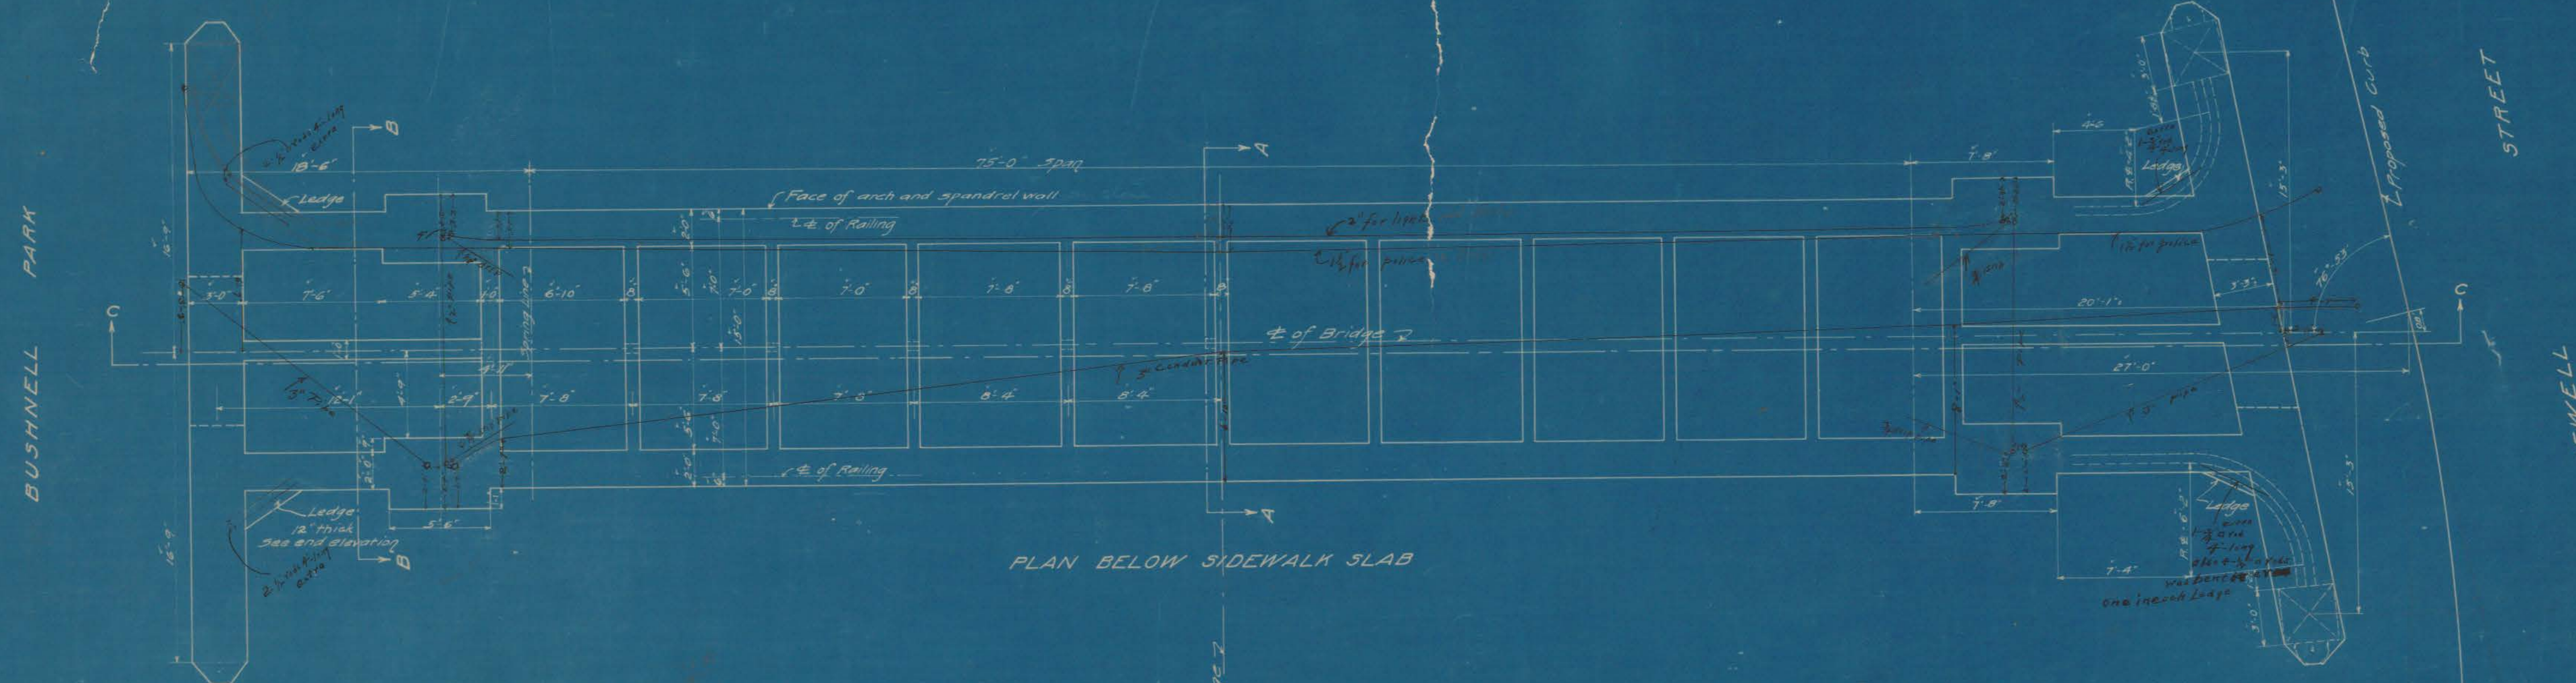


PLAN BELOW SIDEWALK SLAB

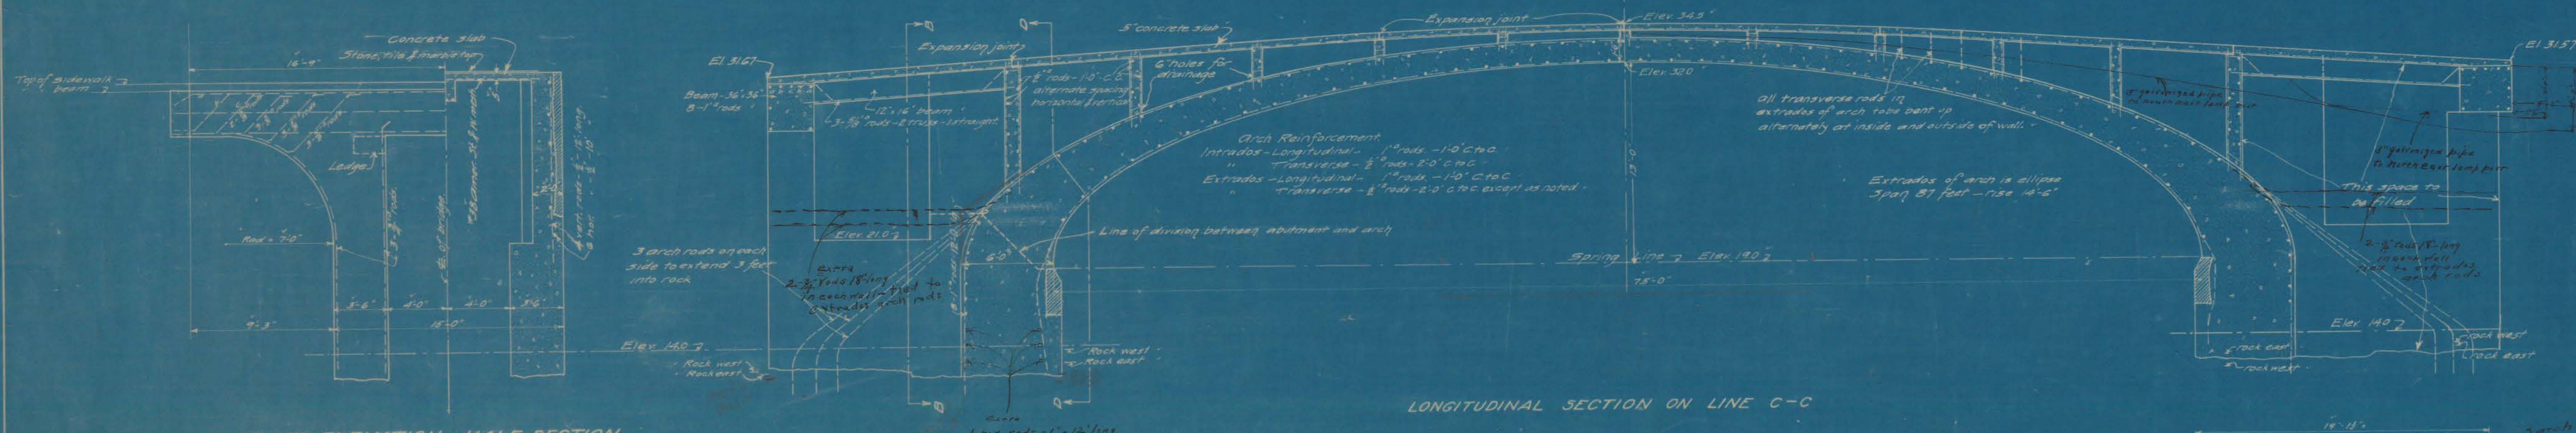

LONGITUDINAL SECTION ON LINE C-C


HALF END ELEVATION HALF SECTION ON LINE B-B

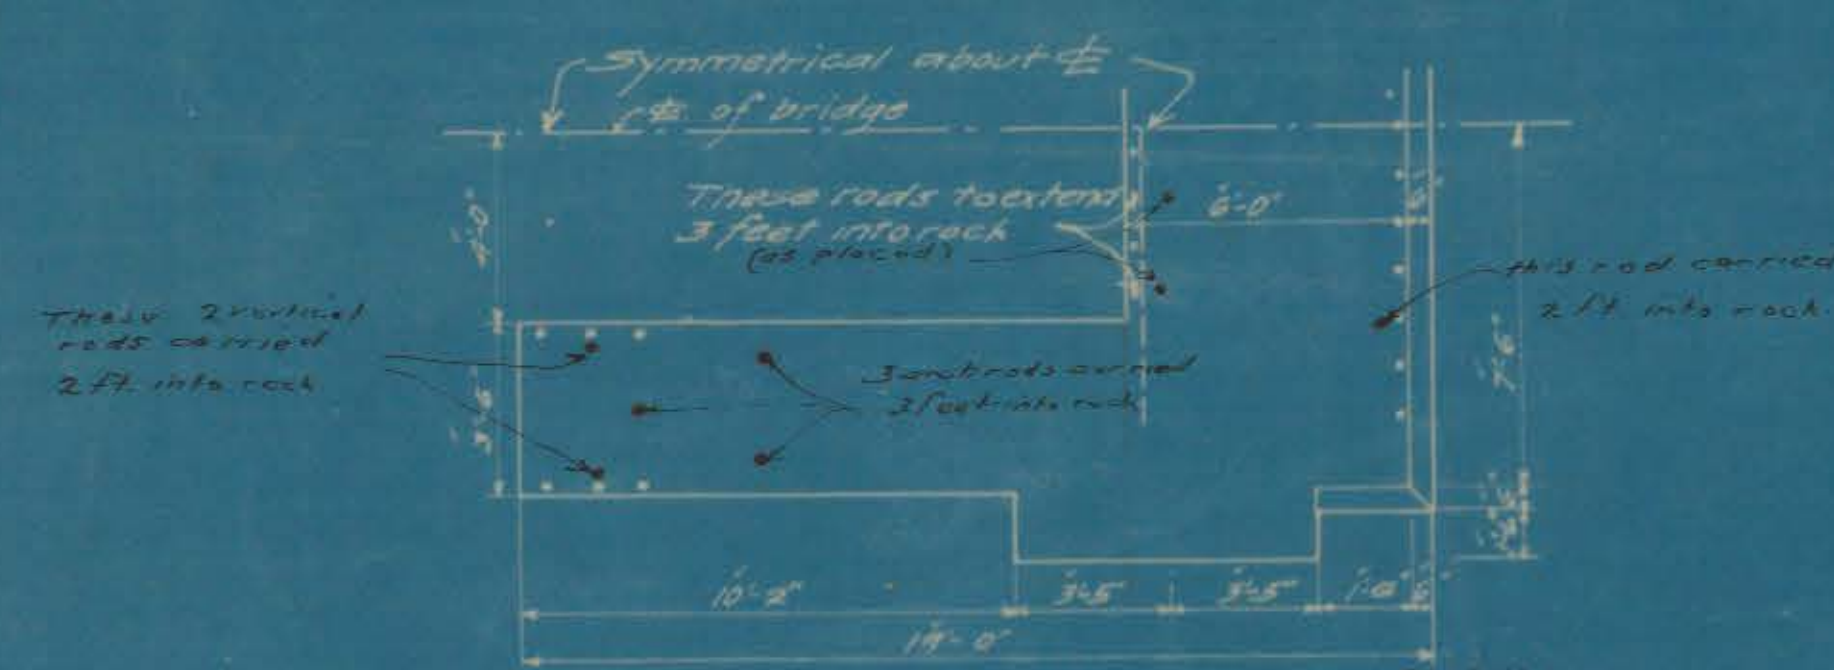

HALF FOUNDATION PLAN

Note: In connection with this plan see drawings Nos. 03701 and 03936

Note: Dimensions and reinforcement not shown on right half of bridge are same as left half

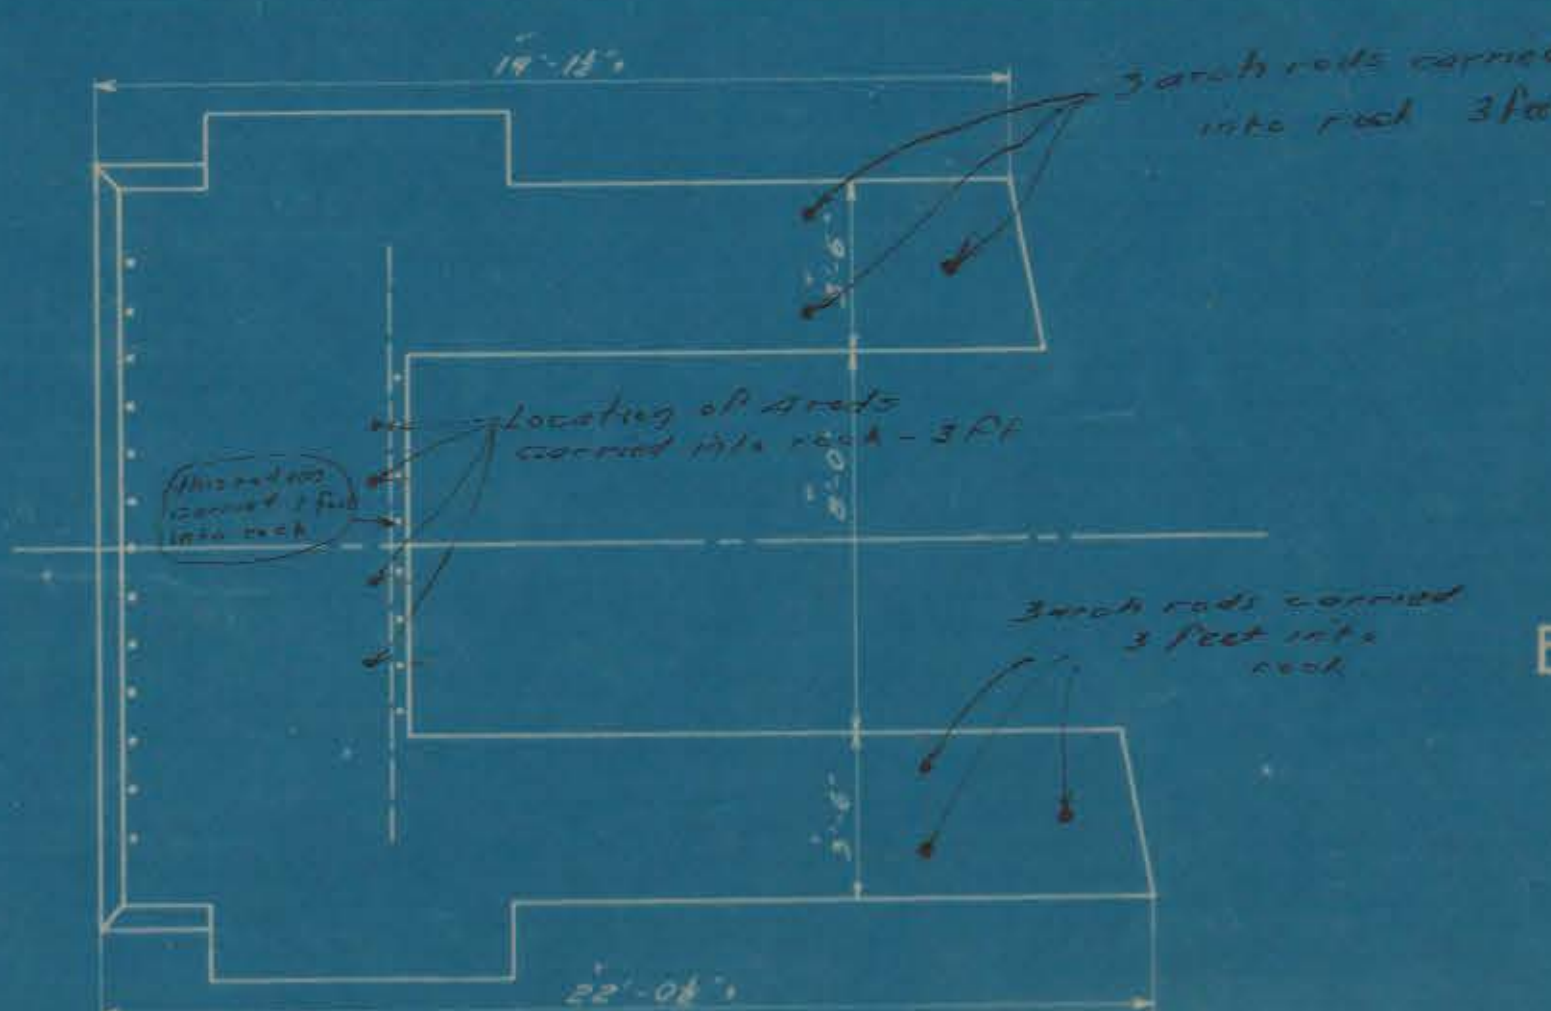

FOUNDATION PLAN

HALF SECTION ON LINE D-D HALF SECTION ON LINE A-A

OFFICE OF CITY ENGINEER
HARTFORD, CONN.
RECEIVED JULY 3, 1915
CITY ENGINEER

DEPARTMENT OF ENGINEERING
HARTFORD, CONN.
**BRIDGE OVER PARK RIVER AT
TRUMBULL STREET**
SCALE 1/8" = 1' FOOT

JULY 1915
DAYBOOK NO. 03635 DRAWER SHEET

Raymond M. Smith
CONSULTING ARCHITECT
CITY ENGINEER