


PROPERTY LINE 586'-1 1/2"

PRESENT BUILDINGS
DOTTED LINES

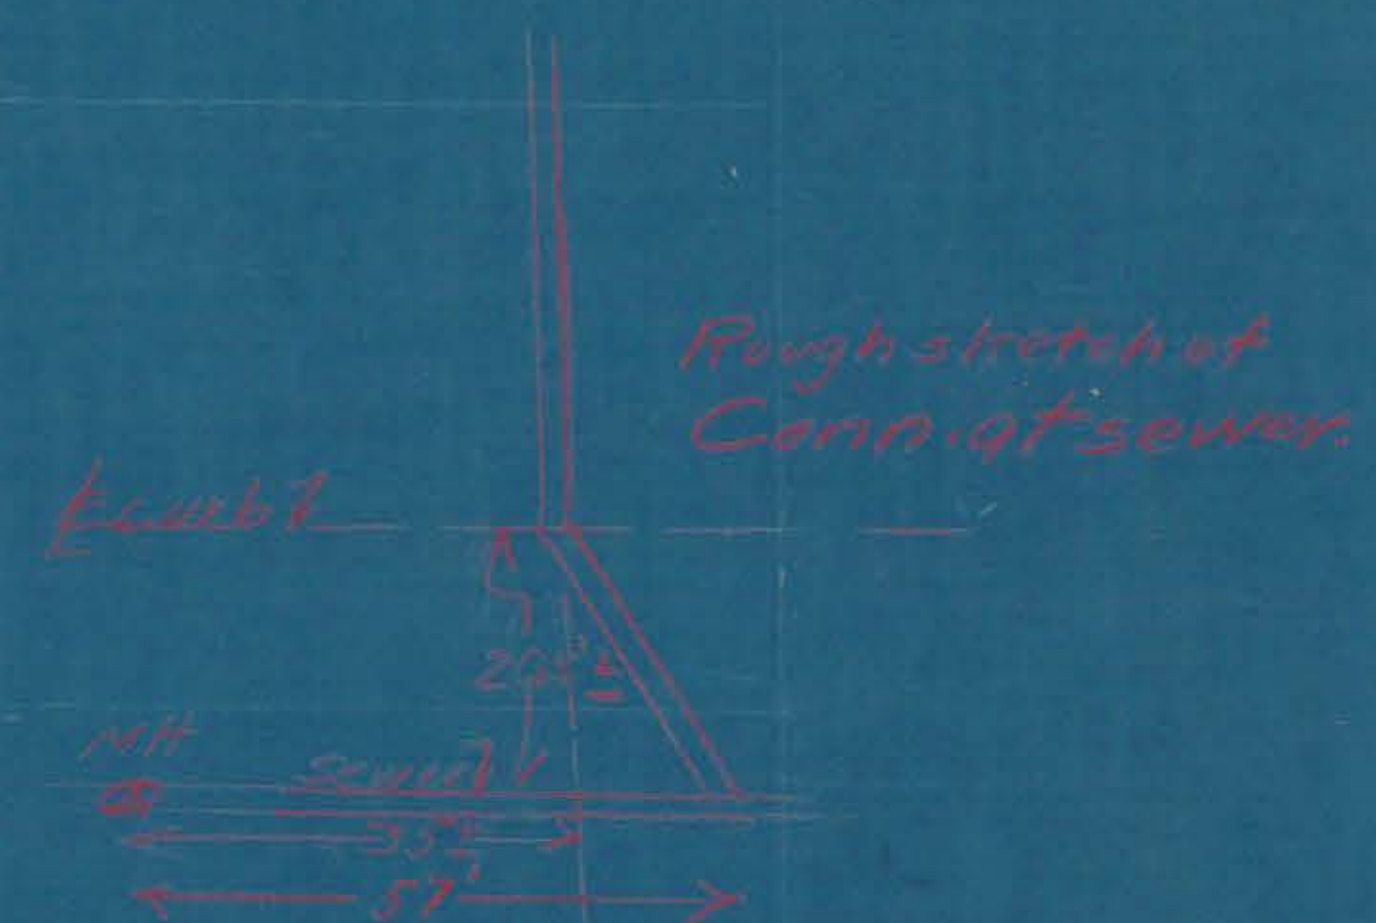

H.G. Permit #7971
New Park Avenue
Doris O'Brien & Son, Inc.

Took out 2-2 pieces of tile and replaced with 1-18" dia.
3' long x 1-1/2' piece of tile. Triple break ring of brick
around each joint.

Layout of Underground Piping
Scale 1/8" = 1'-0". May 9, 1916. -J.L.D. -W.H.T.
Royal Typewriter Co.
Hartford Conn.

OFFICE OF CITY ENGINEER
HARTFORD, CONN.
June 14, 1916. (24-3-4)
R.N. Clark, City Engineer

NOTE. Furnish and install Underground Piping
complete, also connect same to present
drain as shown.

NEW PARK AVE. 60' WIDE