


"HOME GARDENS"

HARTFORD, CONNECTICUT

Scale 1 in = 60 ft. April, 1917.

PROPERTY OF NORMAN M. LOOMIS

CHOLMSTED, Eng.

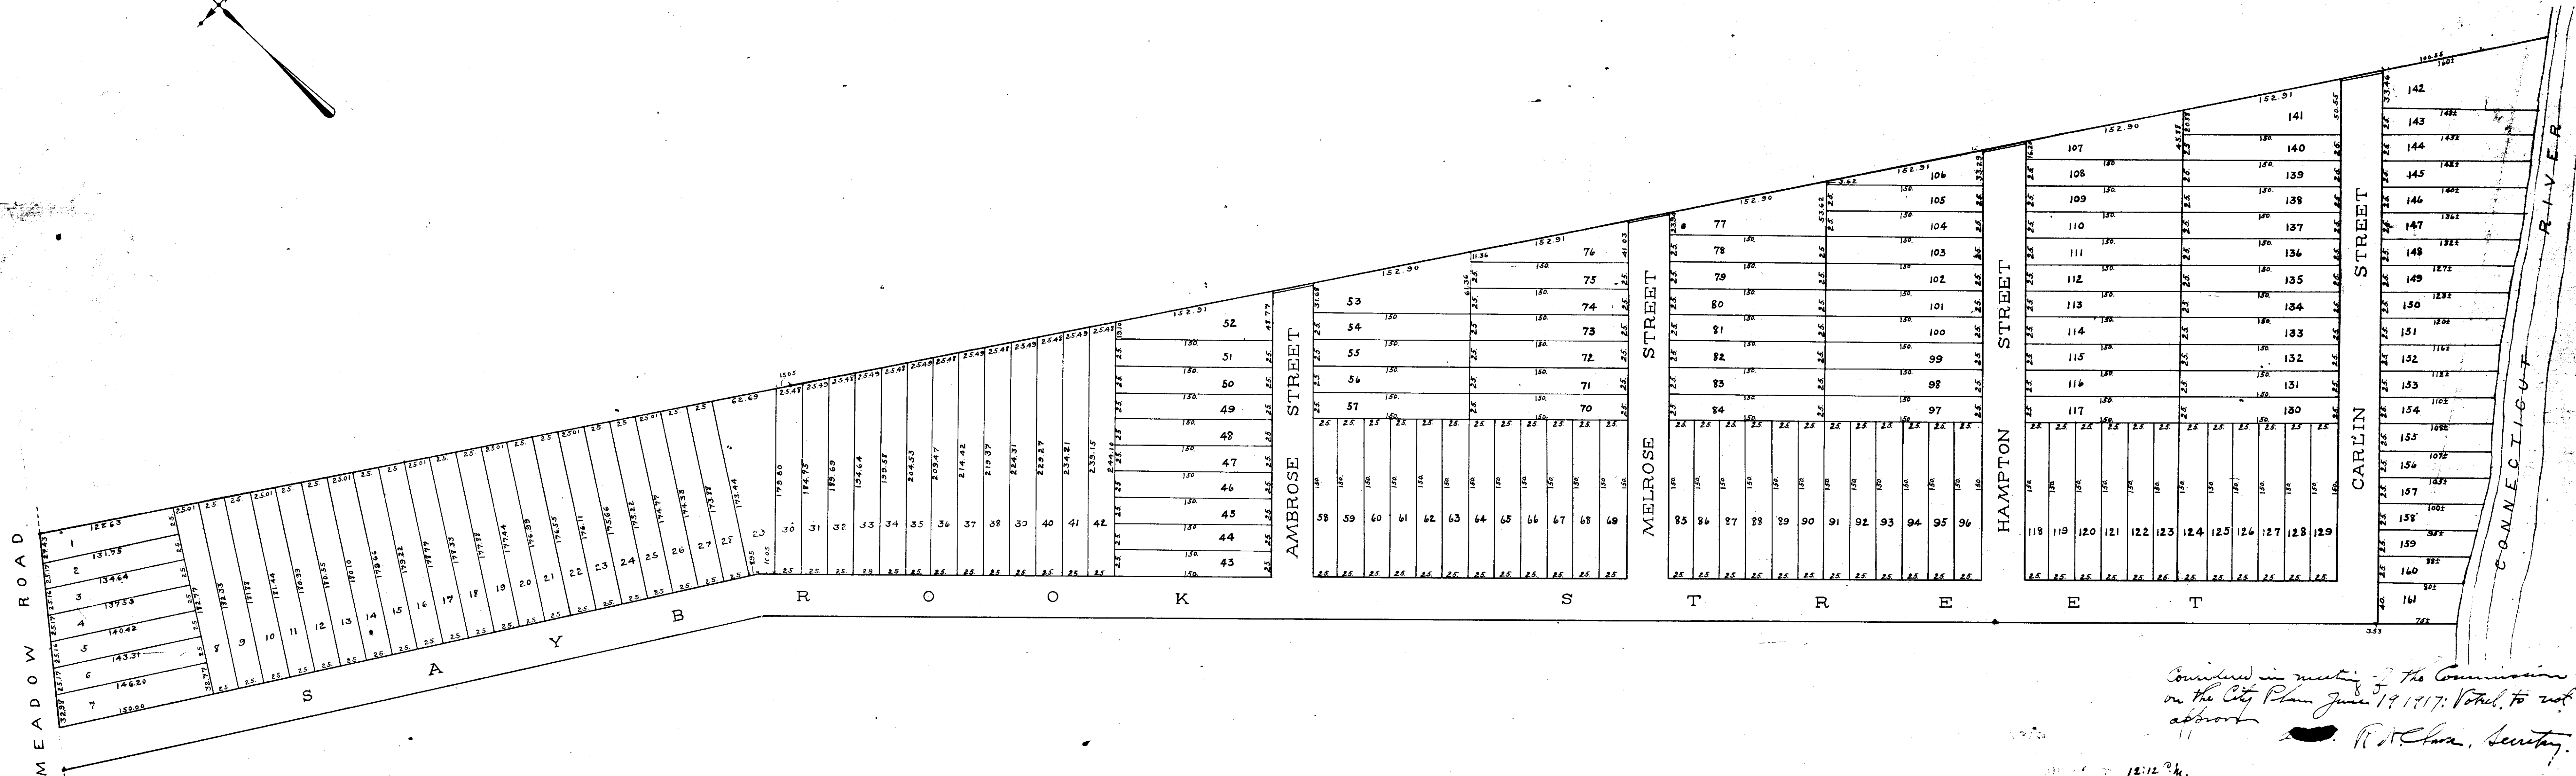

Considered in meeting of the Commission
on the City Plan June 19 1917. Voted to not
approve
R. S. Chase, Secretary.

12:12 P.M.
Omit
I hereby certify that the above plan
is substantially correct estimated C.E.