


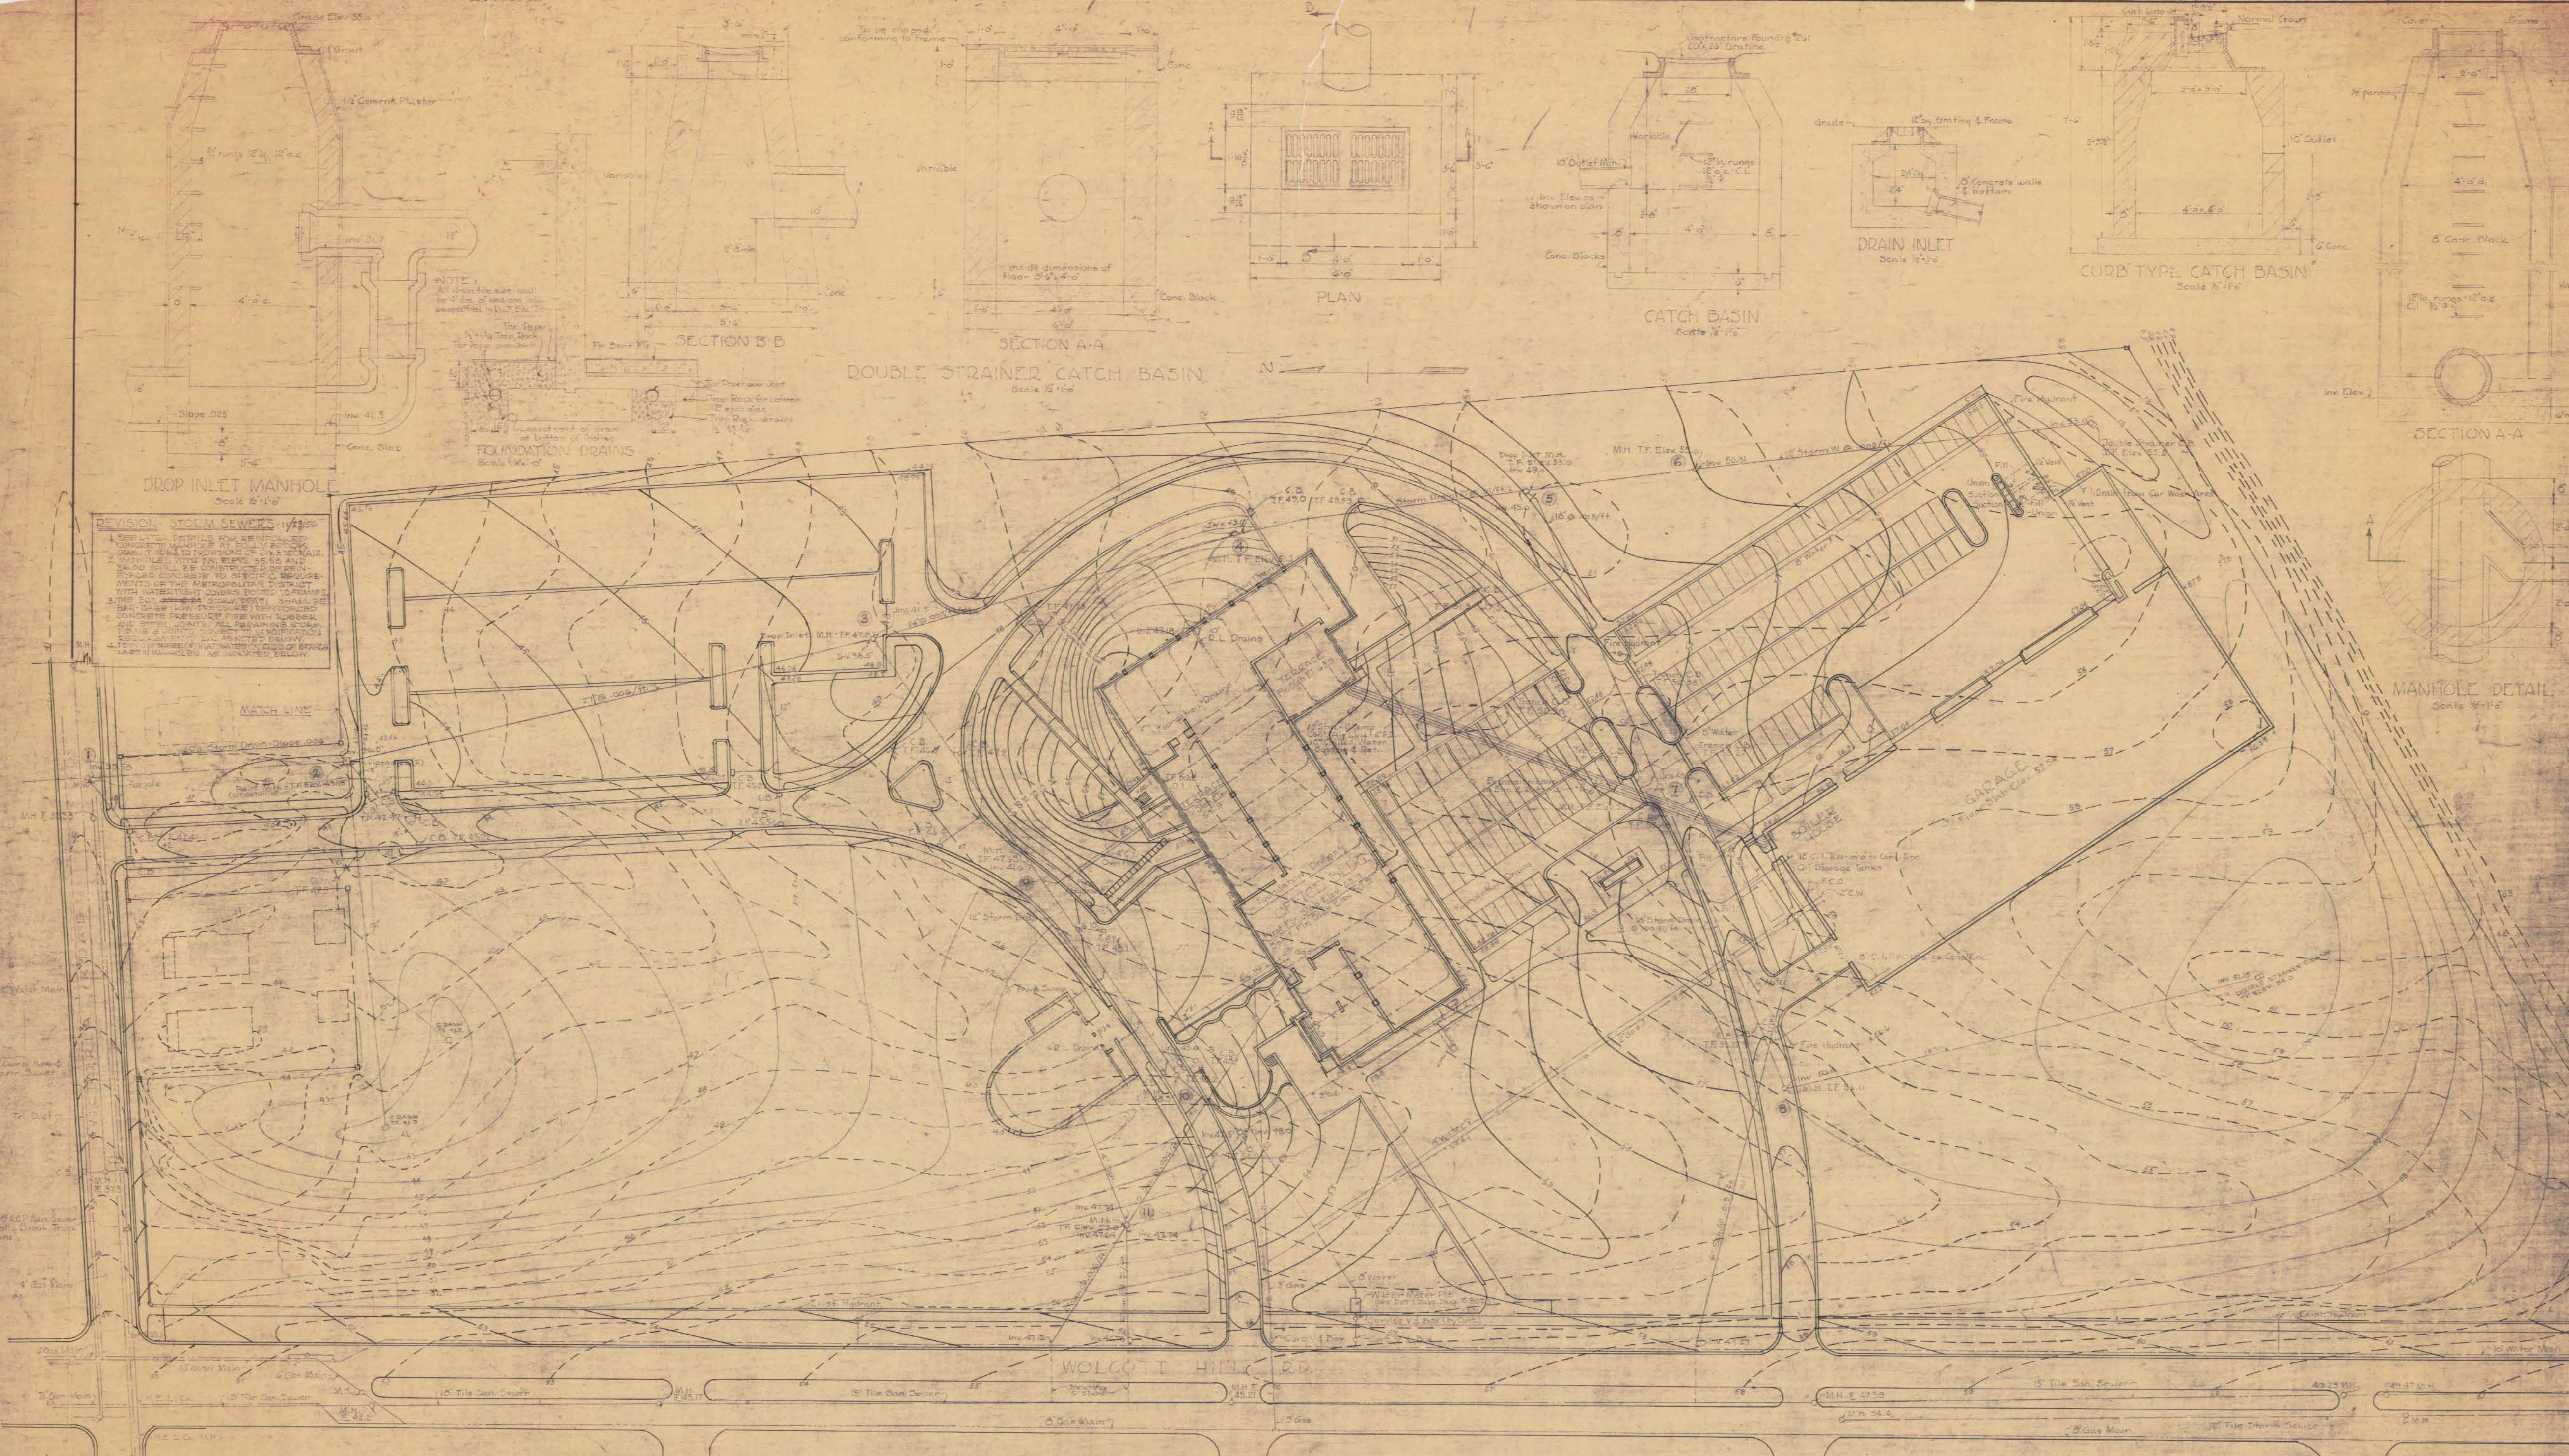

REVISION STORM SEWERS - 11/2/50
1. SEE L.T. 2. DETAILS FOR REINFORCED CONCRETE MANHOLES & CATCH BASINS. 3. SEE L.T. 3. DETAILS FOR 18" DIA. STORM SEWERS. 4. SEE L.T. 4. DETAILS FOR 12" DIA. STORM SEWERS. 5. SEE L.T. 5. DETAILS FOR 10" DIA. STORM SEWERS. 6. SEE L.T. 6. DETAILS FOR 8" DIA. STORM SEWERS. 7. SEE L.T. 7. DETAILS FOR 6" DIA. STORM SEWERS. 8. SEE L.T. 8. DETAILS FOR 4" DIA. STORM SEWERS. 9. SEE L.T. 9. DETAILS FOR 3" DIA. STORM SEWERS. 