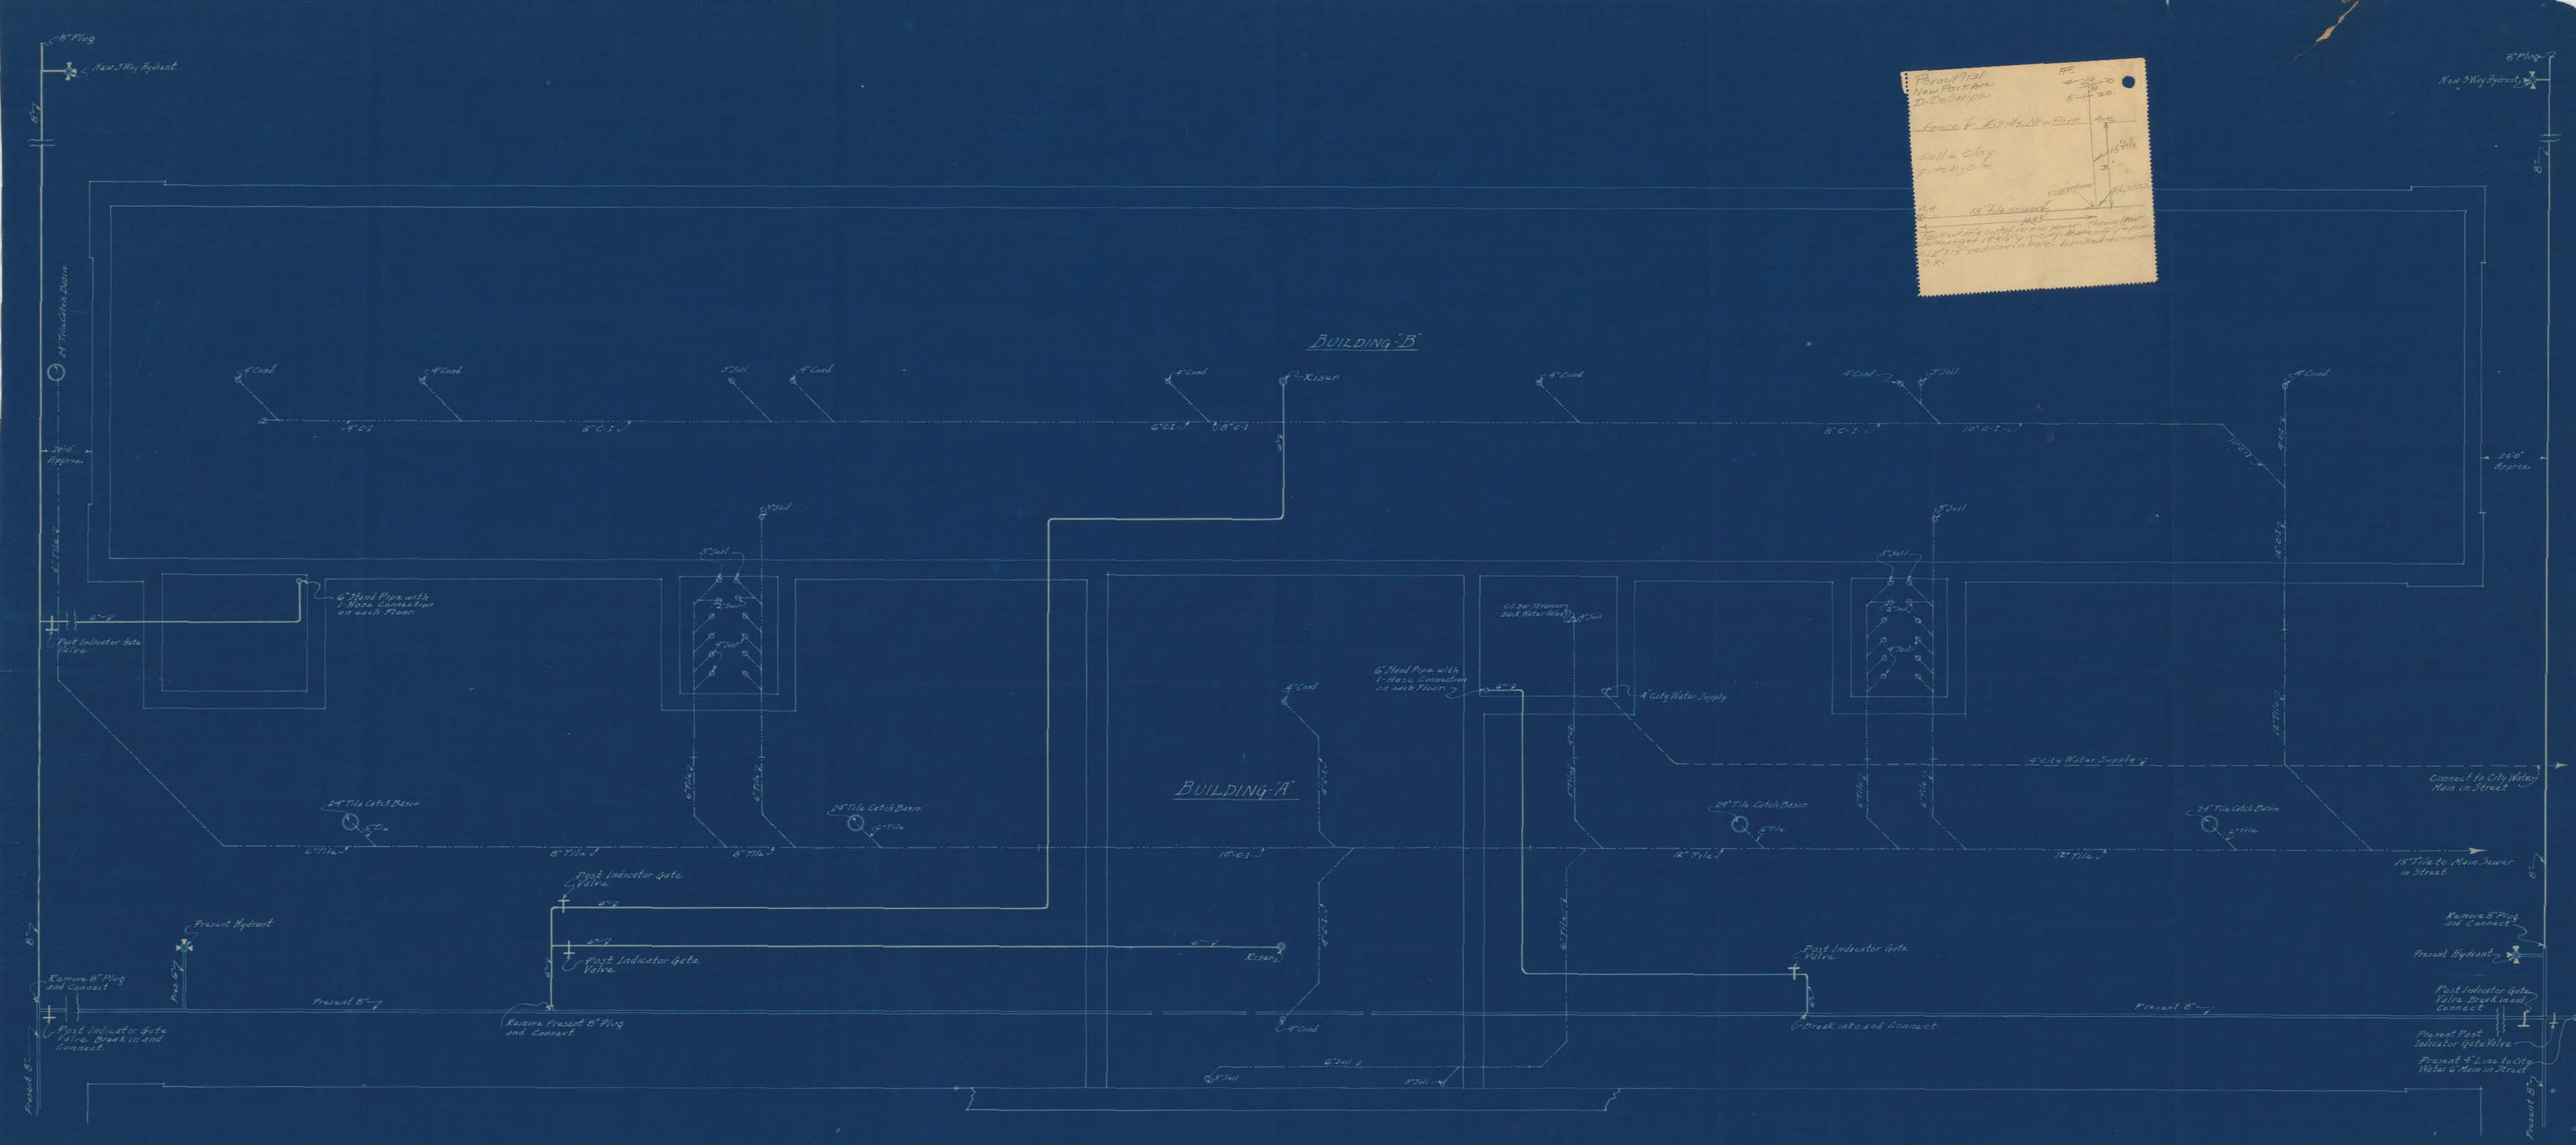

Sewer Pipe Tile	Indicated thus.
Sewer Pipe Iron	"
Fire Protection Pipe Old	"
Fire Protection Pipe New	"
City Water Supply	

PLAN SHOWING UNDERGROUND SEWER PIPING AND UNDERGROUND FIRE PROTECTION PIPES

SCALE 1/8 IN = 1 FT.

BUILDINGS TO BE ADDED TO THE PLANT OF
THE ROYAL TYPEWRITER CO. INC.
AT
HARTFORD CONN.

DEL. [illegible] DATE [illegible]
TR. [illegible] DATE [illegible]

APPROVED [illegible]
[illegible]