


See Sheet 166

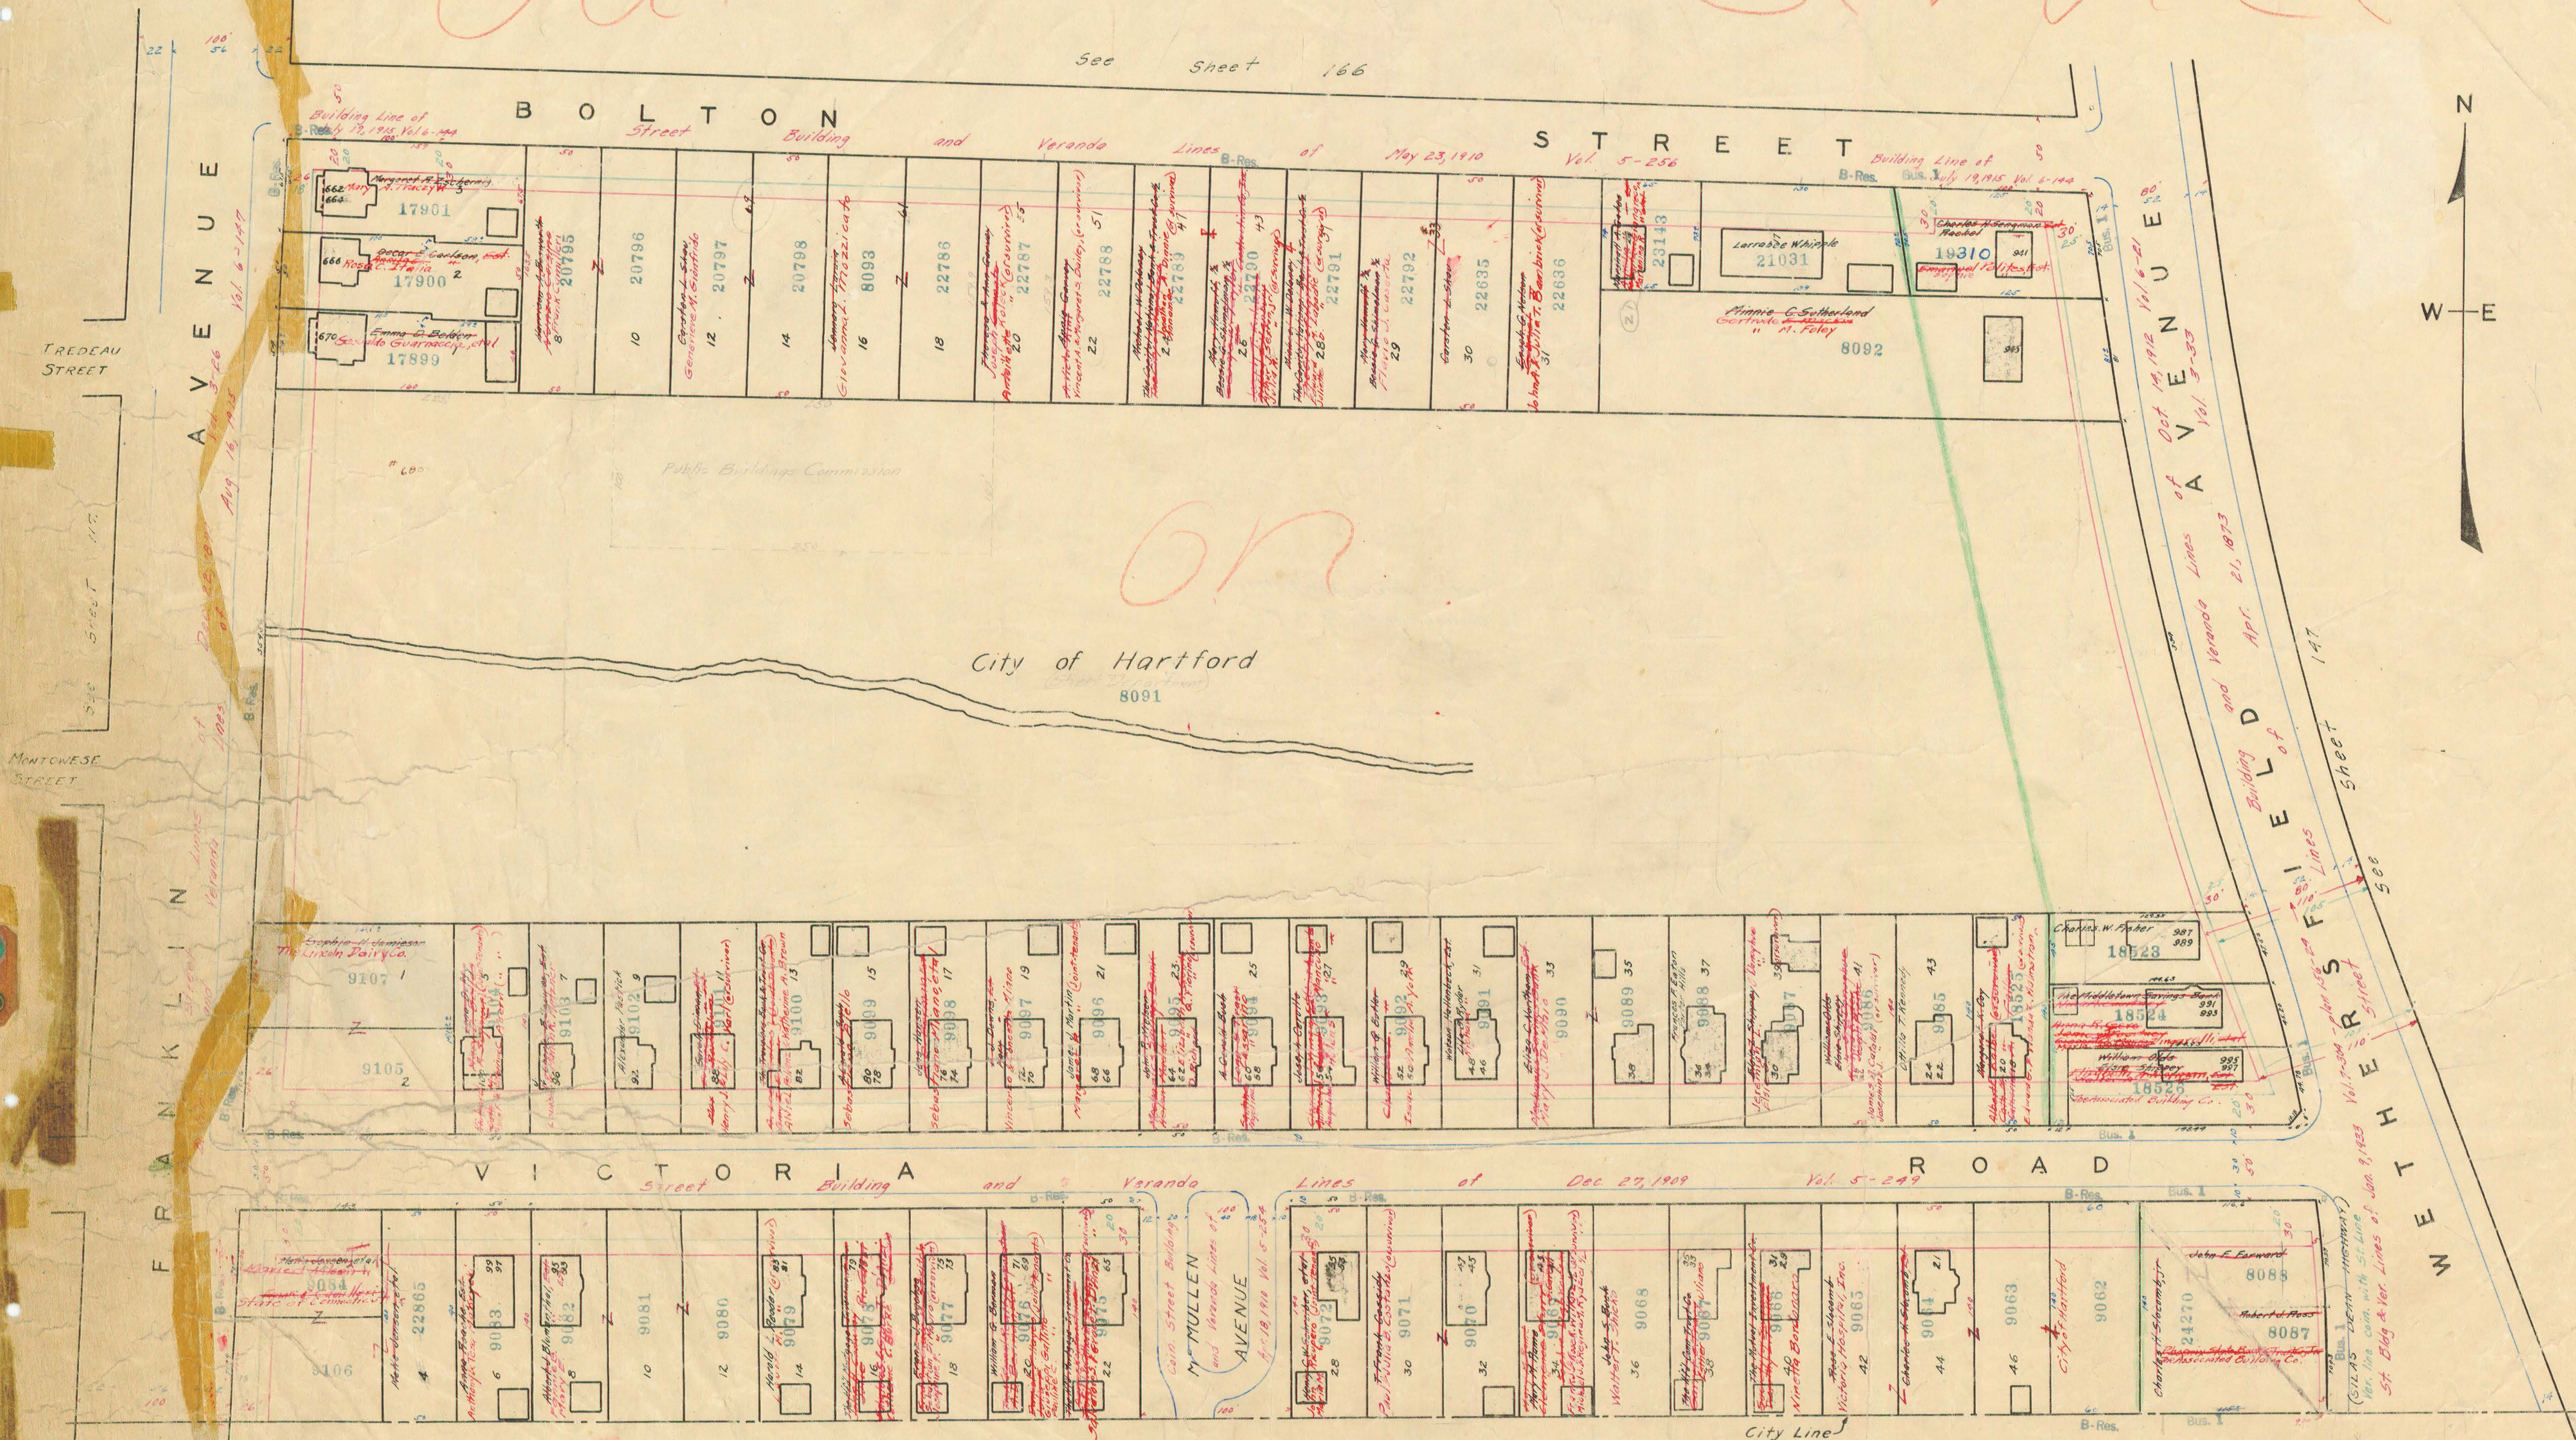

T O W N

O F

W E T H E R S F I E L D

March 10, 1954