


Out of service

Dec. 28-1937

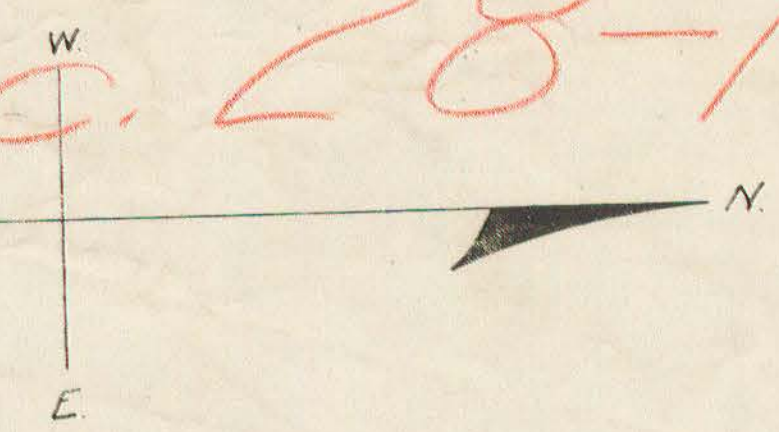

See Sheet 221

Out of service, Dec. 28-1937

Out of service Dec 28-1937

STREET

11010  
City of Hartford  
KENY PARK

11011

KENY PARK

WESTLAND

EASTFORD STREET

HARPER STREET

SLOVE

W A V E R L Y STREET

HARPER ST.

KENY PARK

Out of service, Dec. 28-1937