


Portland Street.
 Showing Fence lines
 and Present Curb.
 Scale 1"=40'

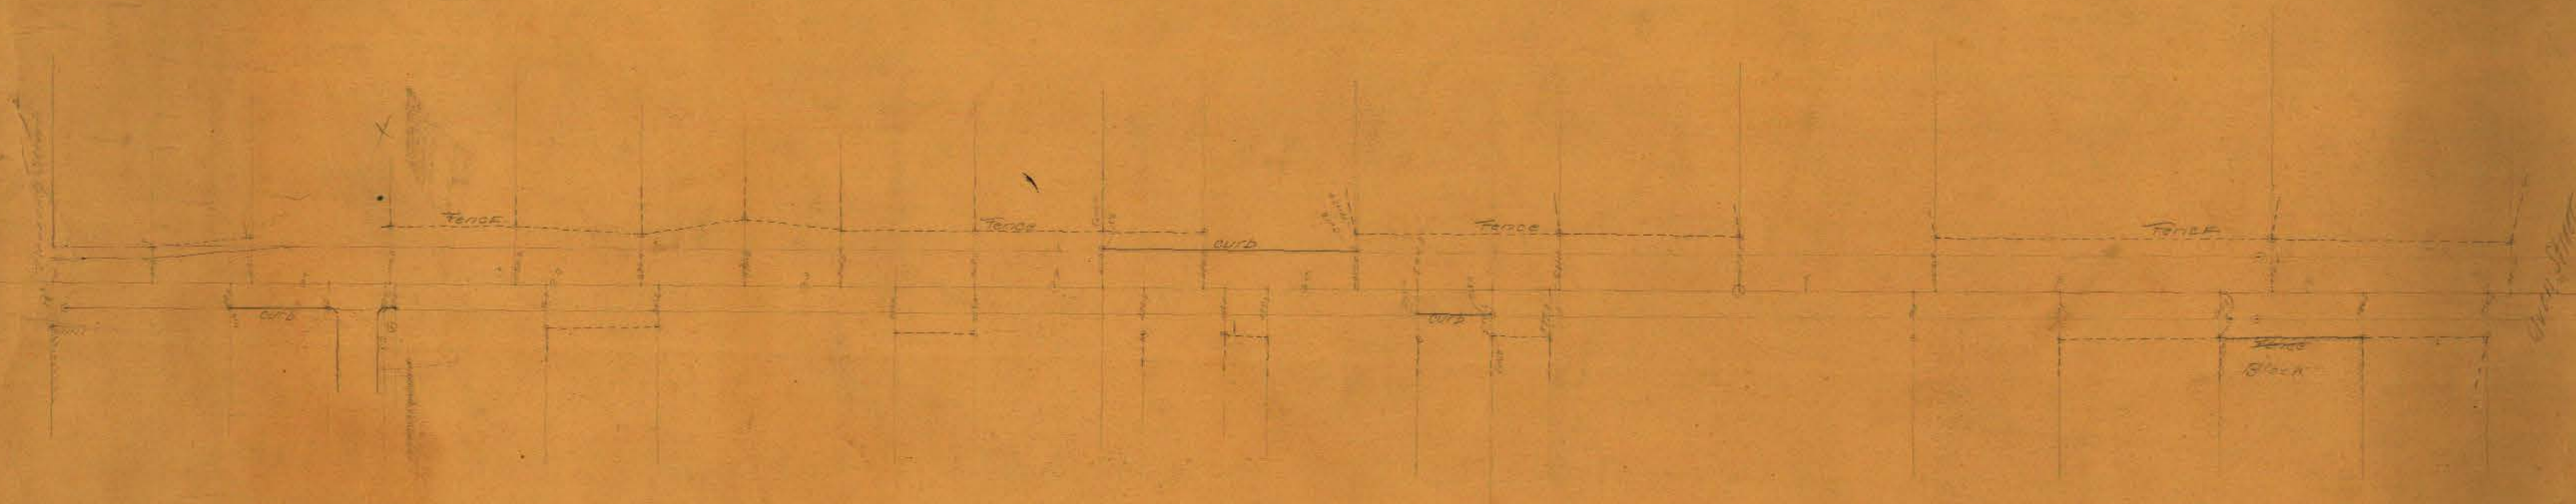

OFFICE OF CITY ENGINEER
 HARTFORD, CONN.
 Date Oct. '05 Day Eq. 17 01735
 Notes 230
81
 City _____